
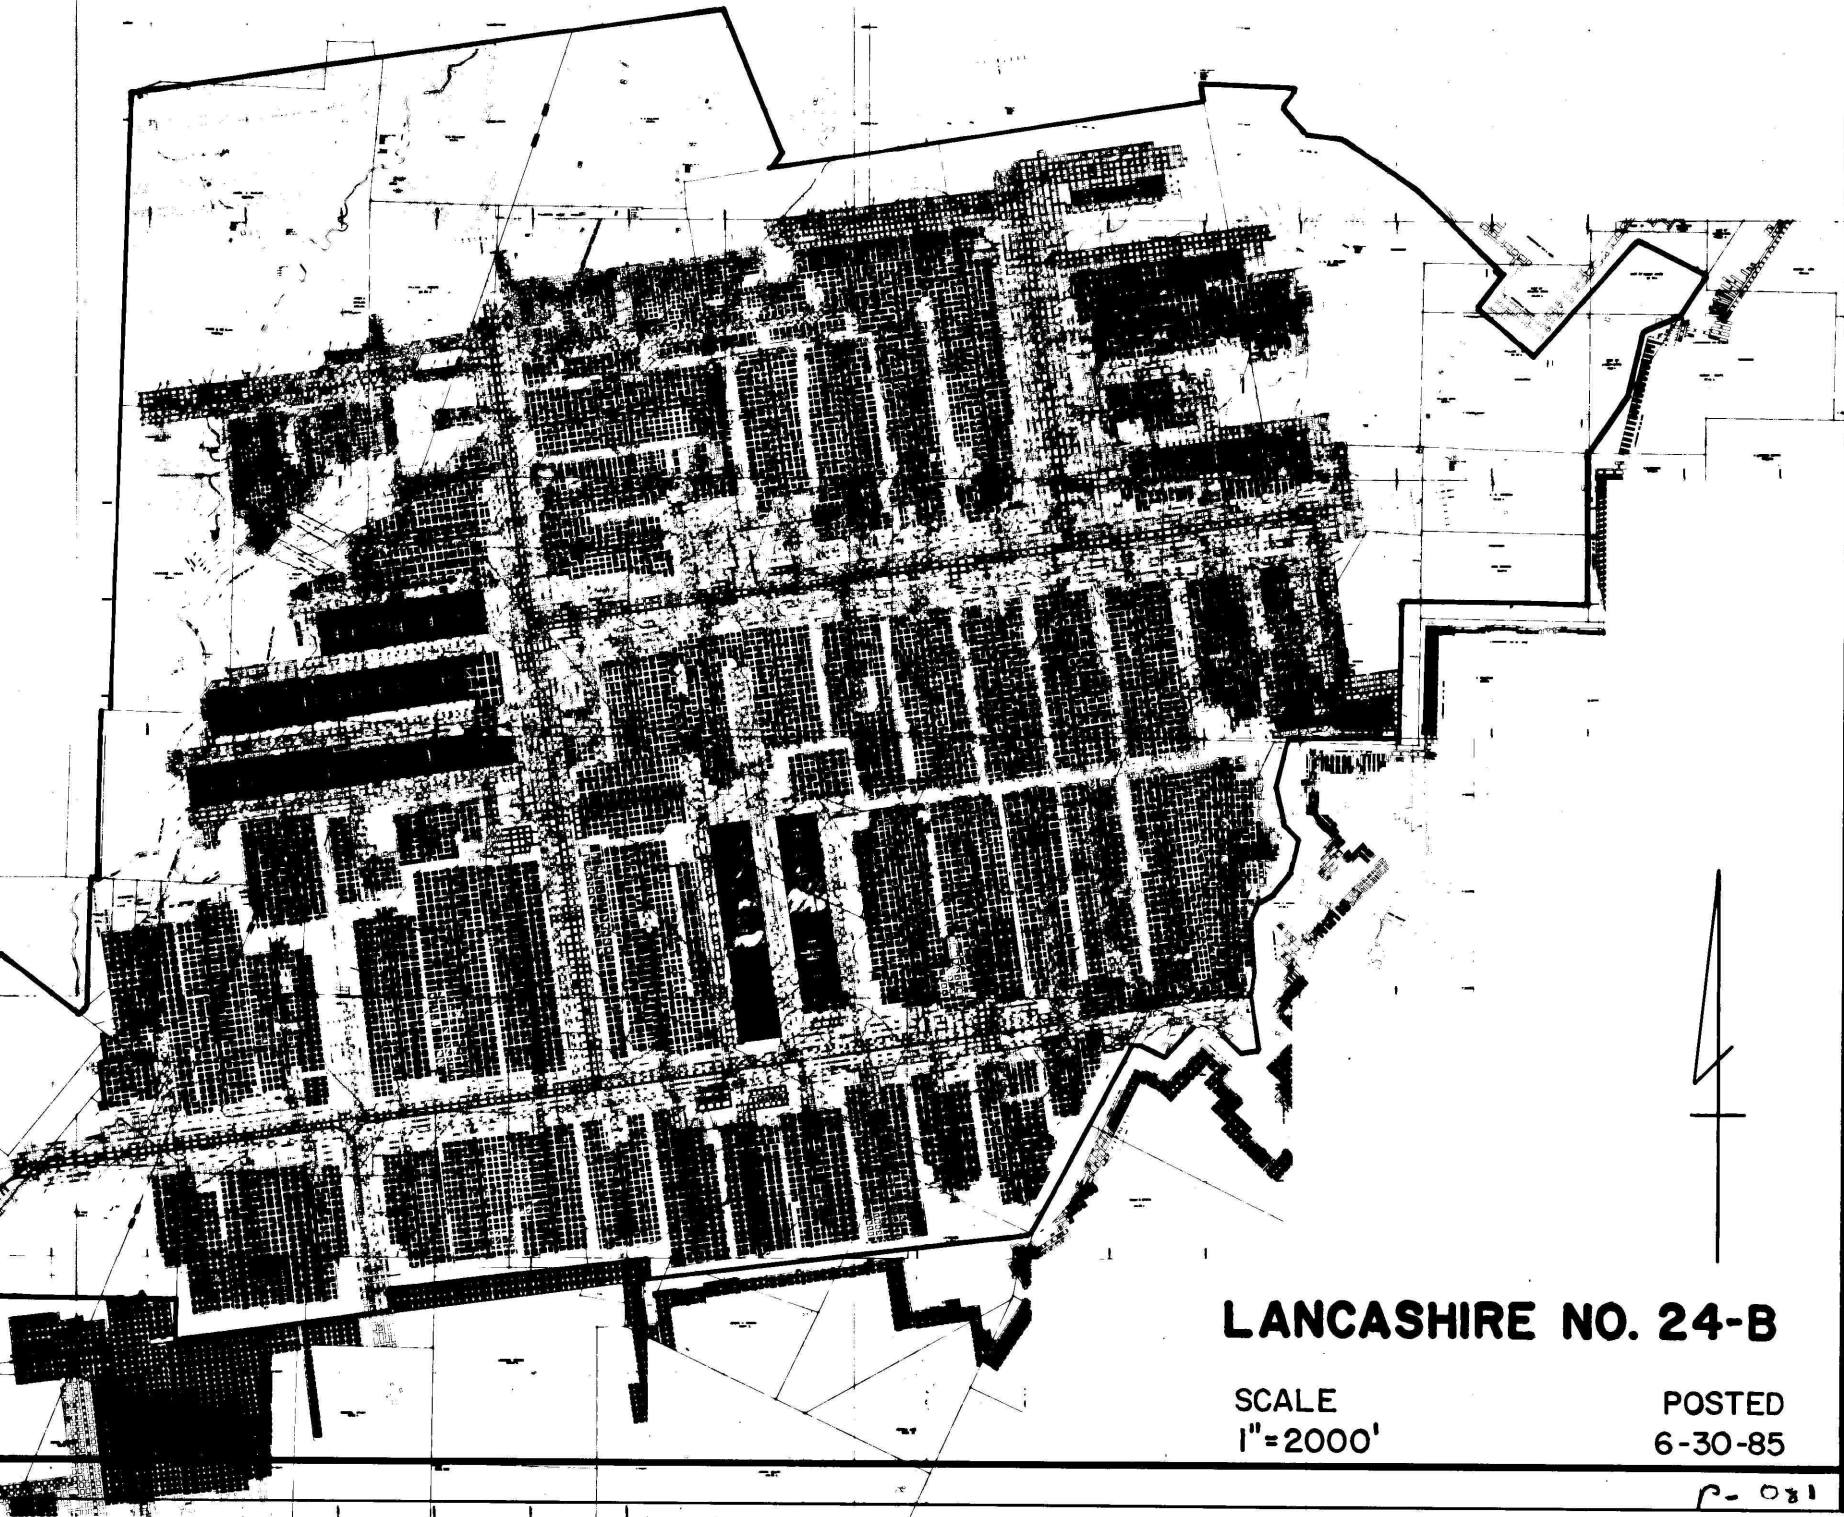


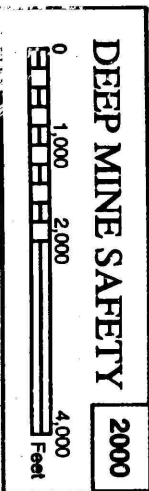

**LANCASHIRE NO. 24-B**

SCALE  
1"=2000'

POSTED  
6-30-85

P-081