


LEGEND

LANCASHIRE NO. 24B SEAM
A - 26" HDG. & ROOMS
POSTS NOT DRAWN TO SCALE
SCALE: 1"=50'
WORKINGS AS OF 4-16-1969

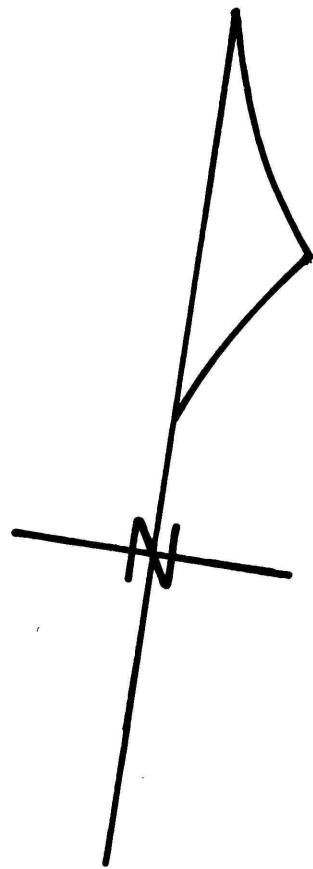

"A-24" R-2 RIB LINE

NO. 10 ROOM

NO. 9 ROOM

CAVED

NO. 8 ROOM

CAVED

NO. 7 ROOM

NO. 6 ROOM

NO. 5 ROOM

L-2

L-1

BELT

R-1

R-2

POSTS

CANVAS ON POSTS

JUNCTION BOX TO COL. MOLE

POWER SUPPLY

BRATTICE

AIR FLOW

BUGGY

RUN WAYS

WATER HOLE

CANVAS

CANVAS

CANVAS

CANVAS

CANVAS

CAVED

CANVAS

CANVAS

CANVAS

JUNCTION BOX

RUN WAYS

PILLARS

PULLED

BELT

BRATTICE

L-2

L-1

BELT

R-1

R-2

POSTS

BRATTICE

"A-26" HDG.

