


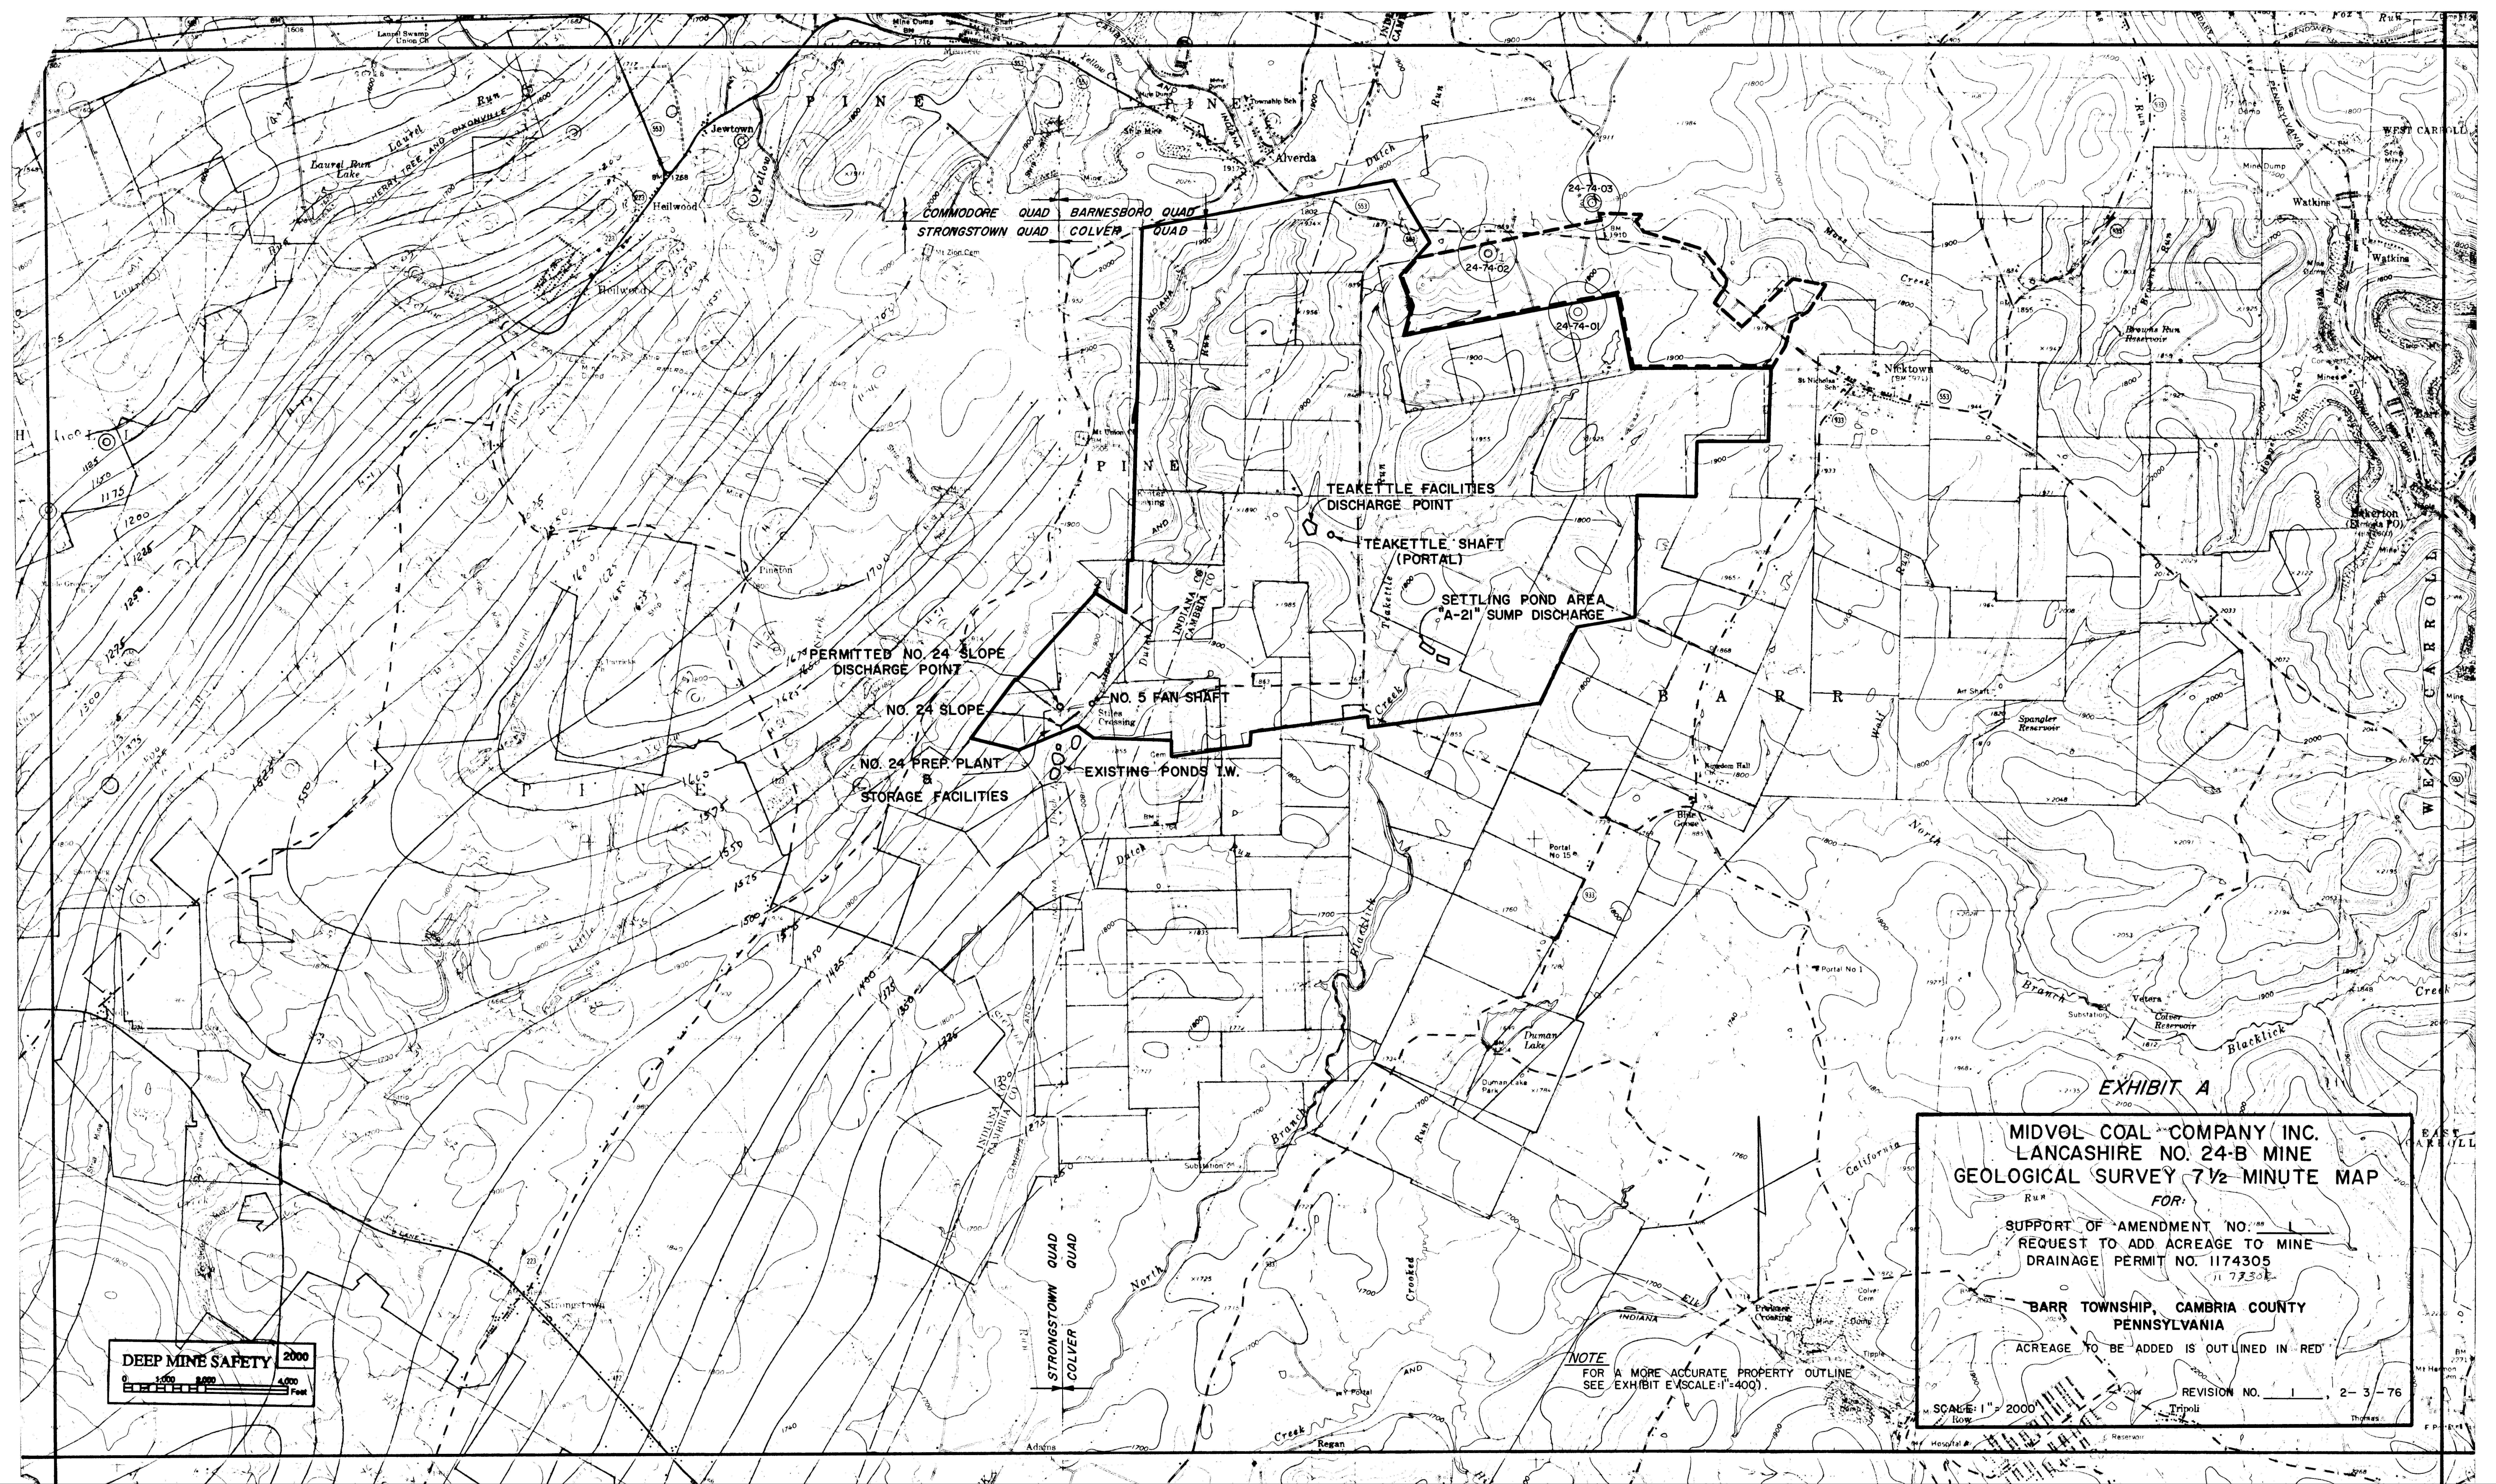

COMMODORE QUAD BARNESBORO QUAD  
STRONGSTOWN QUAD COLVER QUAD

TEAKETTLE FACILITIES  
DISCHARGE POINT

TEAKETTLE SHAFT  
(PORTAL)

SETTLING POND AREA  
"A-21" SUMP DISCHARGE

PERMITTED NO. 24 SLOPE  
DISCHARGE POINT

NO. 24 SLOPE

NO. 5 FAN SHAFT

NO. 24 PREP PLANT  
&  
STORAGE FACILITIES

EXISTING PONDS I.W.

EXHIBIT A

MIDVOT COAL COMPANY INC.  
LANCASHIRE NO. 24-B MINE  
GEOLOGICAL SURVEY 7 1/2 MINUTE MAP  
FOR:

SUPPORT OF AMENDMENT NO. 1  
REQUEST TO ADD ACREAGE TO MINE  
DRAINAGE PERMIT NO. 1174305  
11 72305

BARR TOWNSHIP, CAMBRIA COUNTY  
PENNSYLVANIA

ACREAGE TO BE ADDED IS OUTLINED IN RED

REVISION NO. 1 2-3-76

SCALE: 1" = 2000'  
Row

NOTE  
FOR A MORE ACCURATE PROPERTY OUTLINE  
SEE EXHIBIT E (SCALE: 1" = 400')

DEEP MINE SAFETY 2000  
0 1000 2000 4000  
Feet