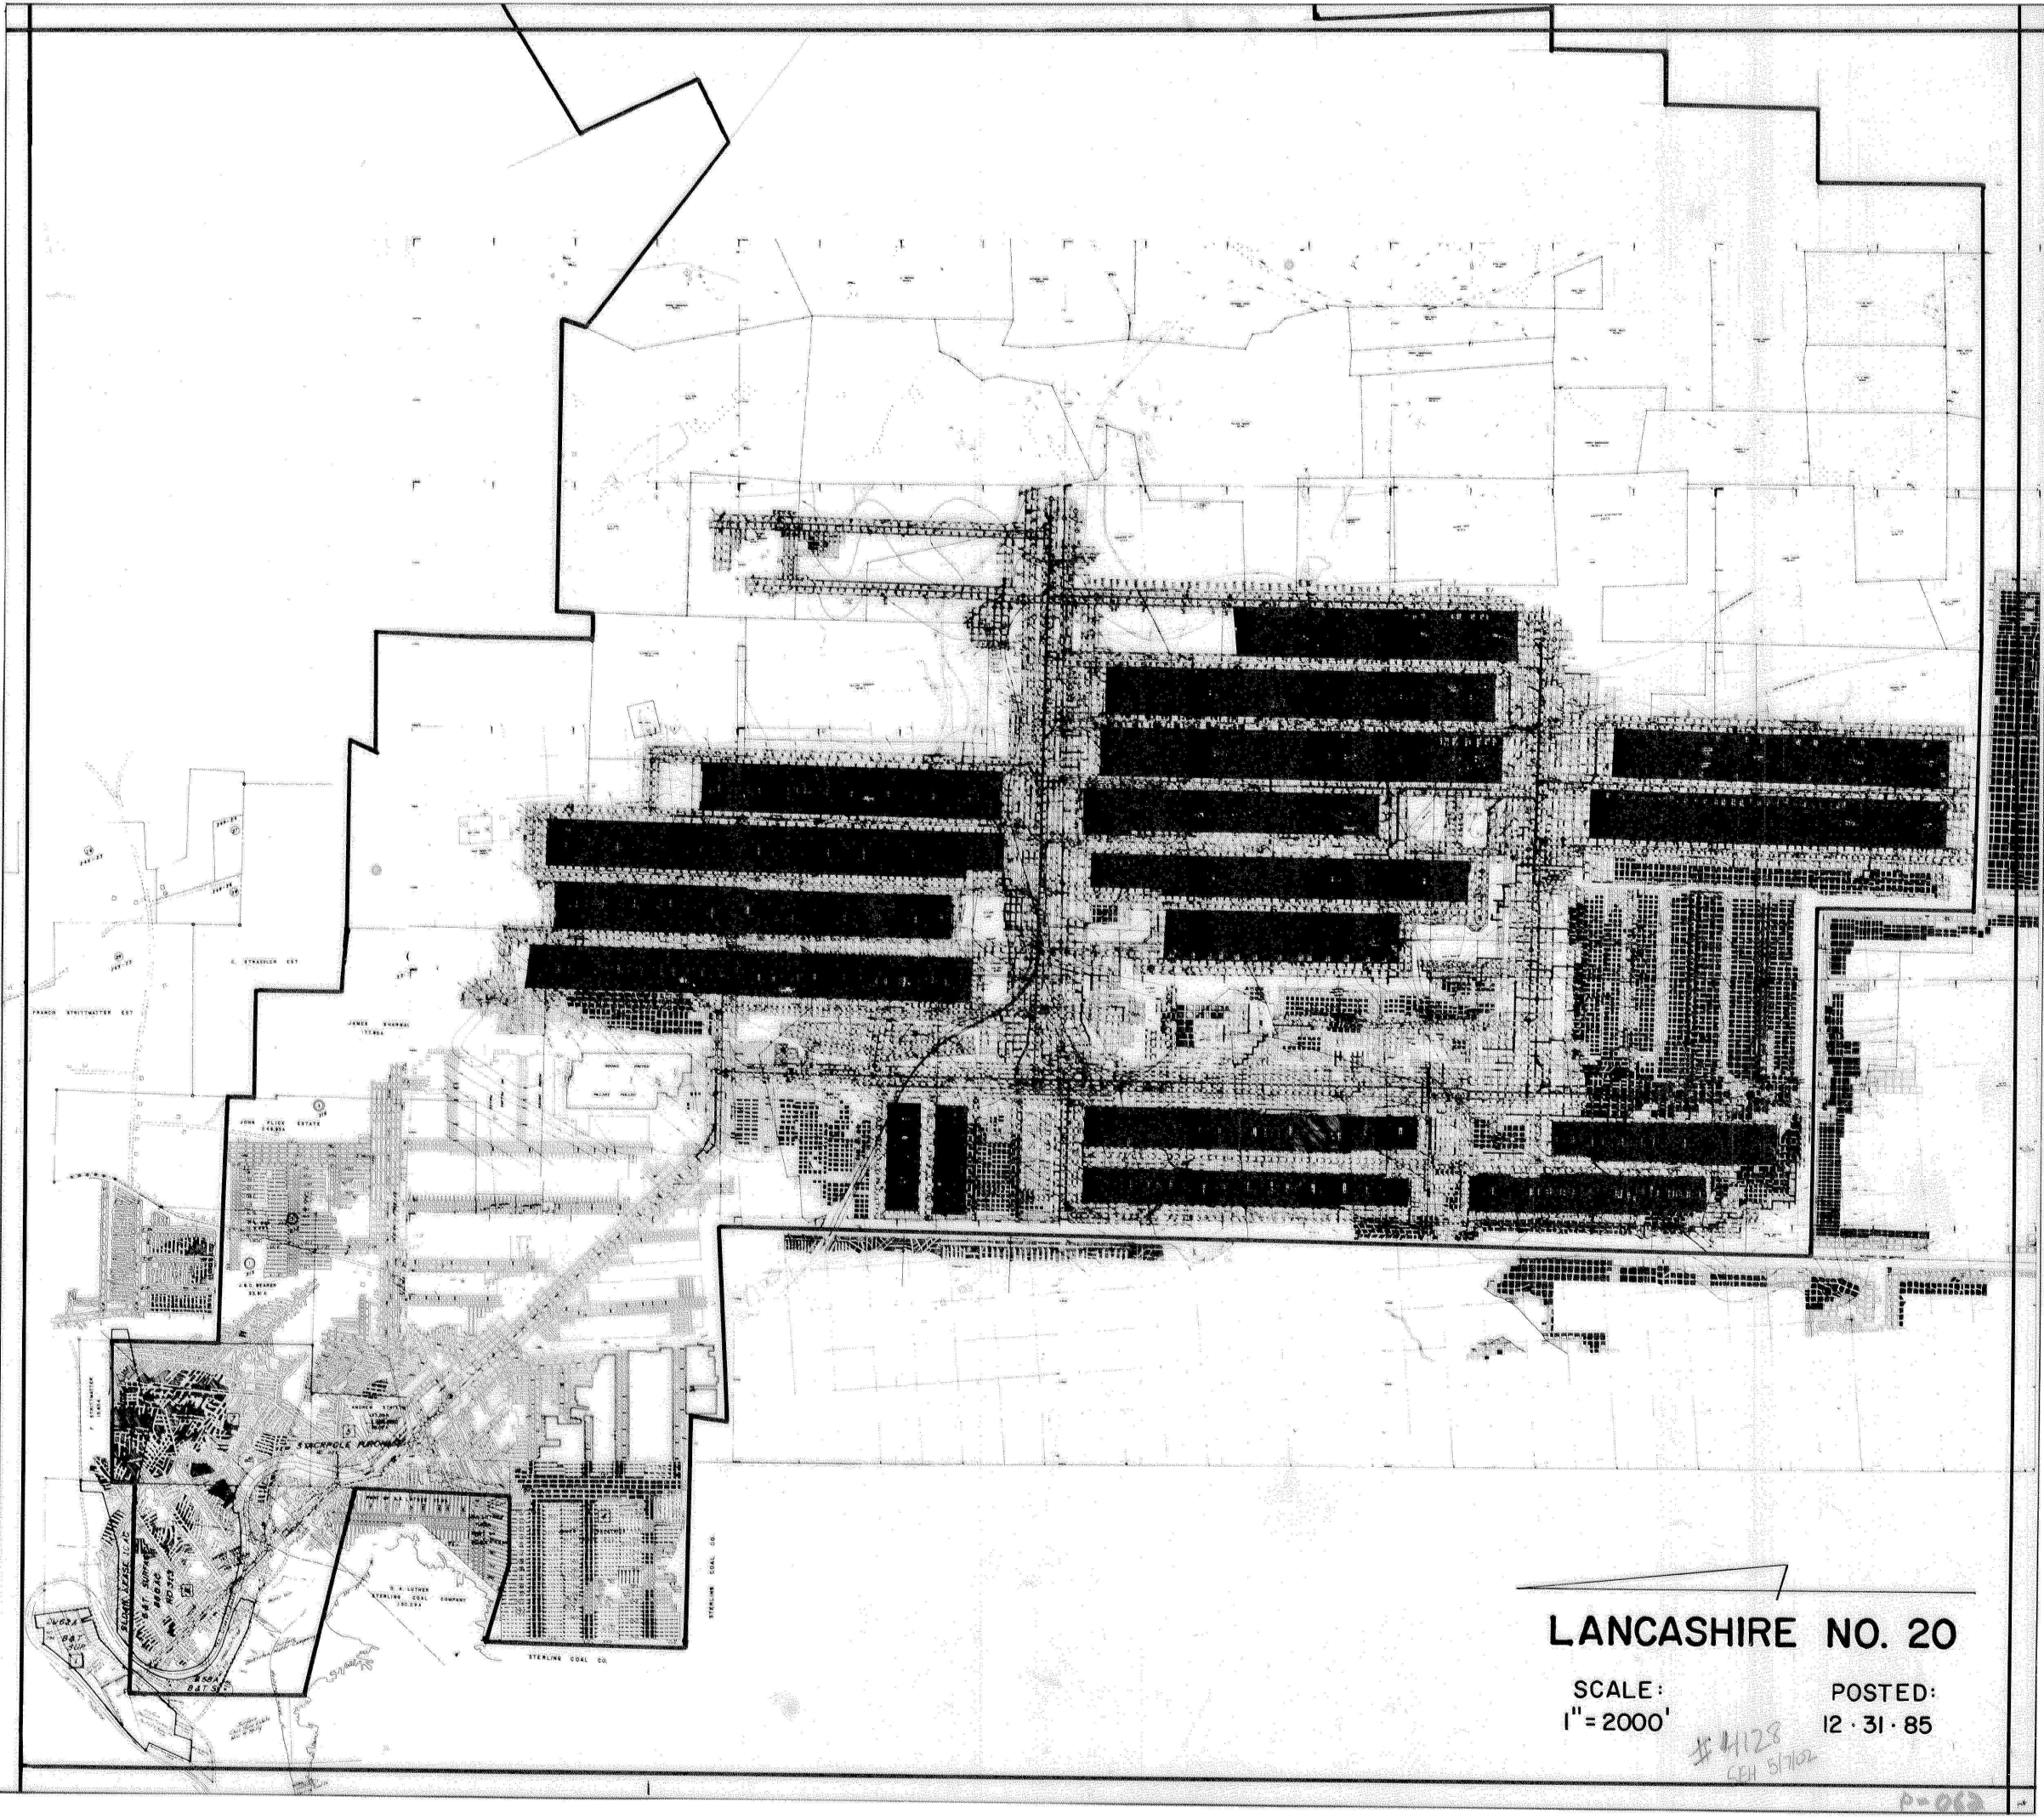
G. STRASSLER EST
FRANCIS STREITWATTER EST
JOHN FLICK ESTATE
STERLING COAL CO.
STERLING COAL COMPANY
LANCASHIRE NO. 20
SCALE:
1" = 2000'
POSTED:
12 · 31 · 85