


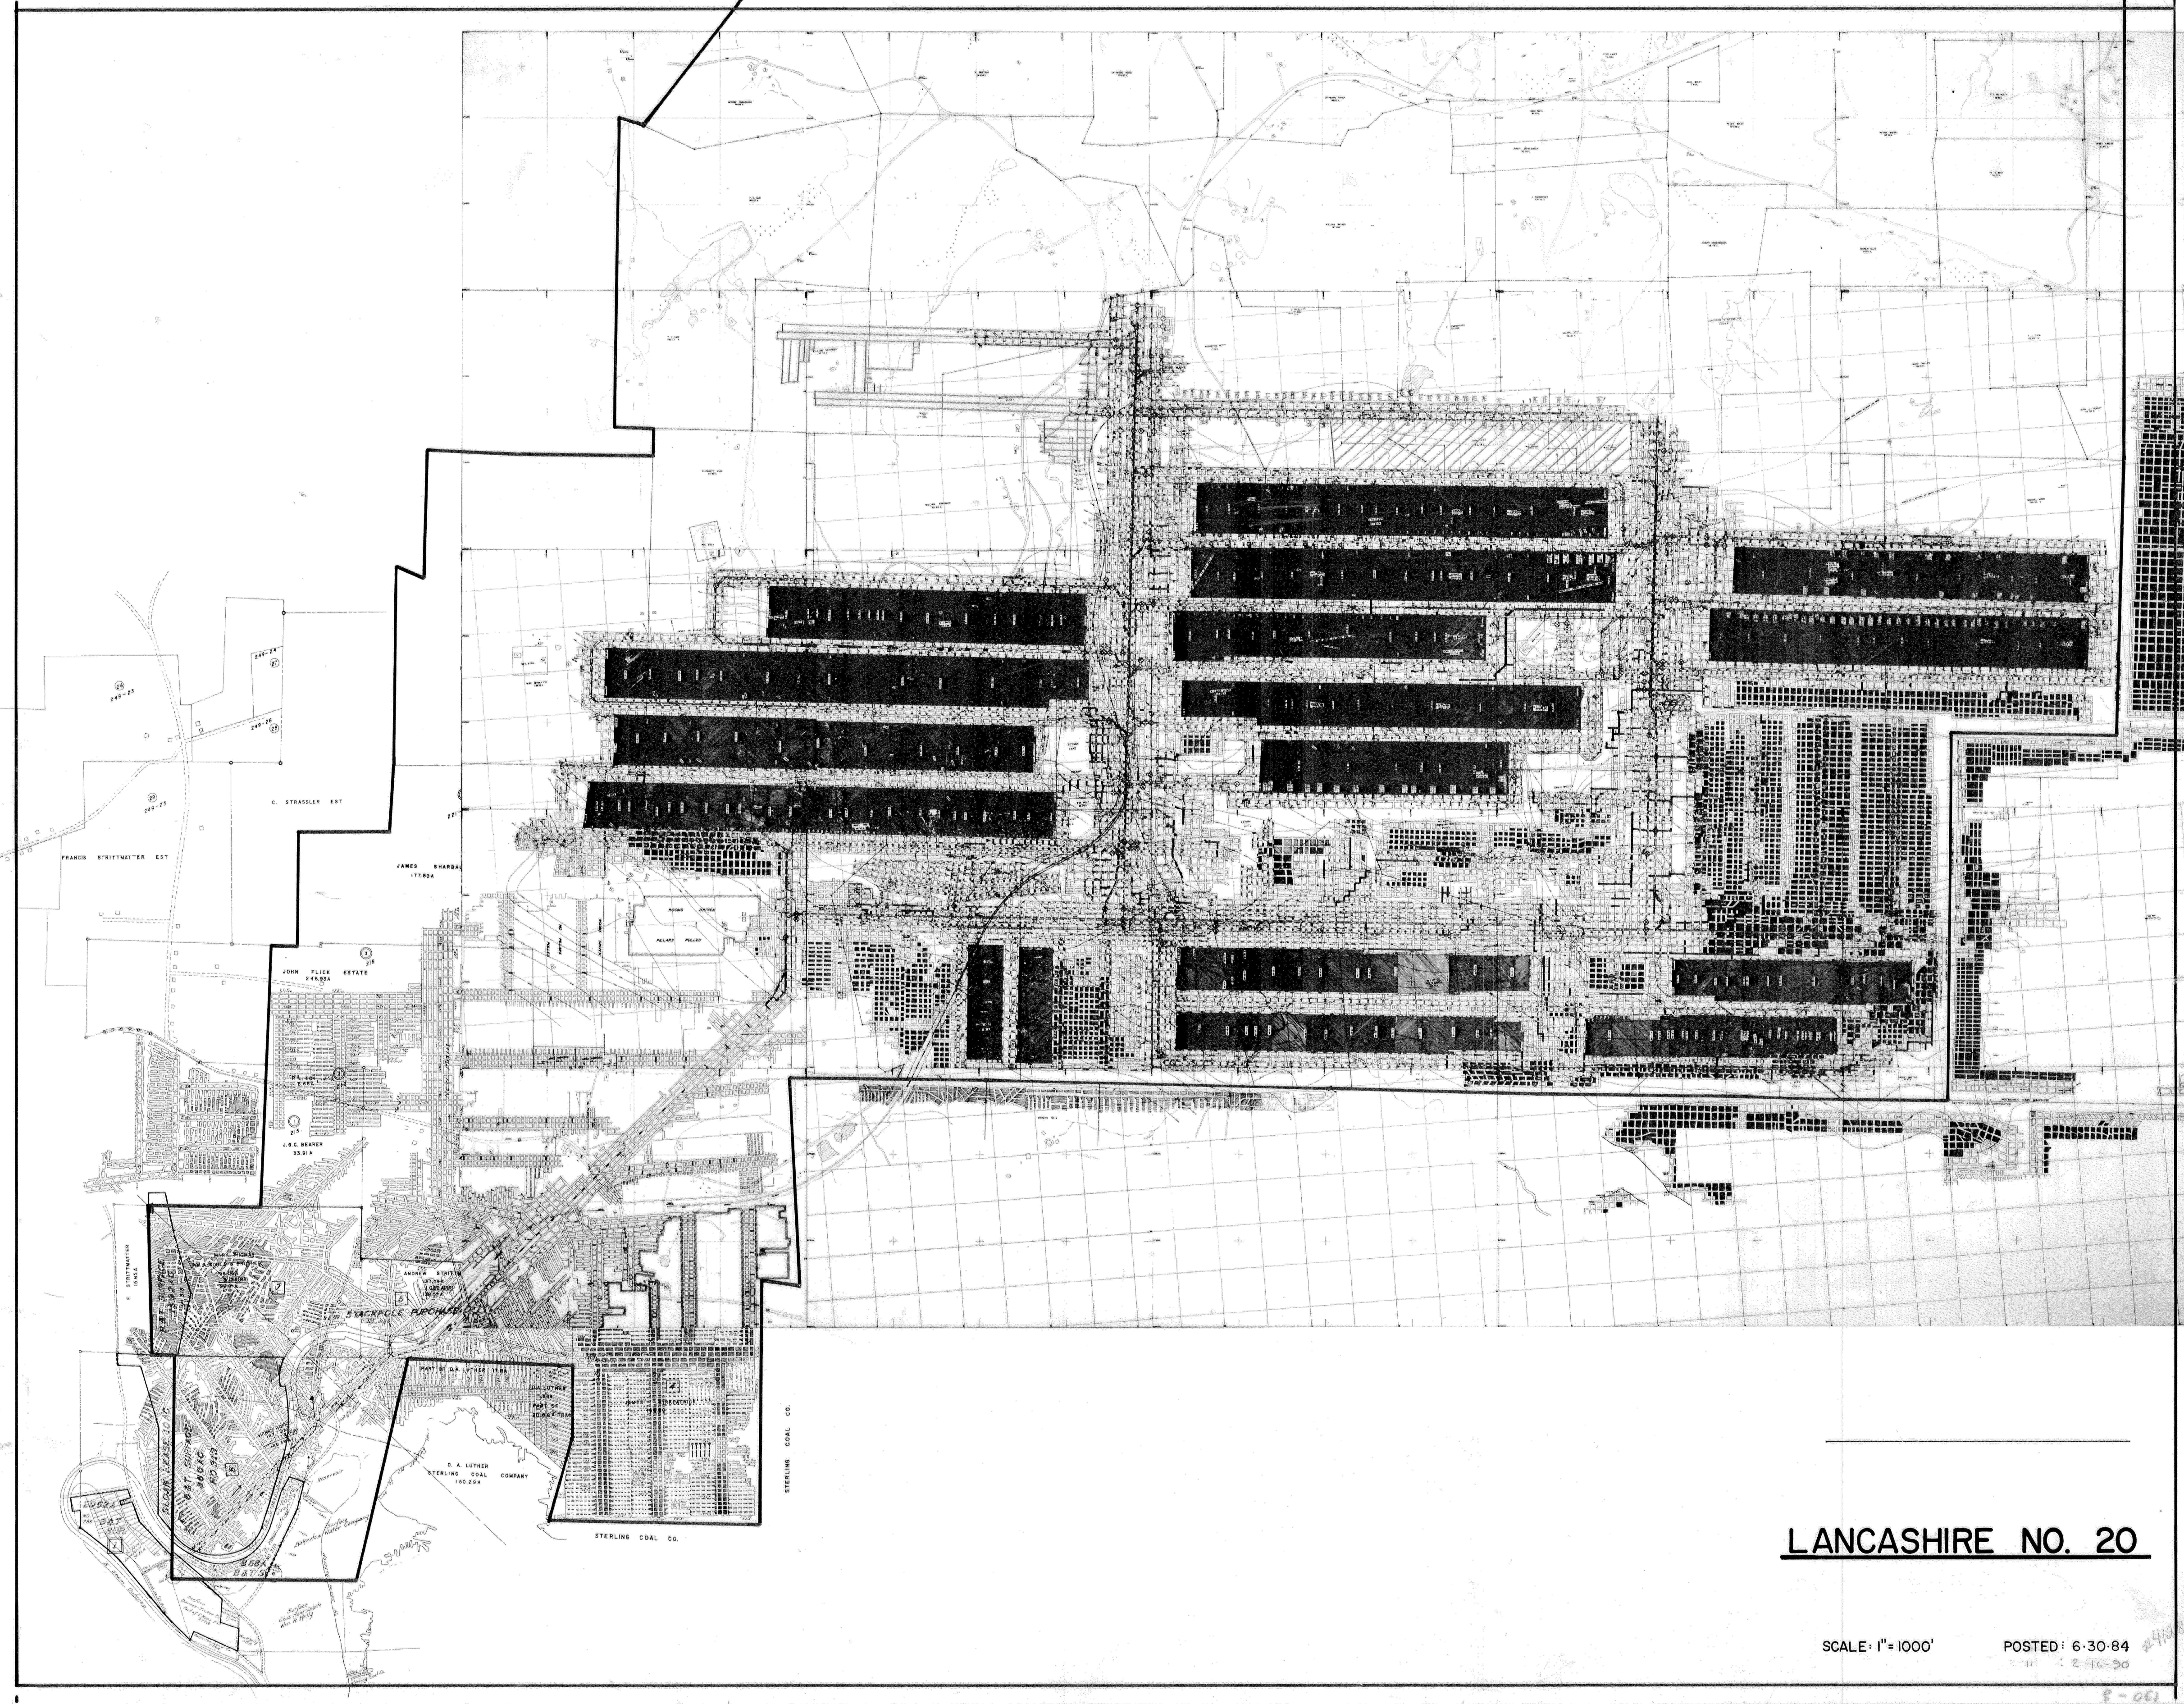

LANCASHIRE NO. 20

SCALE: 1" = 1000' POSTED: 6-30-84