


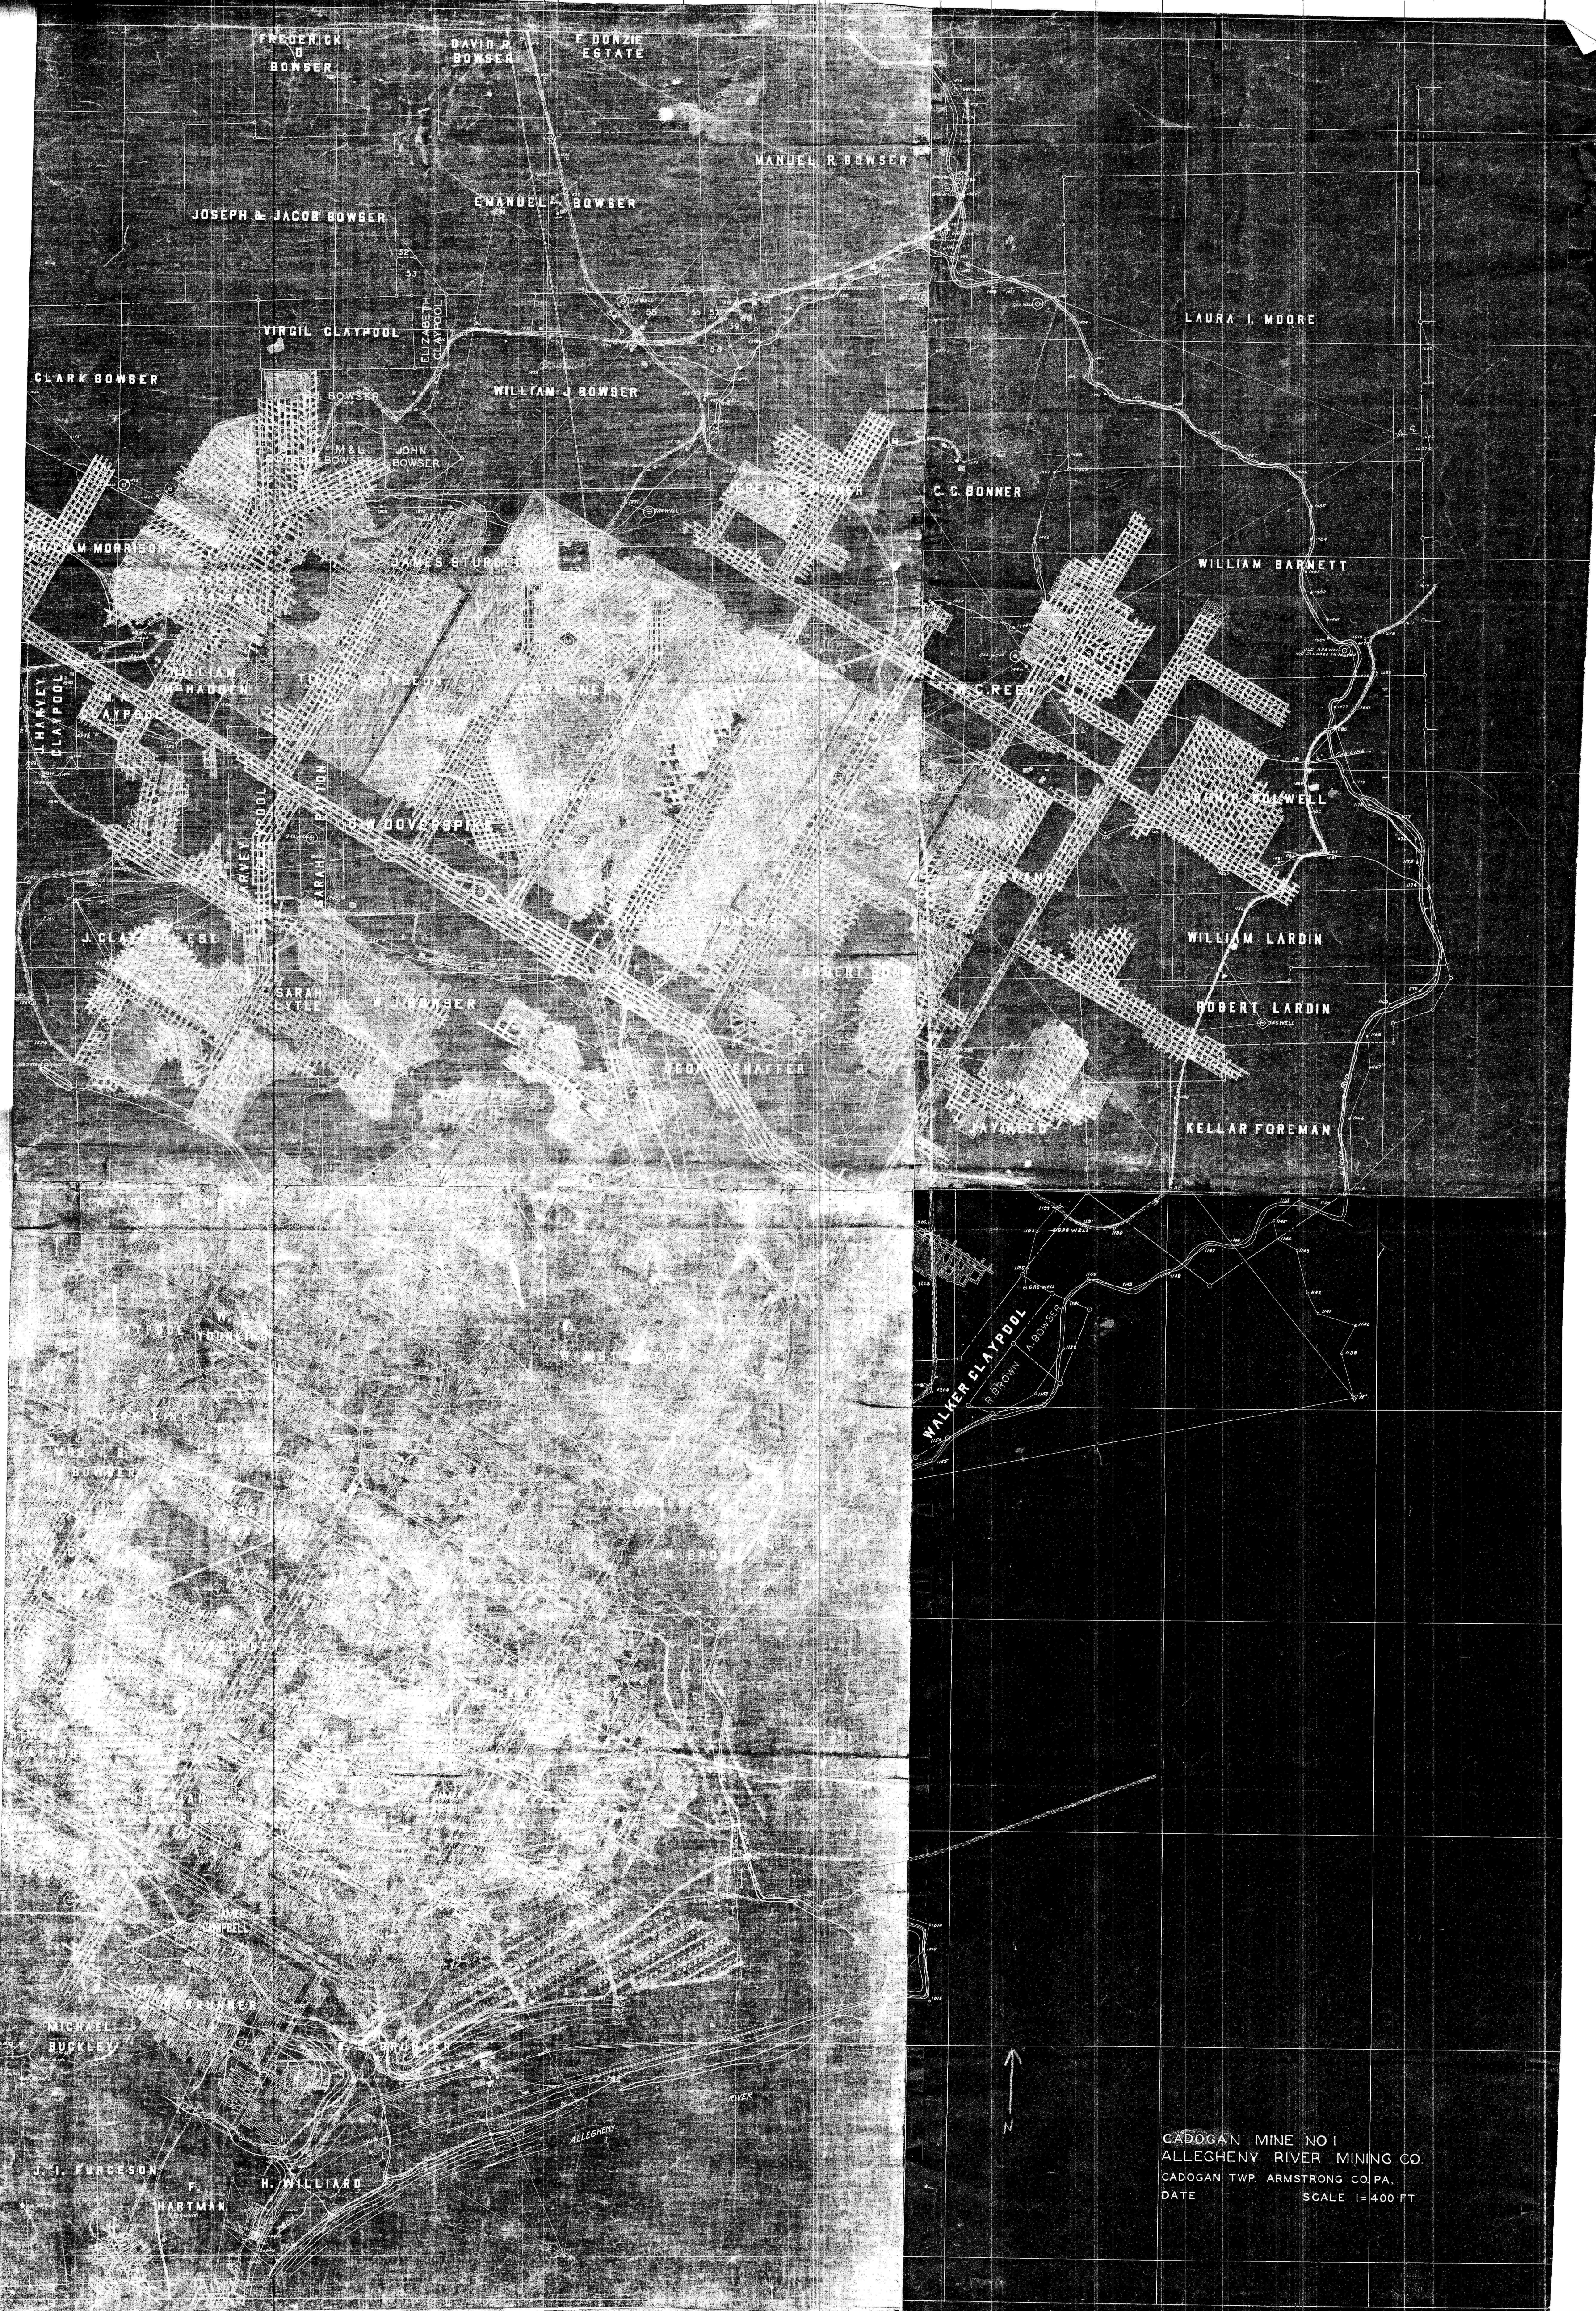

CADOGAN MINE NO 1
ALLEGHENY RIVER MINING CO.
CADOGAN TWP. ARMSTRONG CO. PA.
DATE SCALE 1=400 FT.