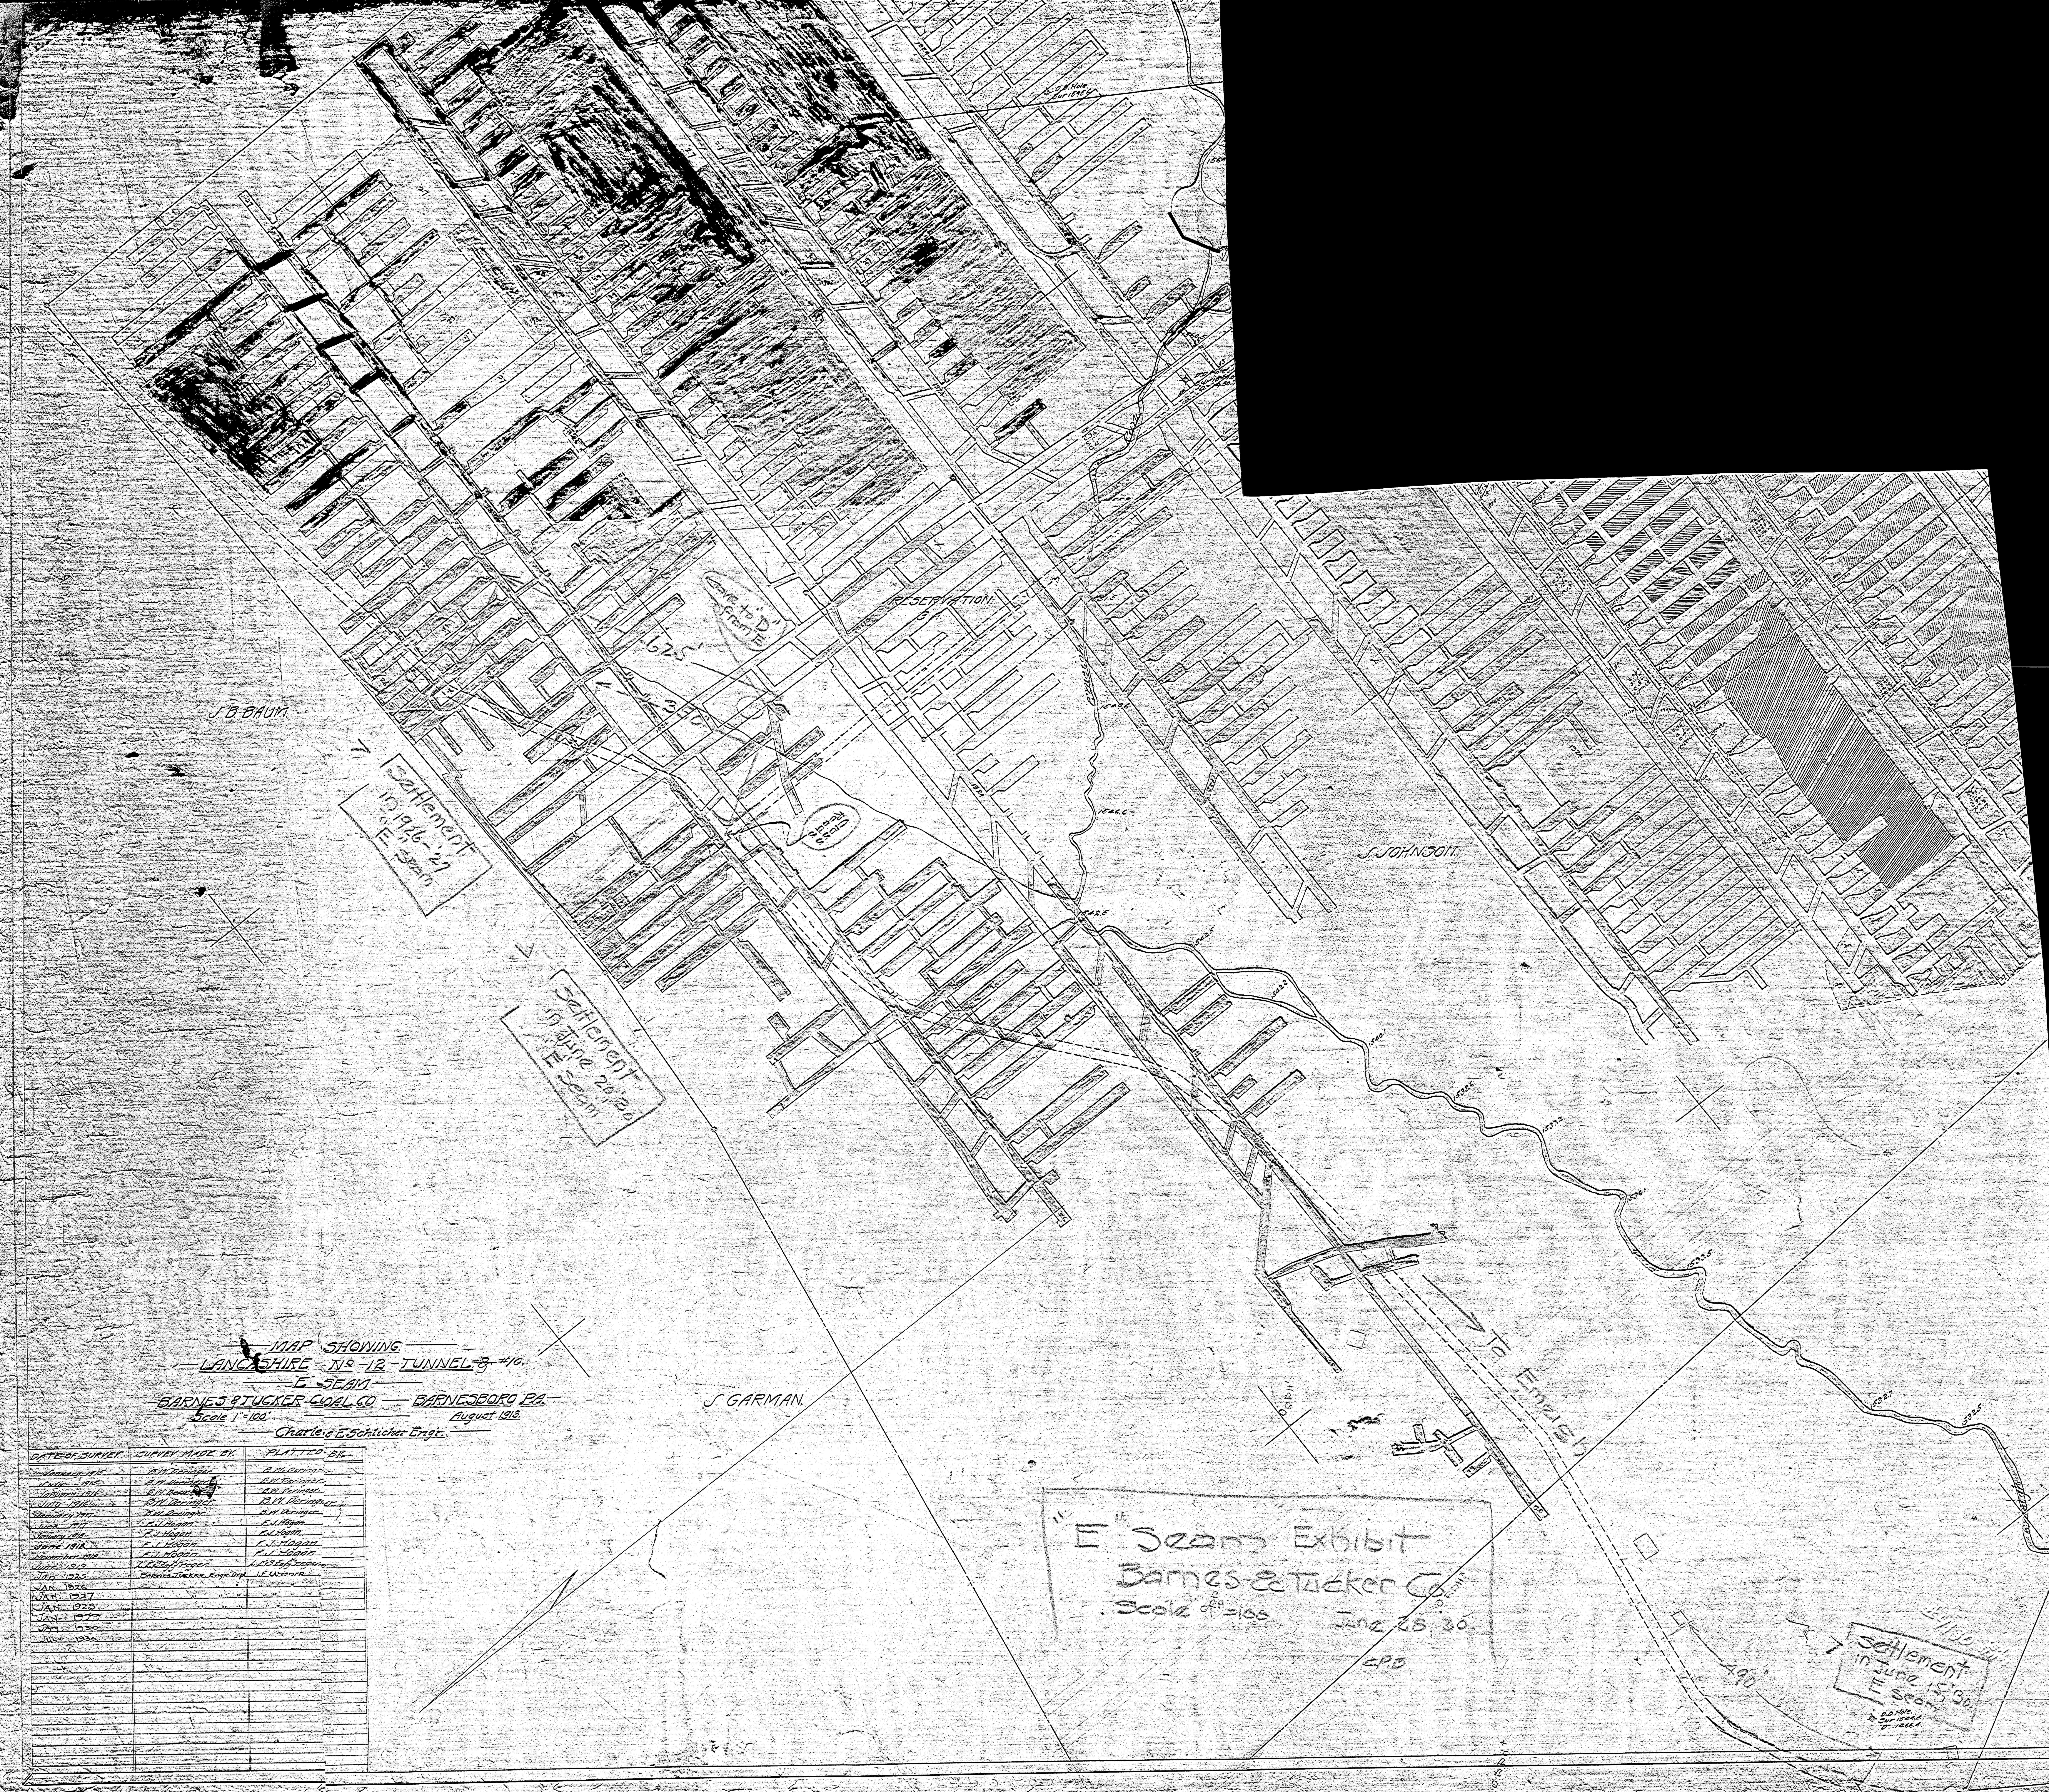
S.B. BAUM
S. GARMAN
S. JOHNSON
RESERVATION
1924
Settlement in 1926-27 "E" Seam
Settlement in June 20 '30 "E" Seam
Cave to "D" from "E"
625'
310'
Cross Roads
To Emeigh
"E" Seam Exhibit
Barnes & Tucker Co.
Scale 1" = 100
June 28 30
C.P.B.
Settlement in June 15 '30 E Seam
490'
D.D. Hole. Sur 1544.4 "D" 1466.4.
1532.7
1532.5
Emeigh
D-A-40

MAP SHOWING
LANCASHIRE - No - 12 - TUNNEL & #10.
"E" SEAM
BARNES & TUCKER COAL CO — BARNESBORO PA.
Scale 1" = 100' August 1913.
Charles E. Schlicher Engr.

DATE OF SURVEY	SURVEY MADE BY	PLATTED BY
January 1915	B.W. Deringer	B.W. Deringer
July 1915	B.W. Deringer	B.W. Deringer
January 1916	B.W. Deringer	B.W. Deringer
July 1916	B.W. Deringer	B.W. Deringer
January 1917	B.W. Deringer	B.W. Deringer
June 1917	F.J. Hogan	F.J. Hogan
January 1918	F.J. Hogan	F.J. Hogan
June 1918	F.J. Hogan	F.J. Hogan
November 1918	F.J. Hogan	F.J. Hogan
June 1919	L.E. Stoffregen	L.E. Stoffregen
Jan 1925	Barnes-Tucker Engr. Dept.	J.F. Weaver
JAN 1926	" " "	" "
JAN 1927	" " "	" "
JAN 1928	" " "	" "
JAN 1929	" " "	" "
JAN 1930	" " "	" "
JULY 1930	" " "	" "