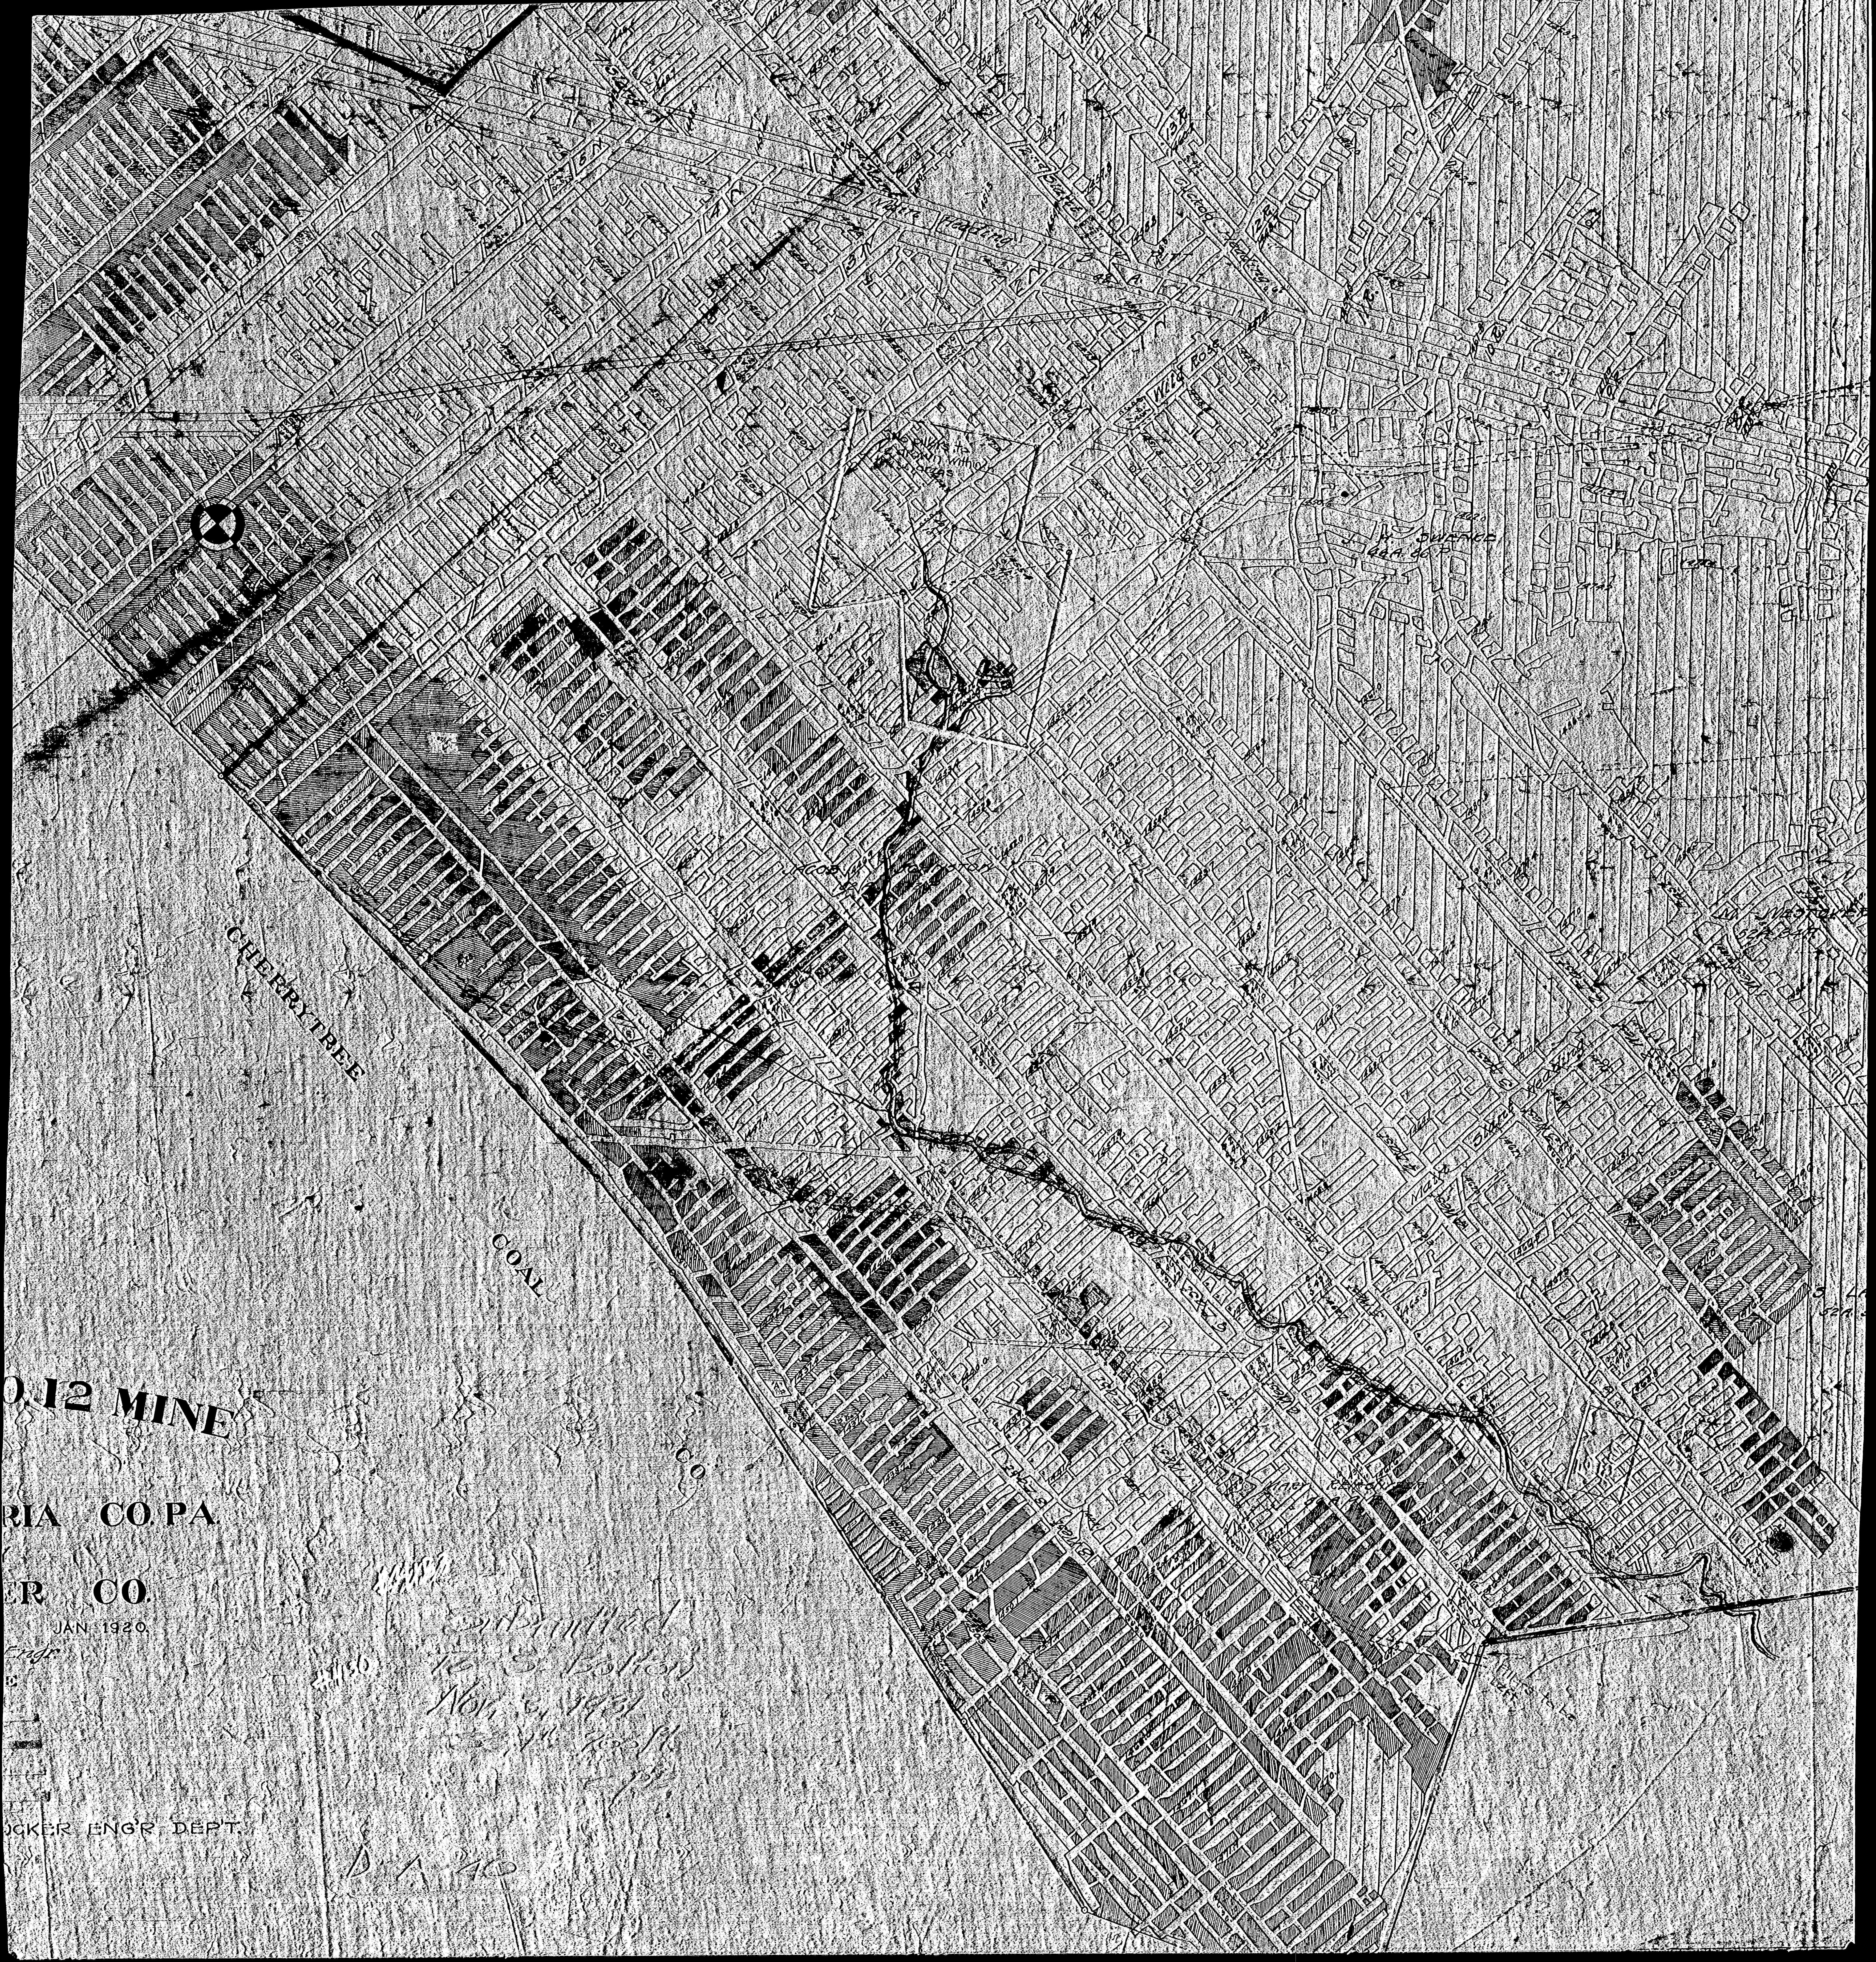

O.12 MINE

RIA CO.PA.

ER CO.

JAN 1920.

Engr.

CKER ENG'R DEPT.

#4130

[illegible]
to S. Bolton
Nov 6 1931
[illegible]

D 1 140