


COAL

16/ June - 16/30

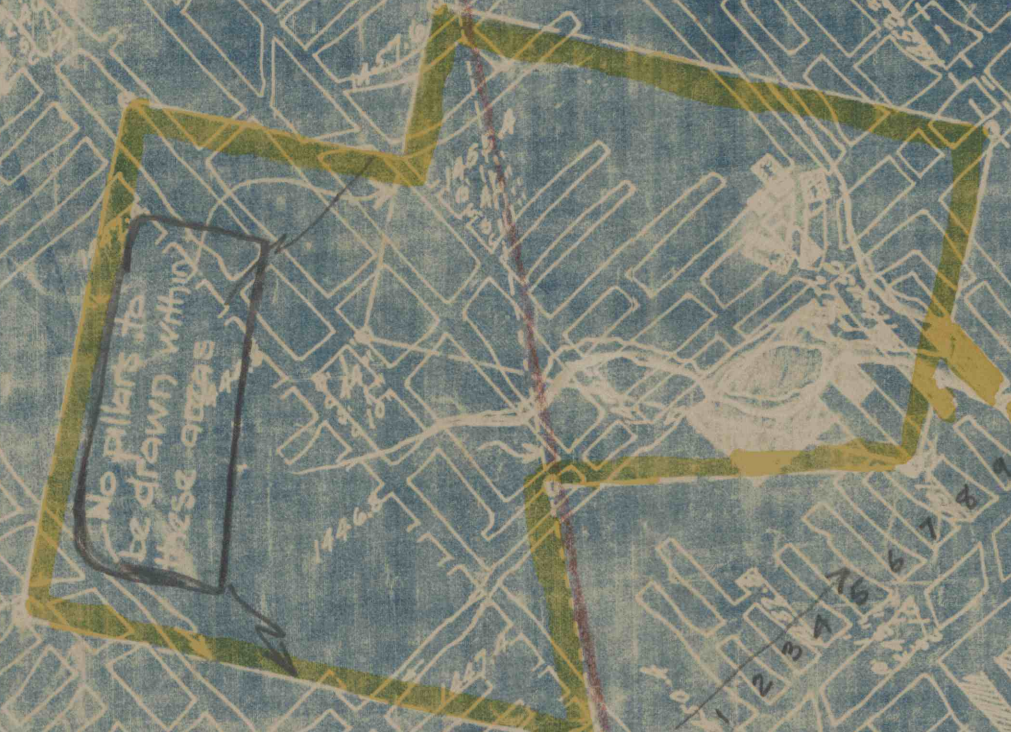

"D" Seam
Pillars to be Left
off Copy
May 21

COAL

CHERRY TREE

#4130
SEA 87/02

MINE