


MAP OF
COAL LANDS D SEAM
SHOWING
DELTA NO. 1 & VICTOR NO. 4 MINES
OWNED BY
THE BLUBAKER COAL CO
SCALE 1"=400'

F.A. & L.A. BYRNES

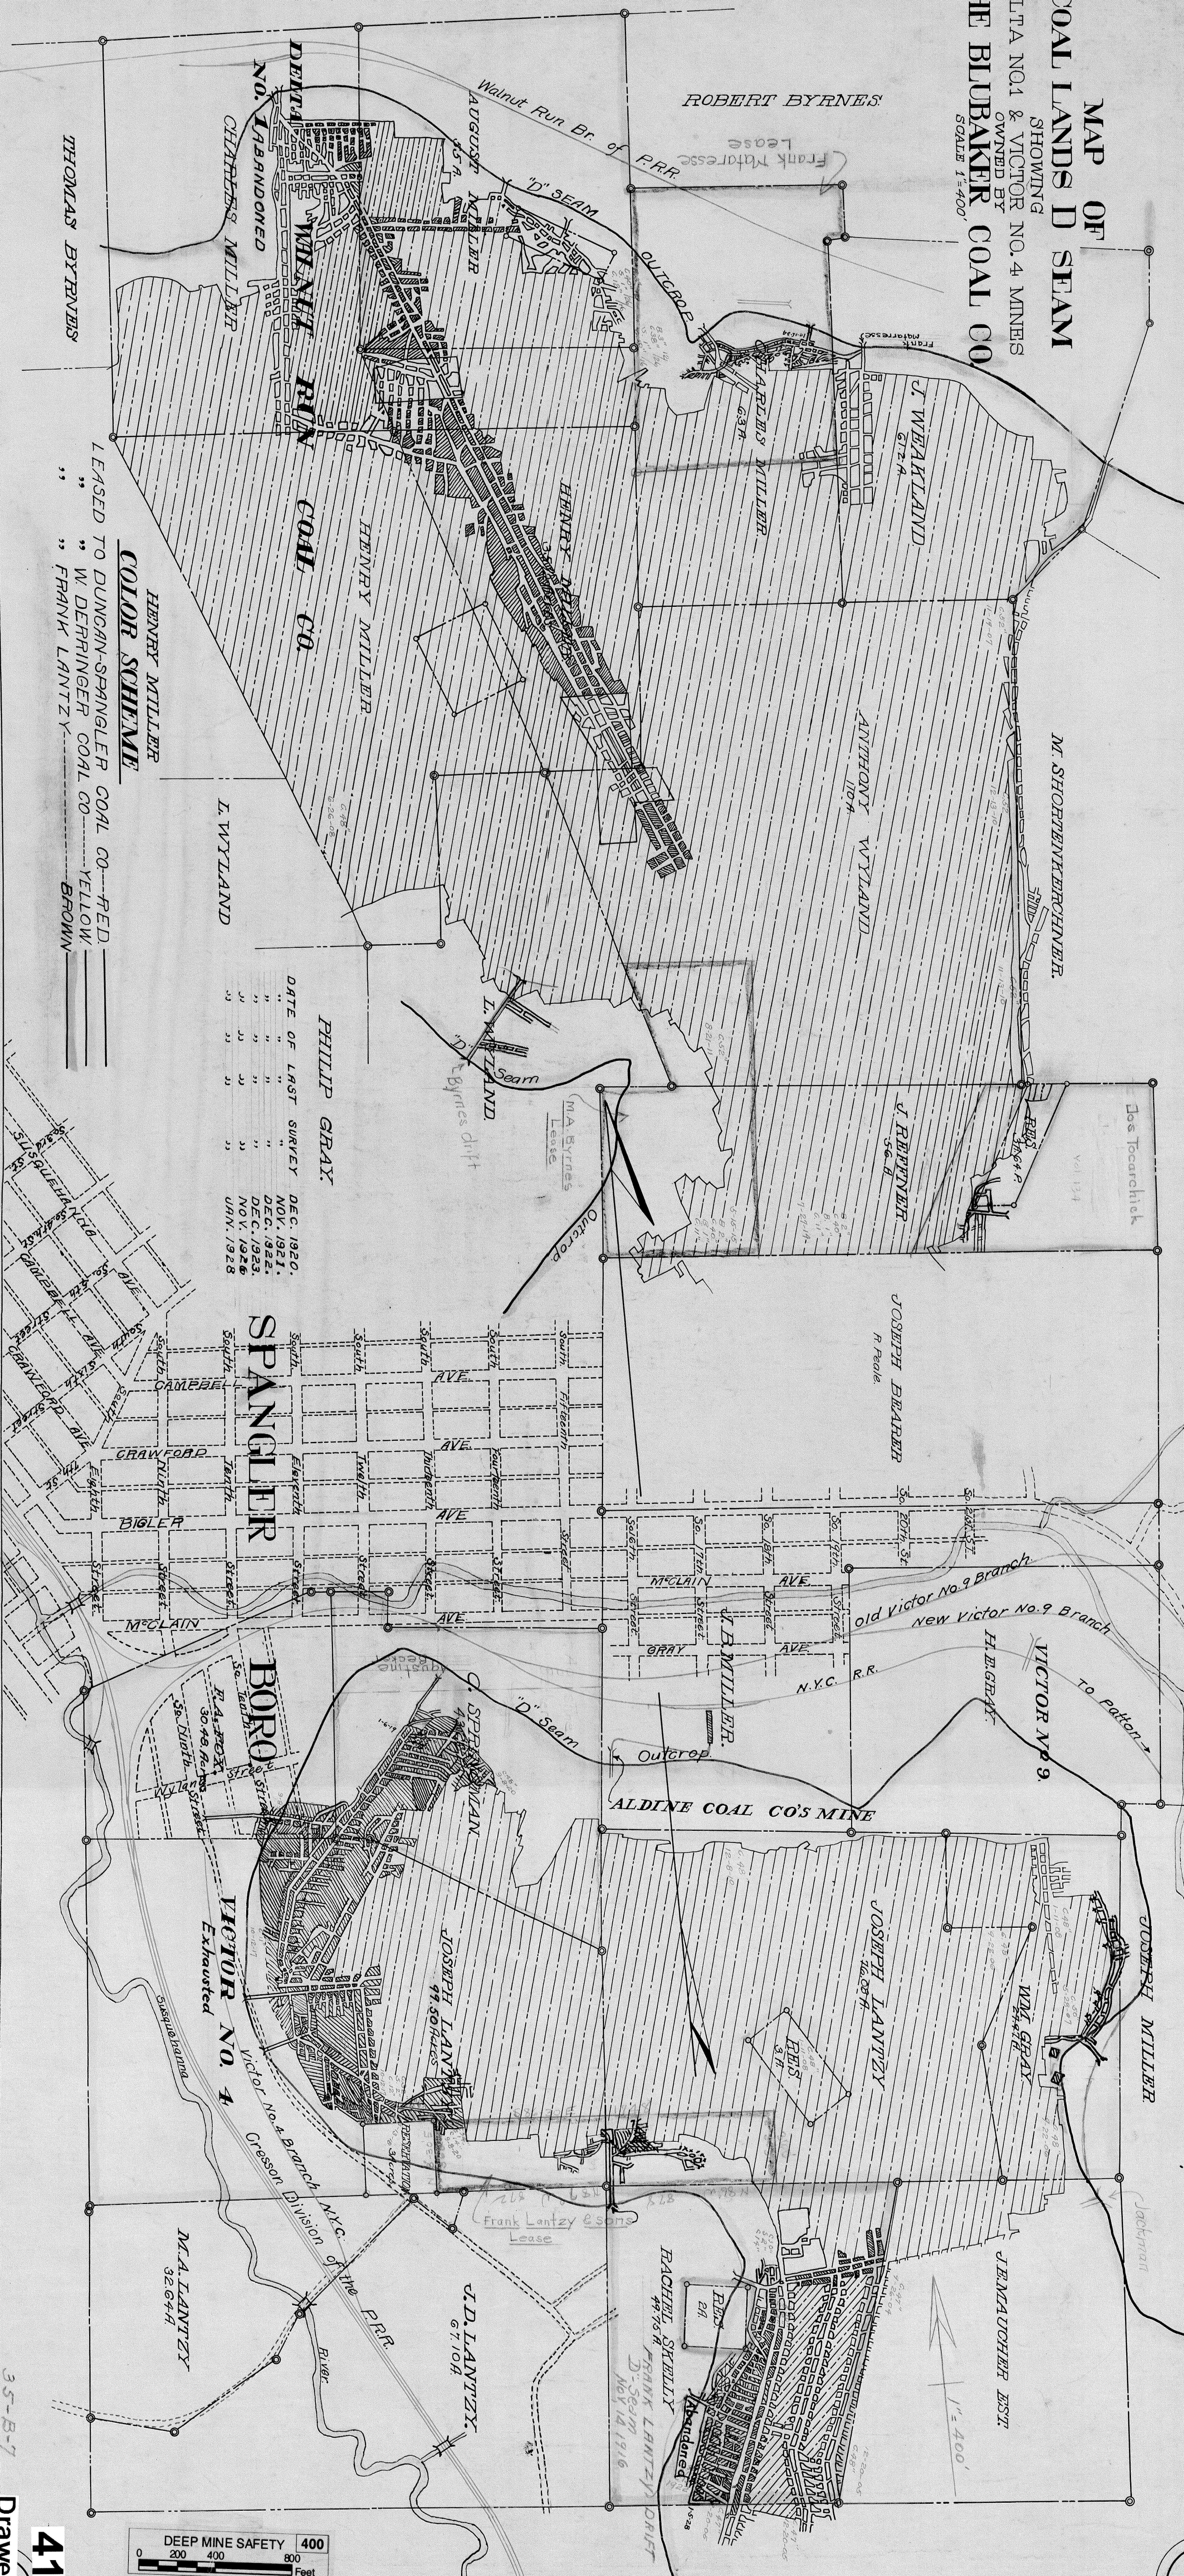

L. WYLAND

PHILIP GRAY	DATE OF LAST SURVEY	
"	DEC. 1920.	
"	NOV. 1921.	
"	DEC. 1922.	
"	DEC. 1923.	
"	NOV. 1926	
"	UNN. 1928	


SPANGLER

BORO

VICTOR NO. 4

Exhausted

M.A. LANTZY

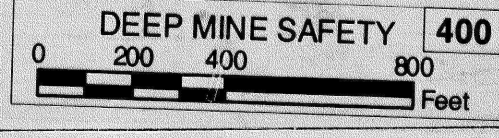

4141

Drawer C2

R-41013