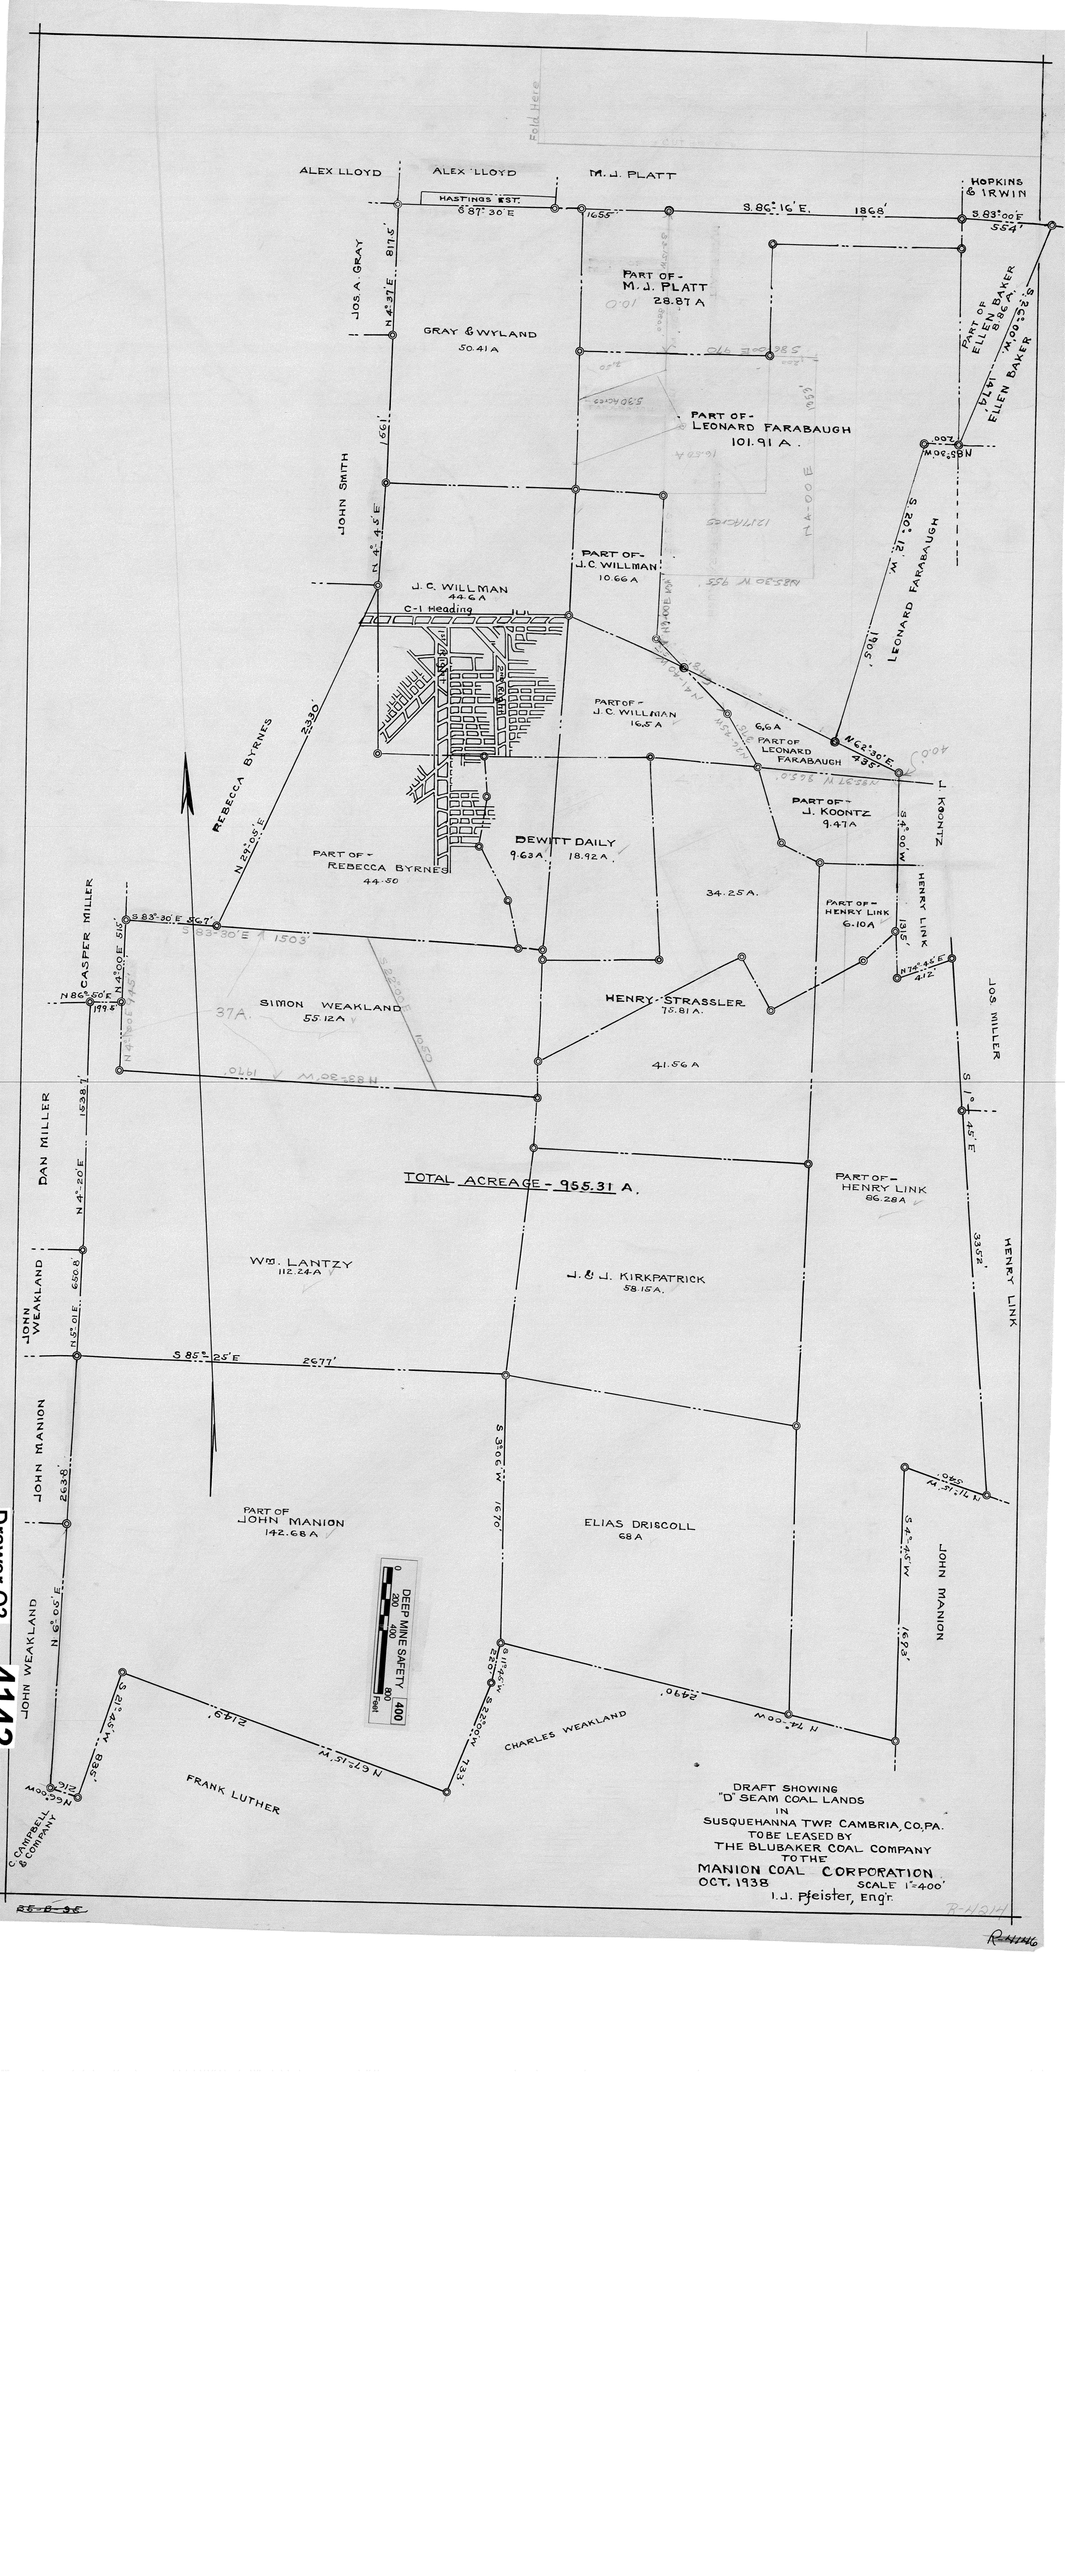

ALEX LLOYD
ALEX LLOYD
HASTINGS EST.
S87° 30' E
M.J. PLATT
Fold Here
HOPKINS & IRWIN
S.83° 00' E 554'
S.86° 16' E. 1868'
1655'
JOS. A. GRAY
N 4° 37' E 817.5'
PART OF - M.J. PLATT 28.87 A
GRAY & WYLAND 50.41 A
PART OF - LEONARD FARABAUGH 101.91 A.
PART OF ELLEN BAKER 8.86 A.
ELLEN BAKER
S.26° 00' W. 1474'
N85° 30' W 200'
JOHN SMITH
1661'
N 4° 45' E
S.20° 12' W. 1905'
LEONARD FARABAUGH
PART OF - J.C. WILLMAN 10.66 A
J.C. WILLMAN 44.6 A
C-1 Heading
1st Right
2nd Right
REBECCA BYRNES
2330'
N 29° 05' E
PART OF - J.C. WILLMAN 16.5 A
6.6 A
PART OF LEONARD FARABAUGH
N62° 30' E 435'
J. KOONTZ
PART OF - J. KOONTZ 9.47 A
S 4° 00' W
HENRY LINK
PART OF - REBECCA BYRNES 44.50
DEWITT DAILY 9.63 A. 18.92 A.
34.25 A.
PART OF - HENRY LINK 6.10 A
1315'
N 74° 45' E 412'
CASPER MILLER
N86° 50' E 199.5'
N 4° 00 E 515'
S 83° 30' E 56.7'
S 83° 30' E 1503'
SIMON WEAKLAND 55.12 A
37A.
S 22° 00' E 1050
N 83° 30' W 1970'
N 4° 00 E 945'
HENRY STRASSLER 75.81 A.
41.56 A
JOS. MILLER
S 1° 45' E
DAN MILLER
1538.7'
N 4° 20' E
TOTAL ACREAGE - 955.31 A.
PART OF - HENRY LINK 86.28 A
3352'
HENRY LINK
JOHN WEAKLAND
650.8
N 5° 01' E
WM. LANTZY 112.24 A
J. & J. KIRKPATRICK 58.15 A.
S 85° 25' E
2677'
JOHN MANION
263.8'
N 6° 05' E
S 3° 06' W 1670'
N 11° 15' W 540'
PART OF JOHN MANION 142.68 A
ELIAS DRISCOLL 68 A
S 4° 45' W 1693'
JOHN MANION
DEEP MINE SAFETY 400
0 200 400 800 Feet
JOHN WEAKLAND
S 21° 45' W 835'
2149'
N 67° 15' W
S 11° 45' W 220'
S 22° 00' W 733'
CHARLES WEAKLAND
2490'
N 74° 00' W
FRANK LUTHER
C. CAMPBELL & COMPANY
N66° 00' W 216'
N85° 37' W 865.0'
N76-45W 375'
N41-40W 648'
N3-00E 434'
N85° 30' W 955
12.17 Acres
16.50 A
5.30 Acres
N4-00E 1353'
S86° 00' E 970
10.0
2.50
880.0
S 3-12 W
40.0

DRAFT SHOWING
"D" SEAM COAL LANDS
IN
SUSQUEHANNA TWP. CAMBRIA, CO. PA.
TO BE LEASED BY
THE BLUBAKER COAL COMPANY
TO THE
MANION COAL CORPORATION
OCT. 1938 SCALE 1"=400'
I.J. Pfeister, Engr.

R-4214

R-4146

Drawing 03 4142

25-8-35