


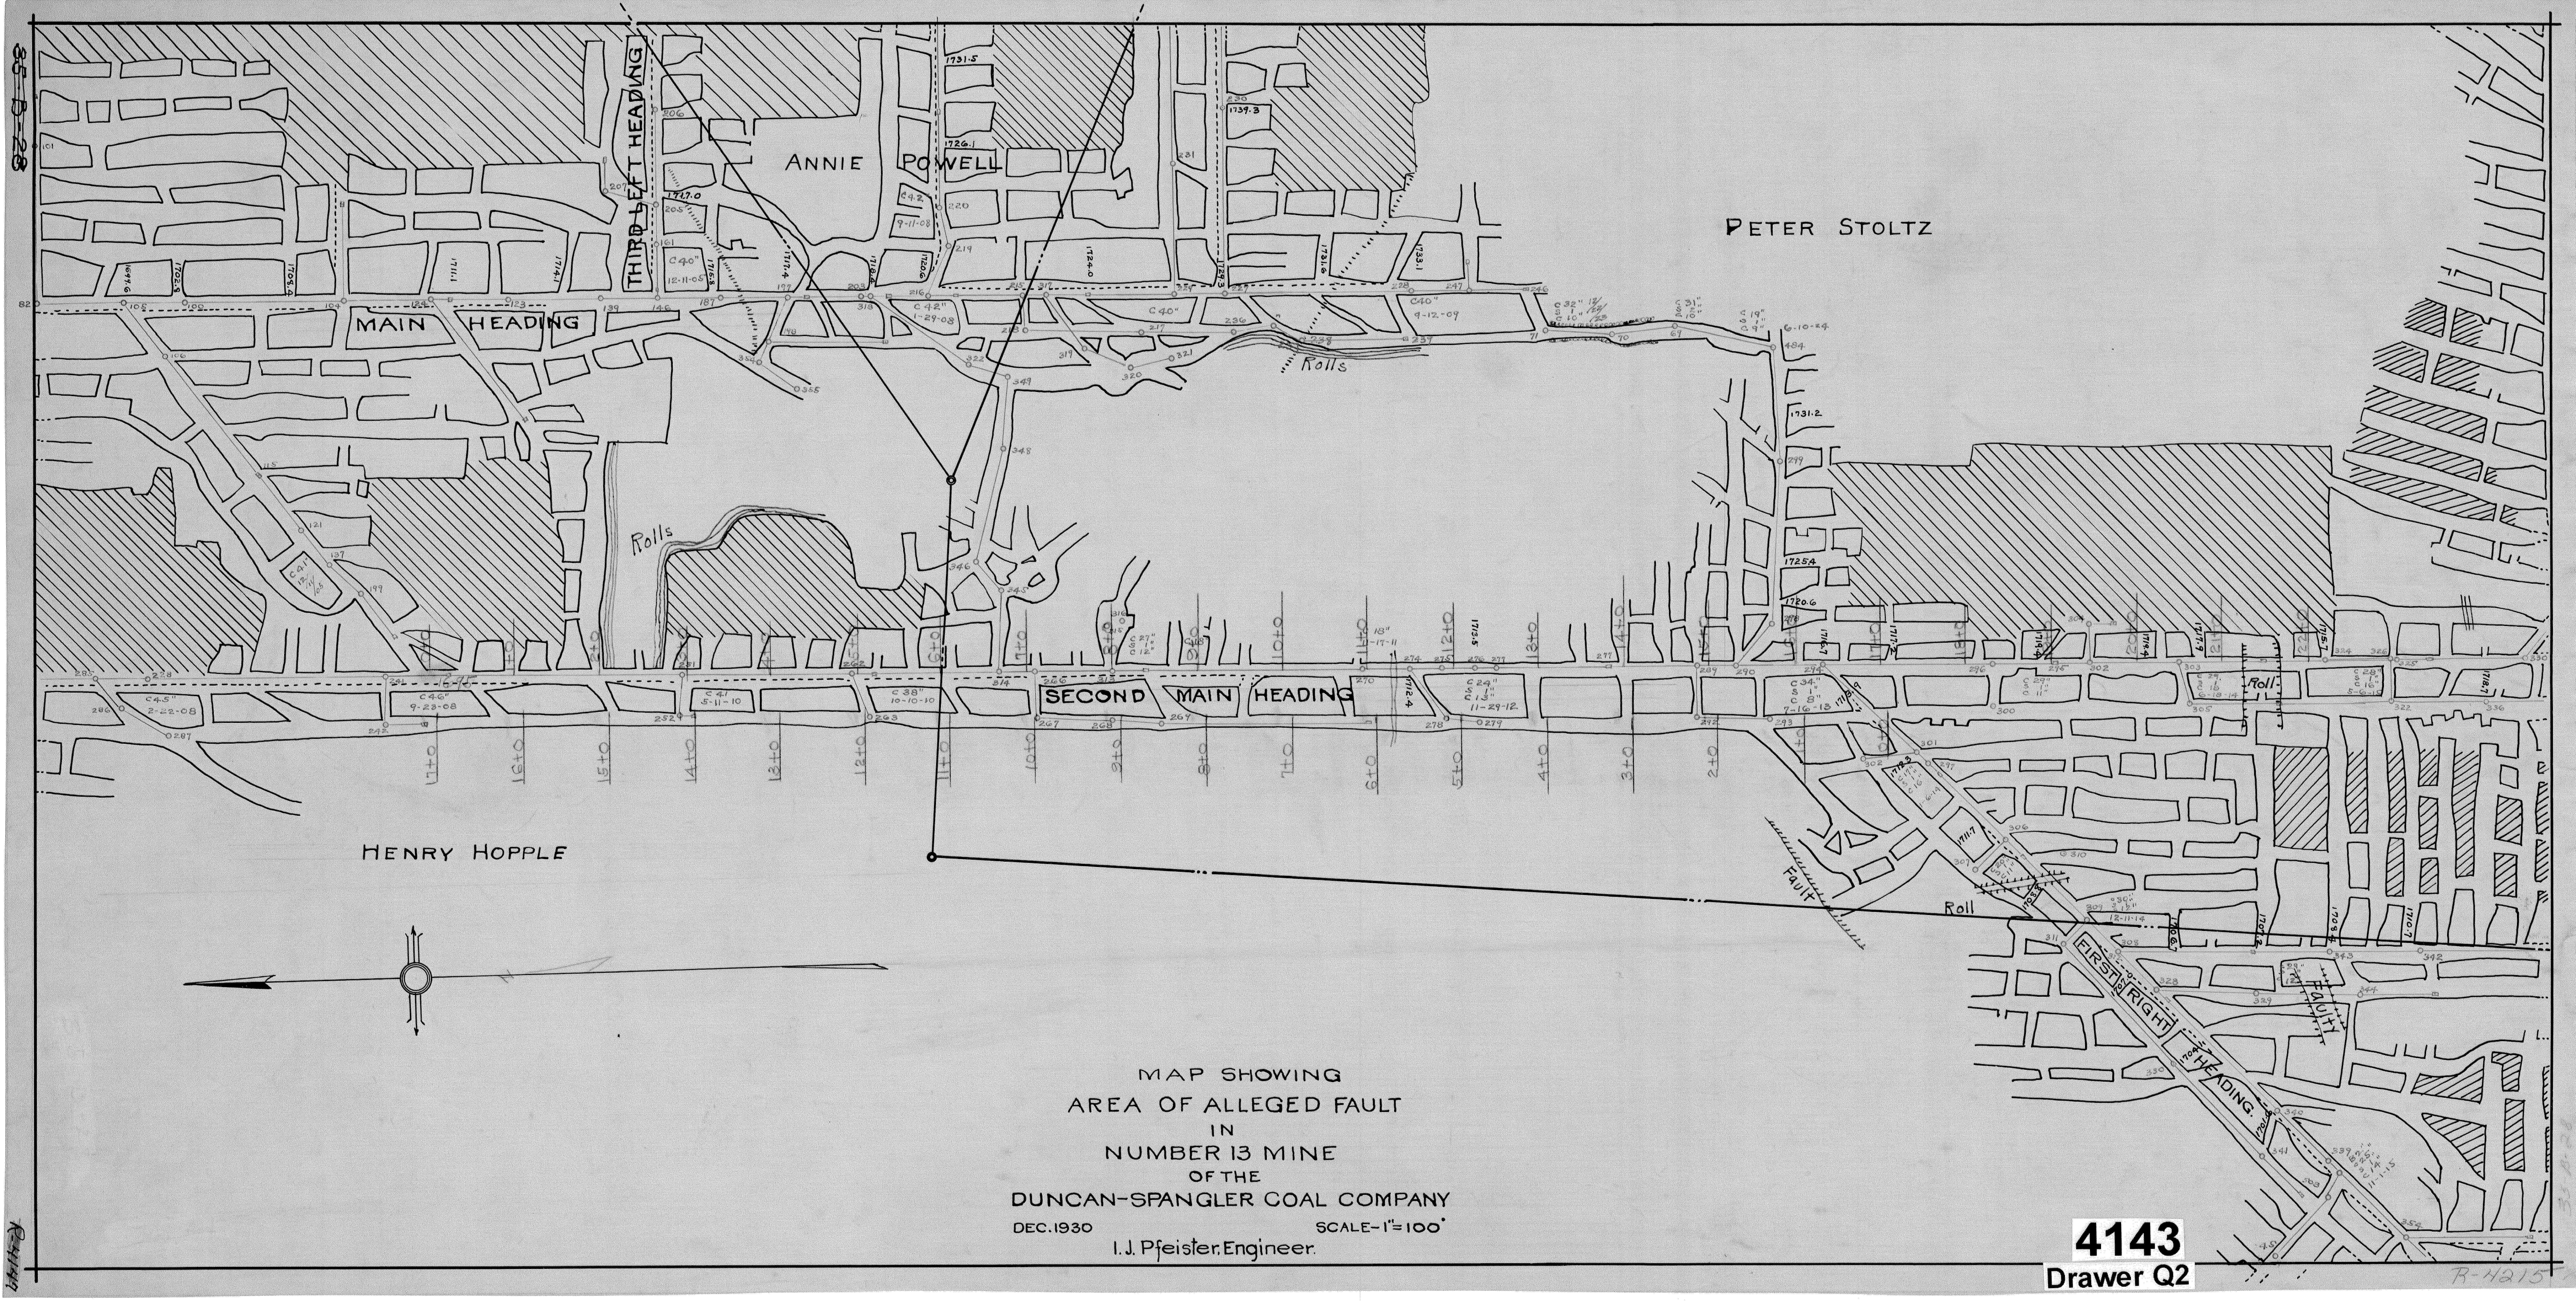

MAP SHOWING
AREA OF ALLEGED FAULT
IN
NUMBER 13 MINE
OF THE
DUNCAN-SPANGLER COAL COMPANY
DEC. 1930
I. J. Pfeister, Engineer.

SCALE - 1" = 100'

4143
Drawer Q2

R-4215