
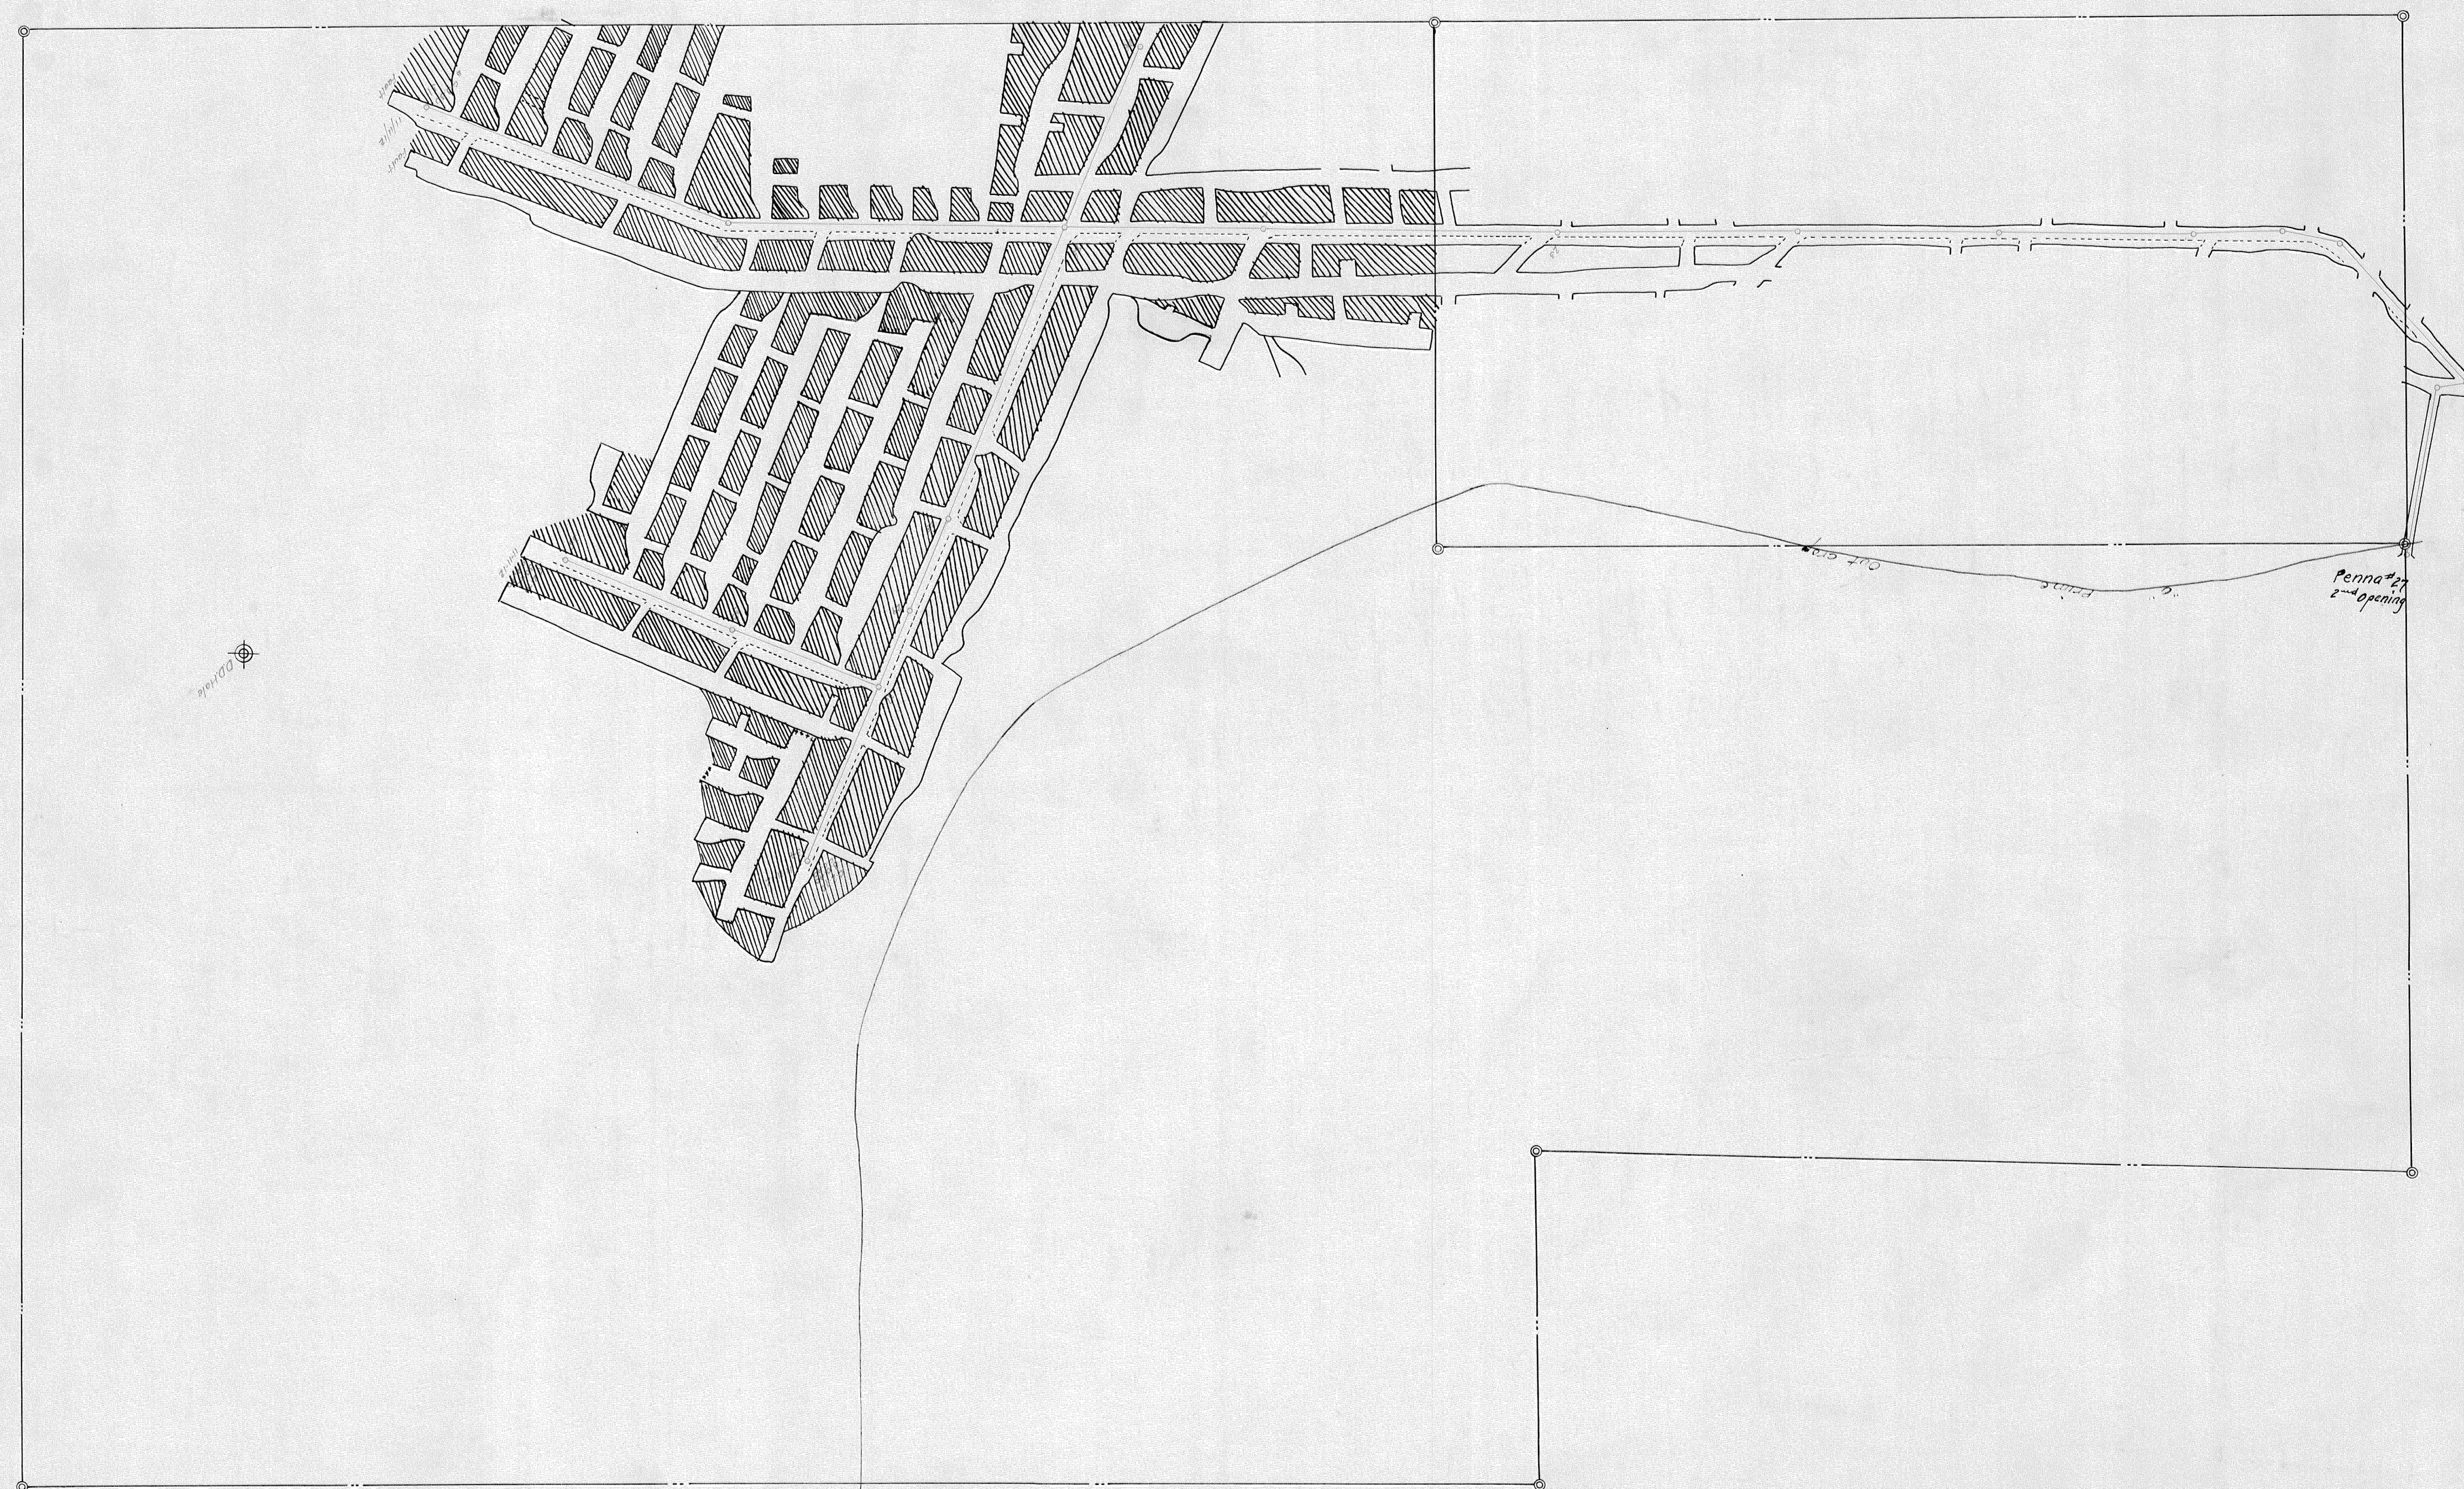


MAP
OF
PENNA No 27
IN
RELATION TO BLUBAKER COAL
11-15-12 C.E. Schlicher Engr. Scale 1"=100'

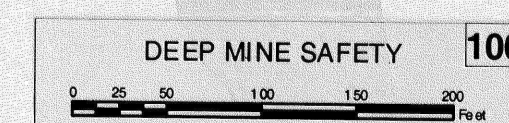

4144
Drawer Q2

R-4241
R-2039