


41502
drawer Q2

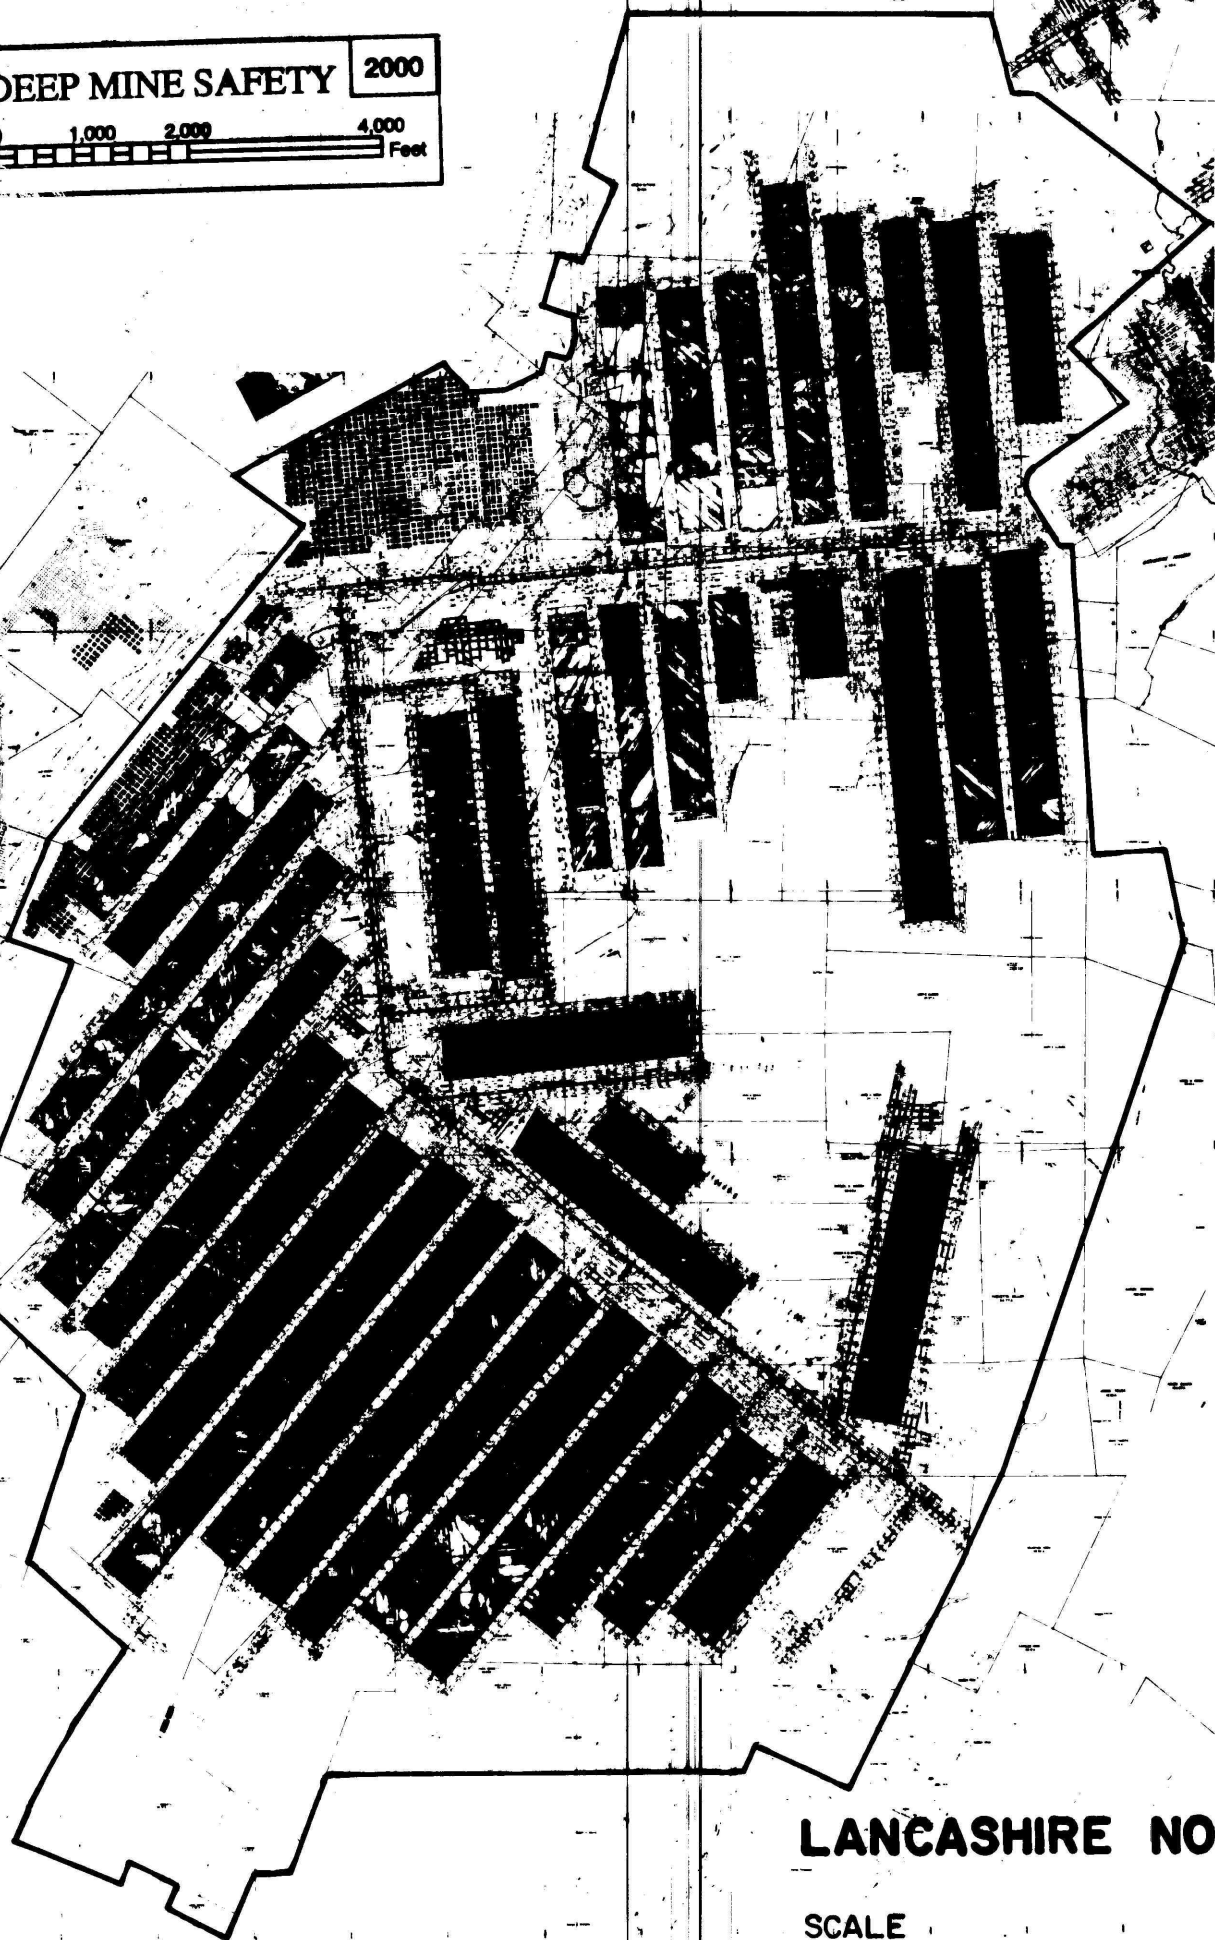

LANCASHIRE NO. 24-D

SCALE
1"=2000'

POSTED
6-30-85

P-086