


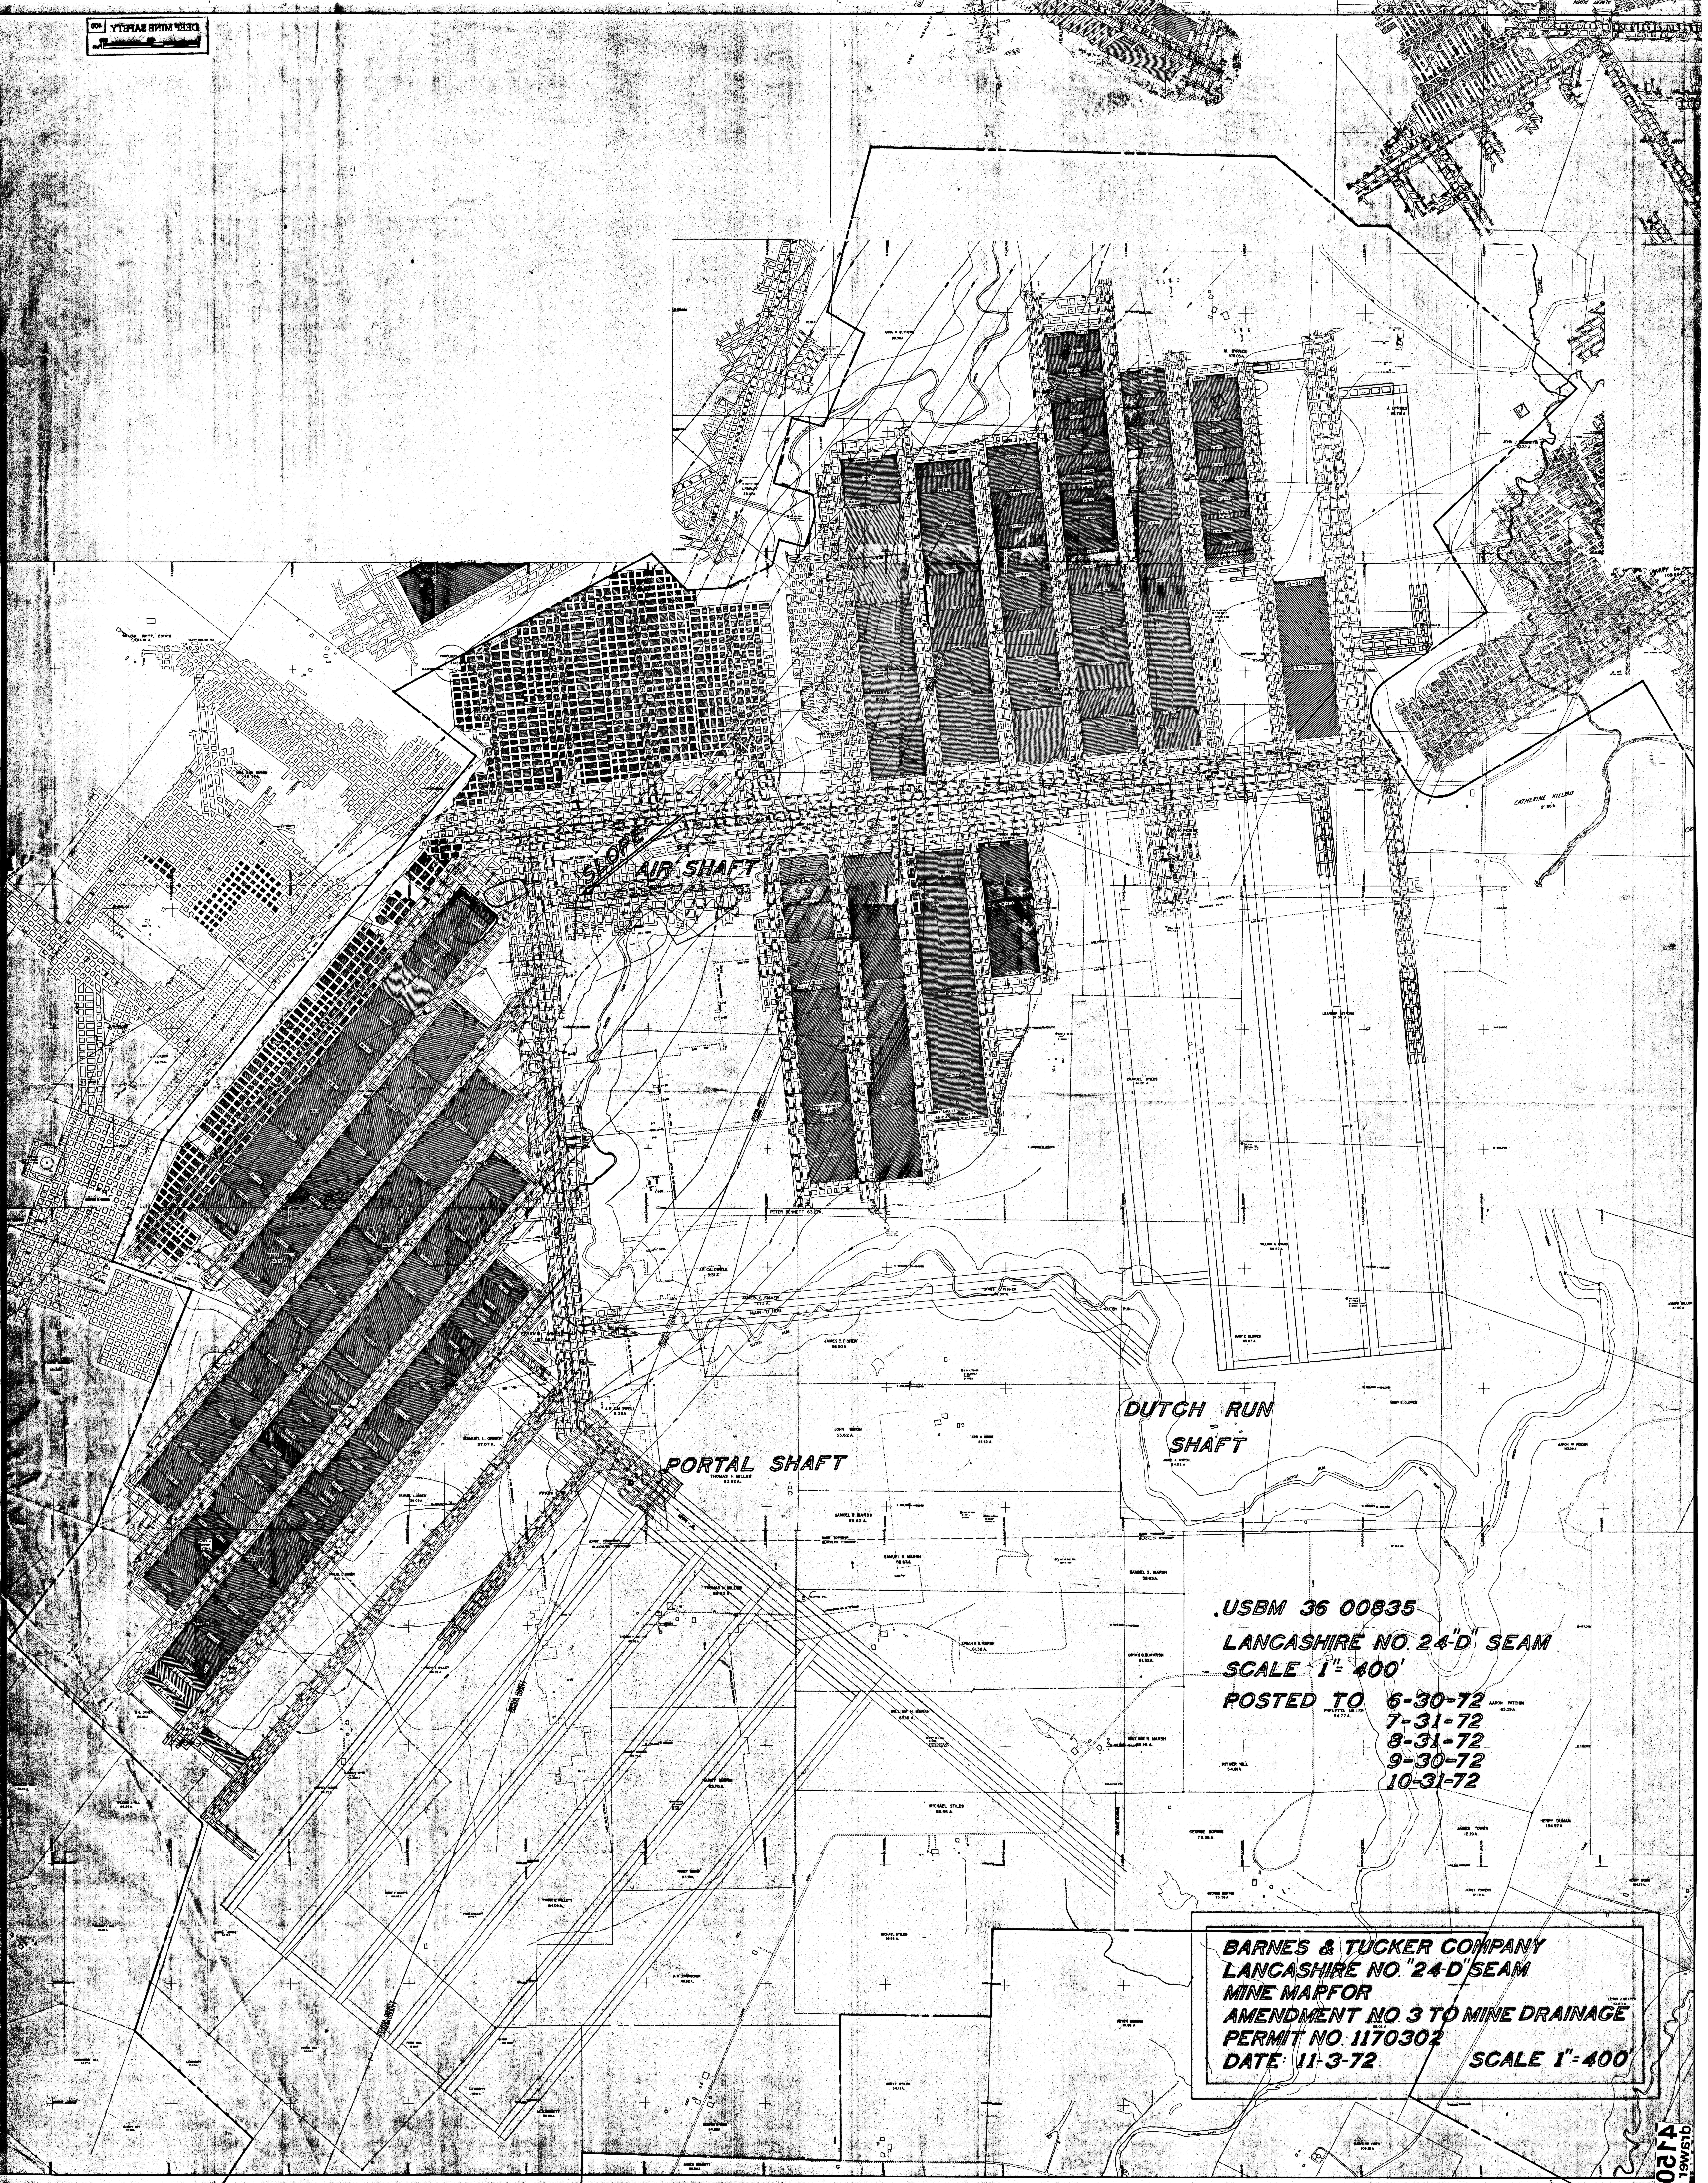

USBM 36 00835
LANCASHIRE NO. 24-D SEAM
SCALE 1" = 400'
POSTED TO 6-30-72
7-31-72
8-31-72
9-30-72
10-31-72

BARNES & TUCKER COMPANY
LANCASHIRE NO. 24-D SEAM
MINE MAP FOR
AMENDMENT NO. 3 TO MINE DRAINAGE
PERMIT NO. 1170302
DATE 11-3-72 SCALE 1" = 400'