


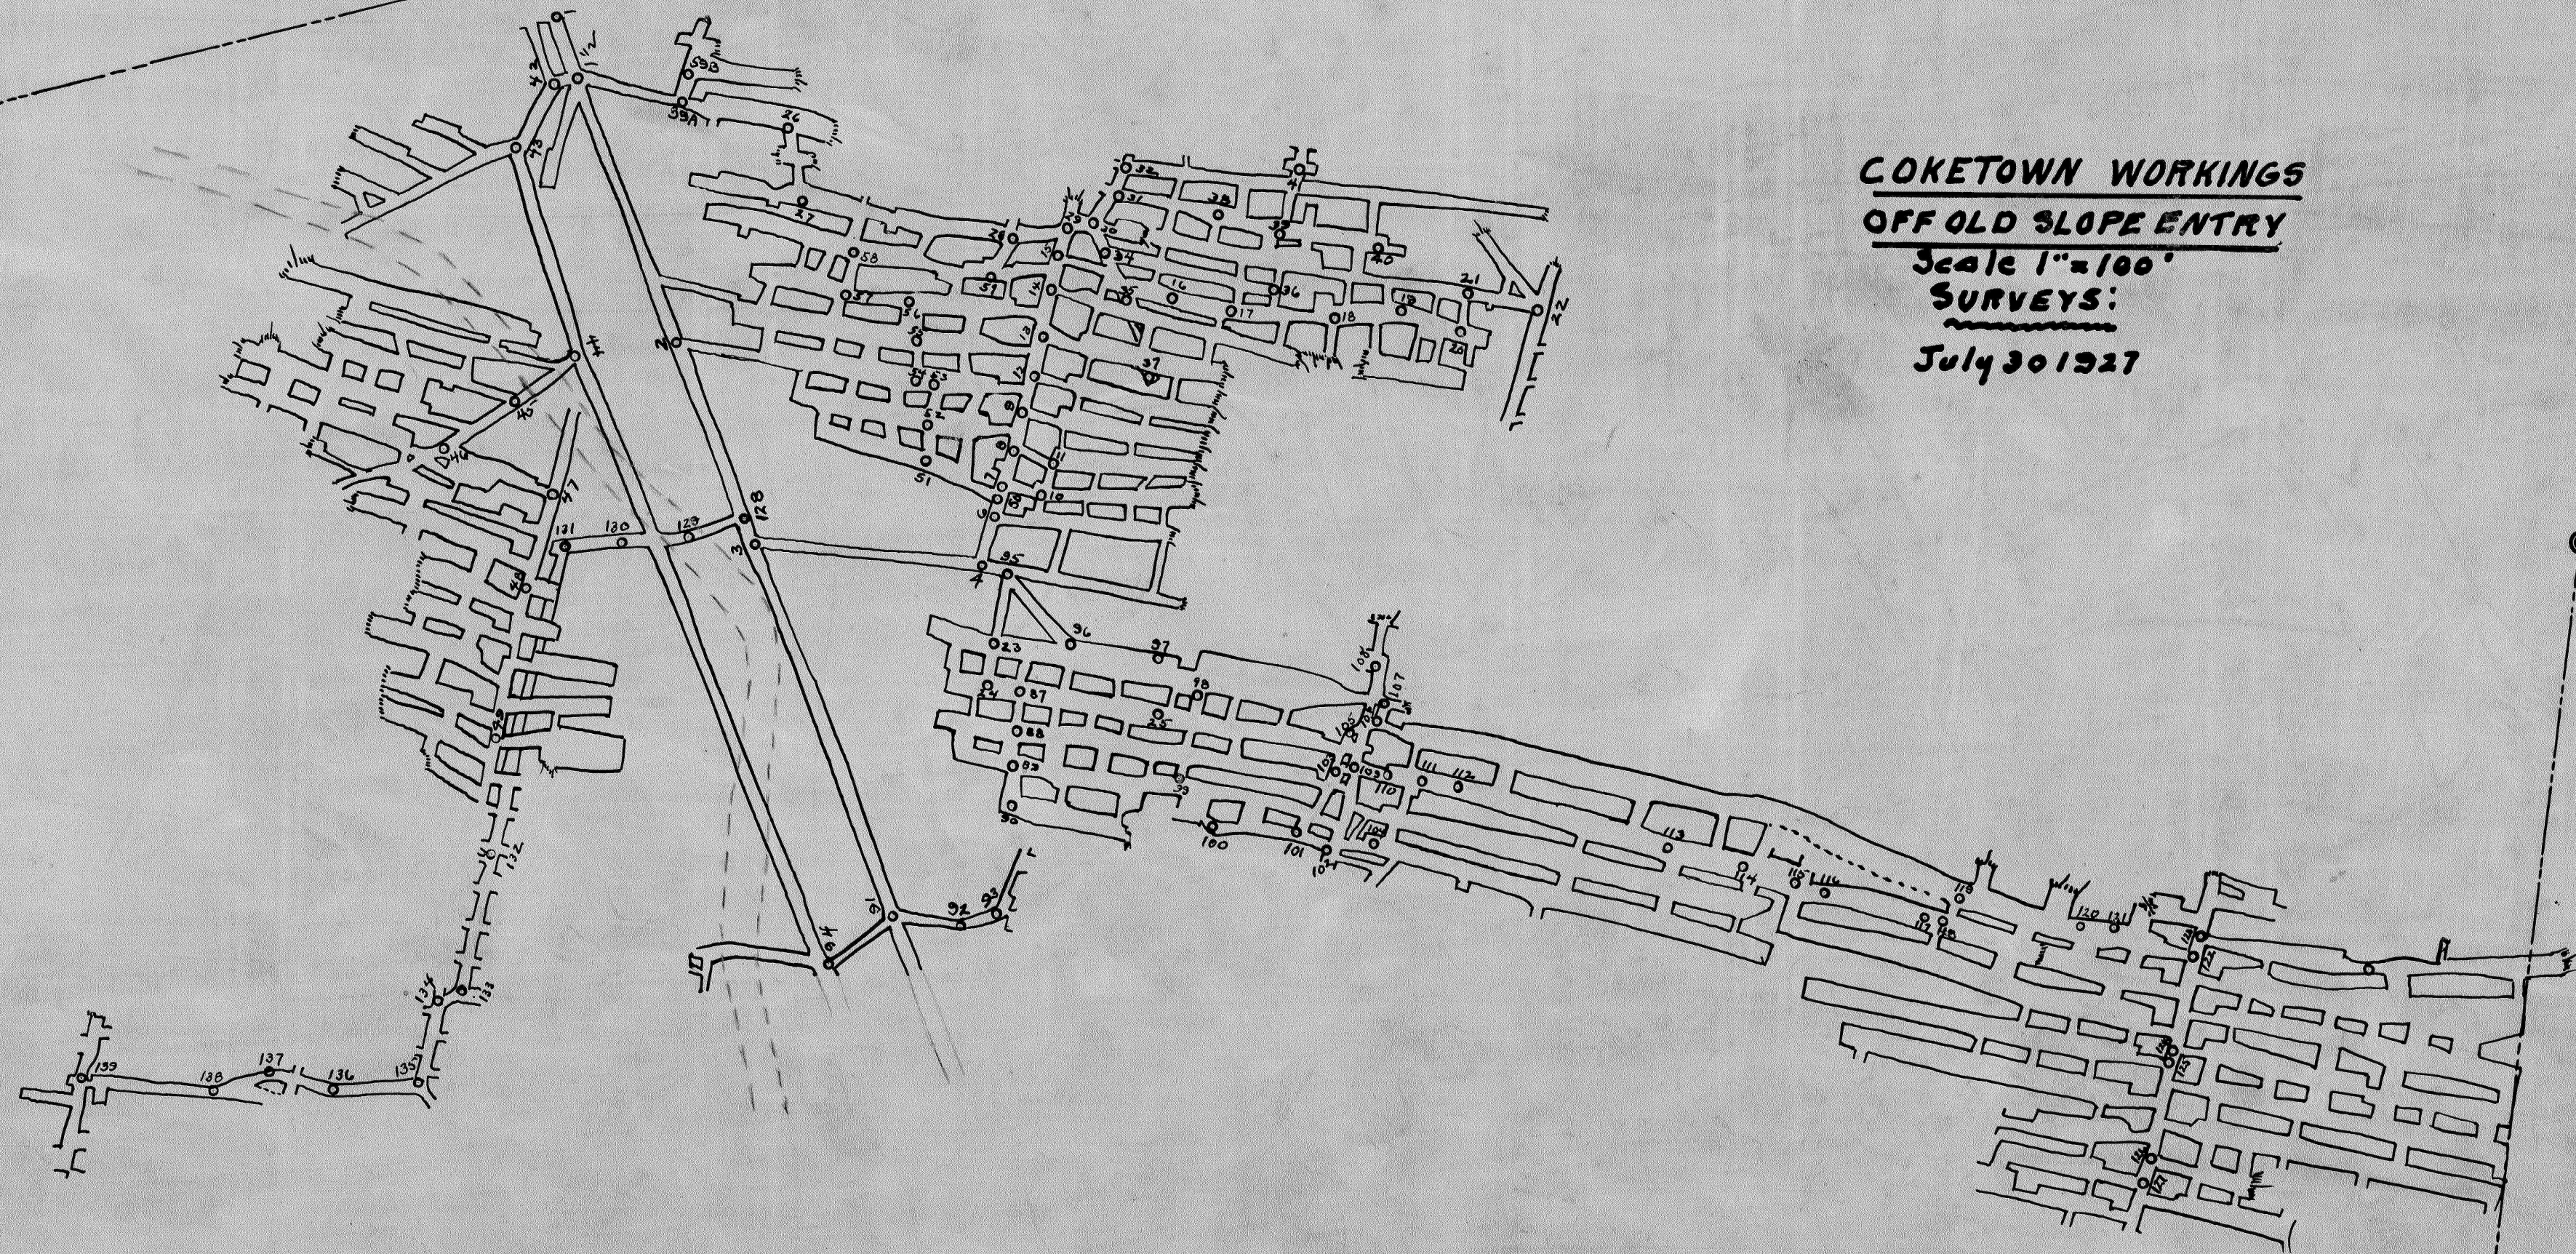

COKETOWN WORKINGS
OFF OLD SLOPE ENTRY
Scale 1"=100'
SURVEYS:
July 30 1927