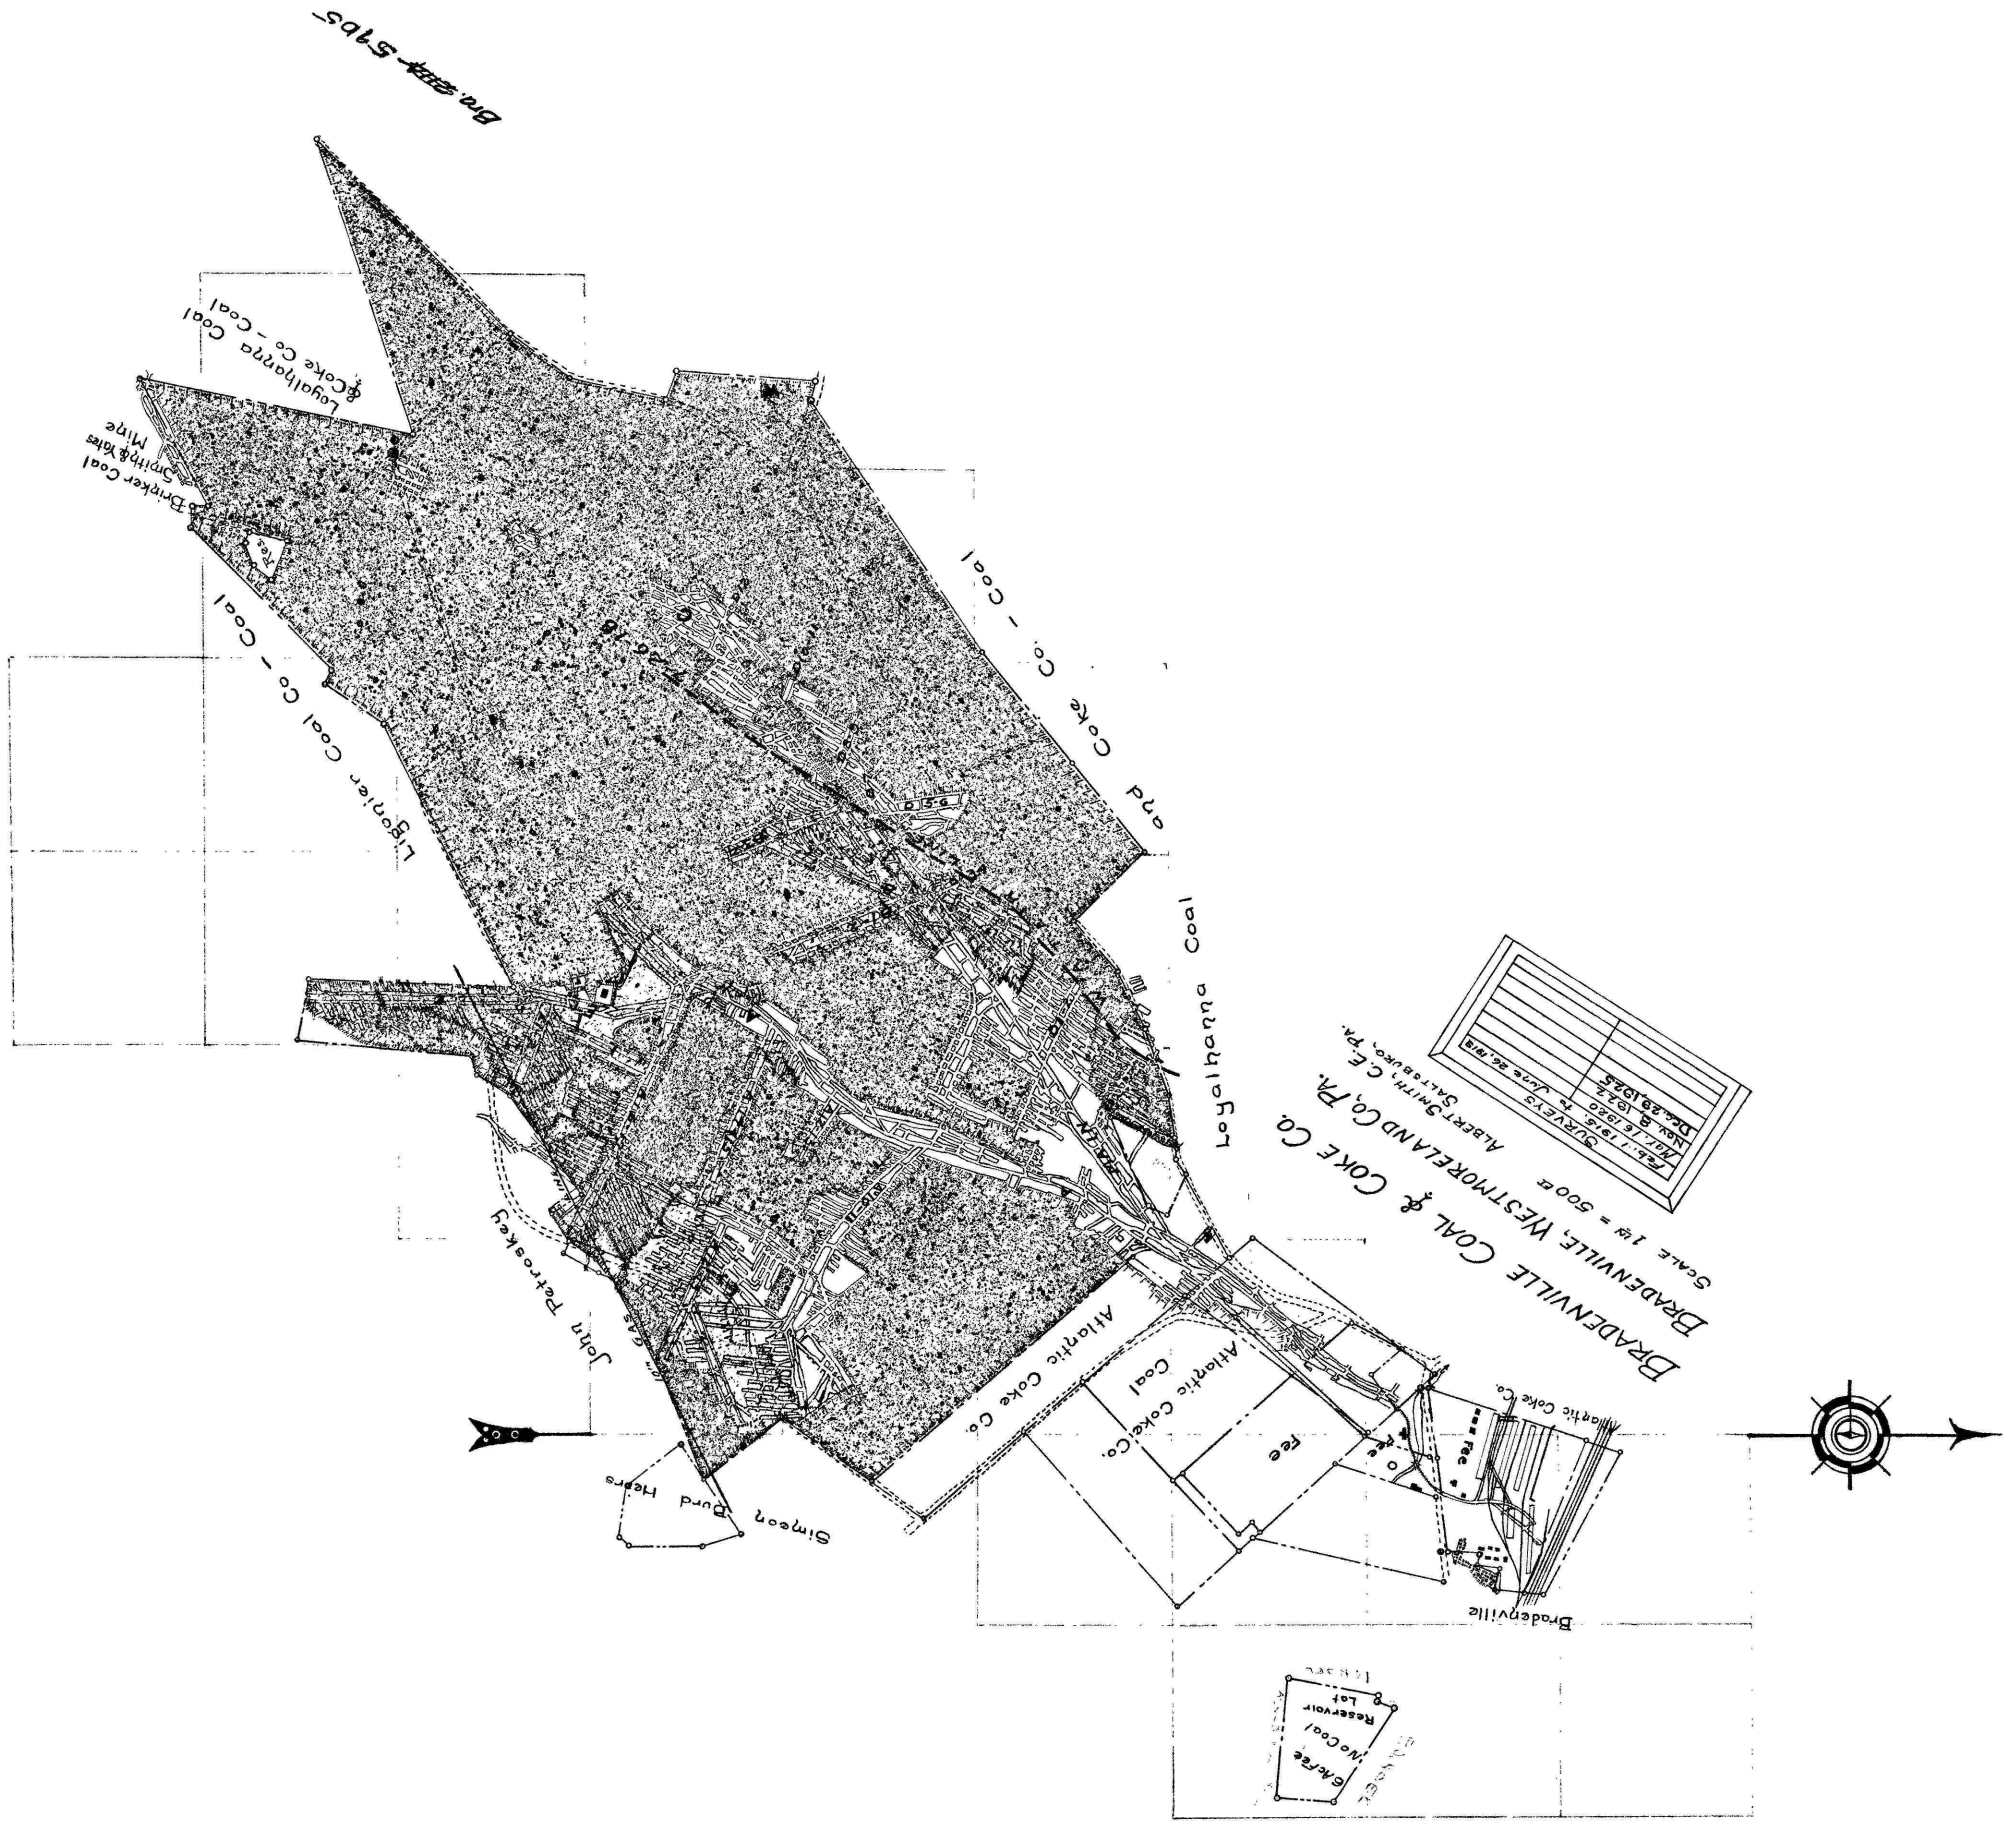
Bra. Brook Slope
Loyalhanna Coal & Coke Co. - Coal
Brinker Coal Smith & Bates Mine
Tee
Ligonier Coal Co - Coal
Loyalhanna Coal and Coke Co. - Coal
John Petrosky
Simeon Burd Heirs
Atlantic Coke Co.
Atlantic Coke Co. Coal
Fee
Atlantic Coke Co.
Broadenville
Acre
Reservoir Lot
Water Co.
BRADENVILLE COAL & COKE CO.
BRADENVILLE, WESTMORELAND CO., PA.
SCALE 1 in = 500 ft
ALBERT SMITH, C.E.
SALTSBURG, PA.
