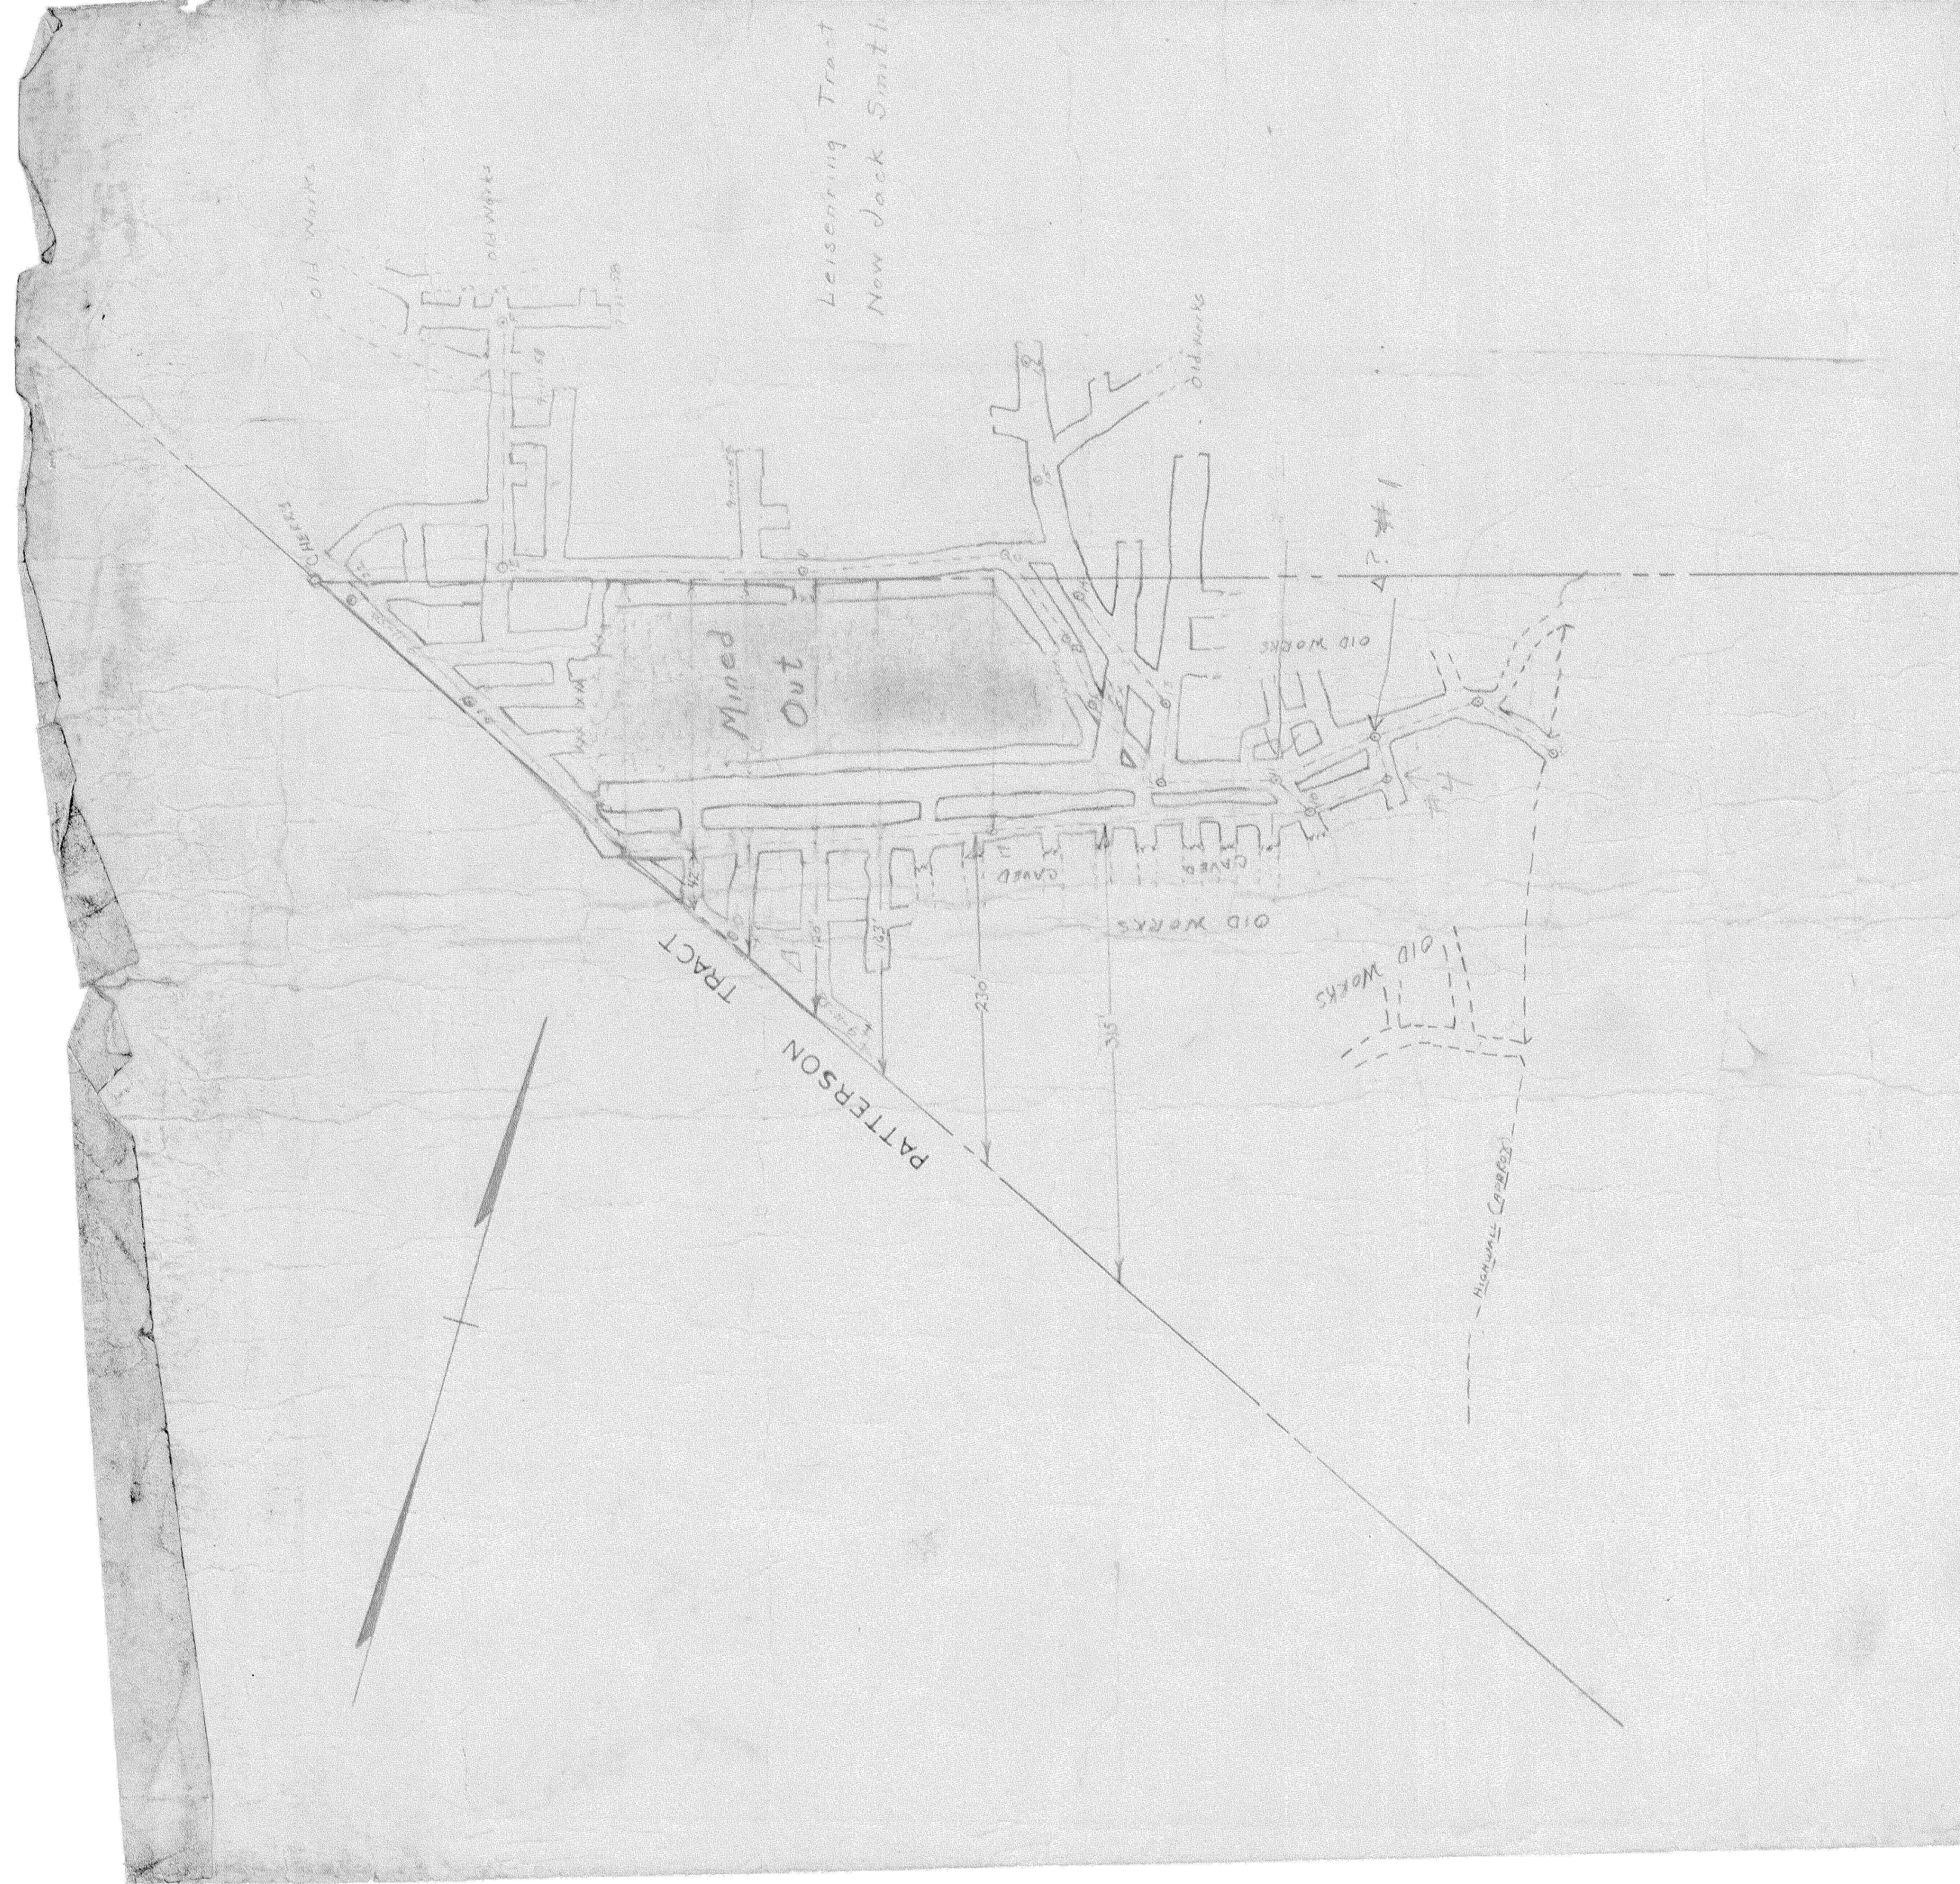


HOLSTEIN No. 1
OPERATED BY JACK SMITH
YOUNG TWP. INDIANA CO. PA.
R. B. SHANNON & ASSOCIATES, INDIANA, PA.
DRAWN BY L. M. J.

4156
drawer Q2