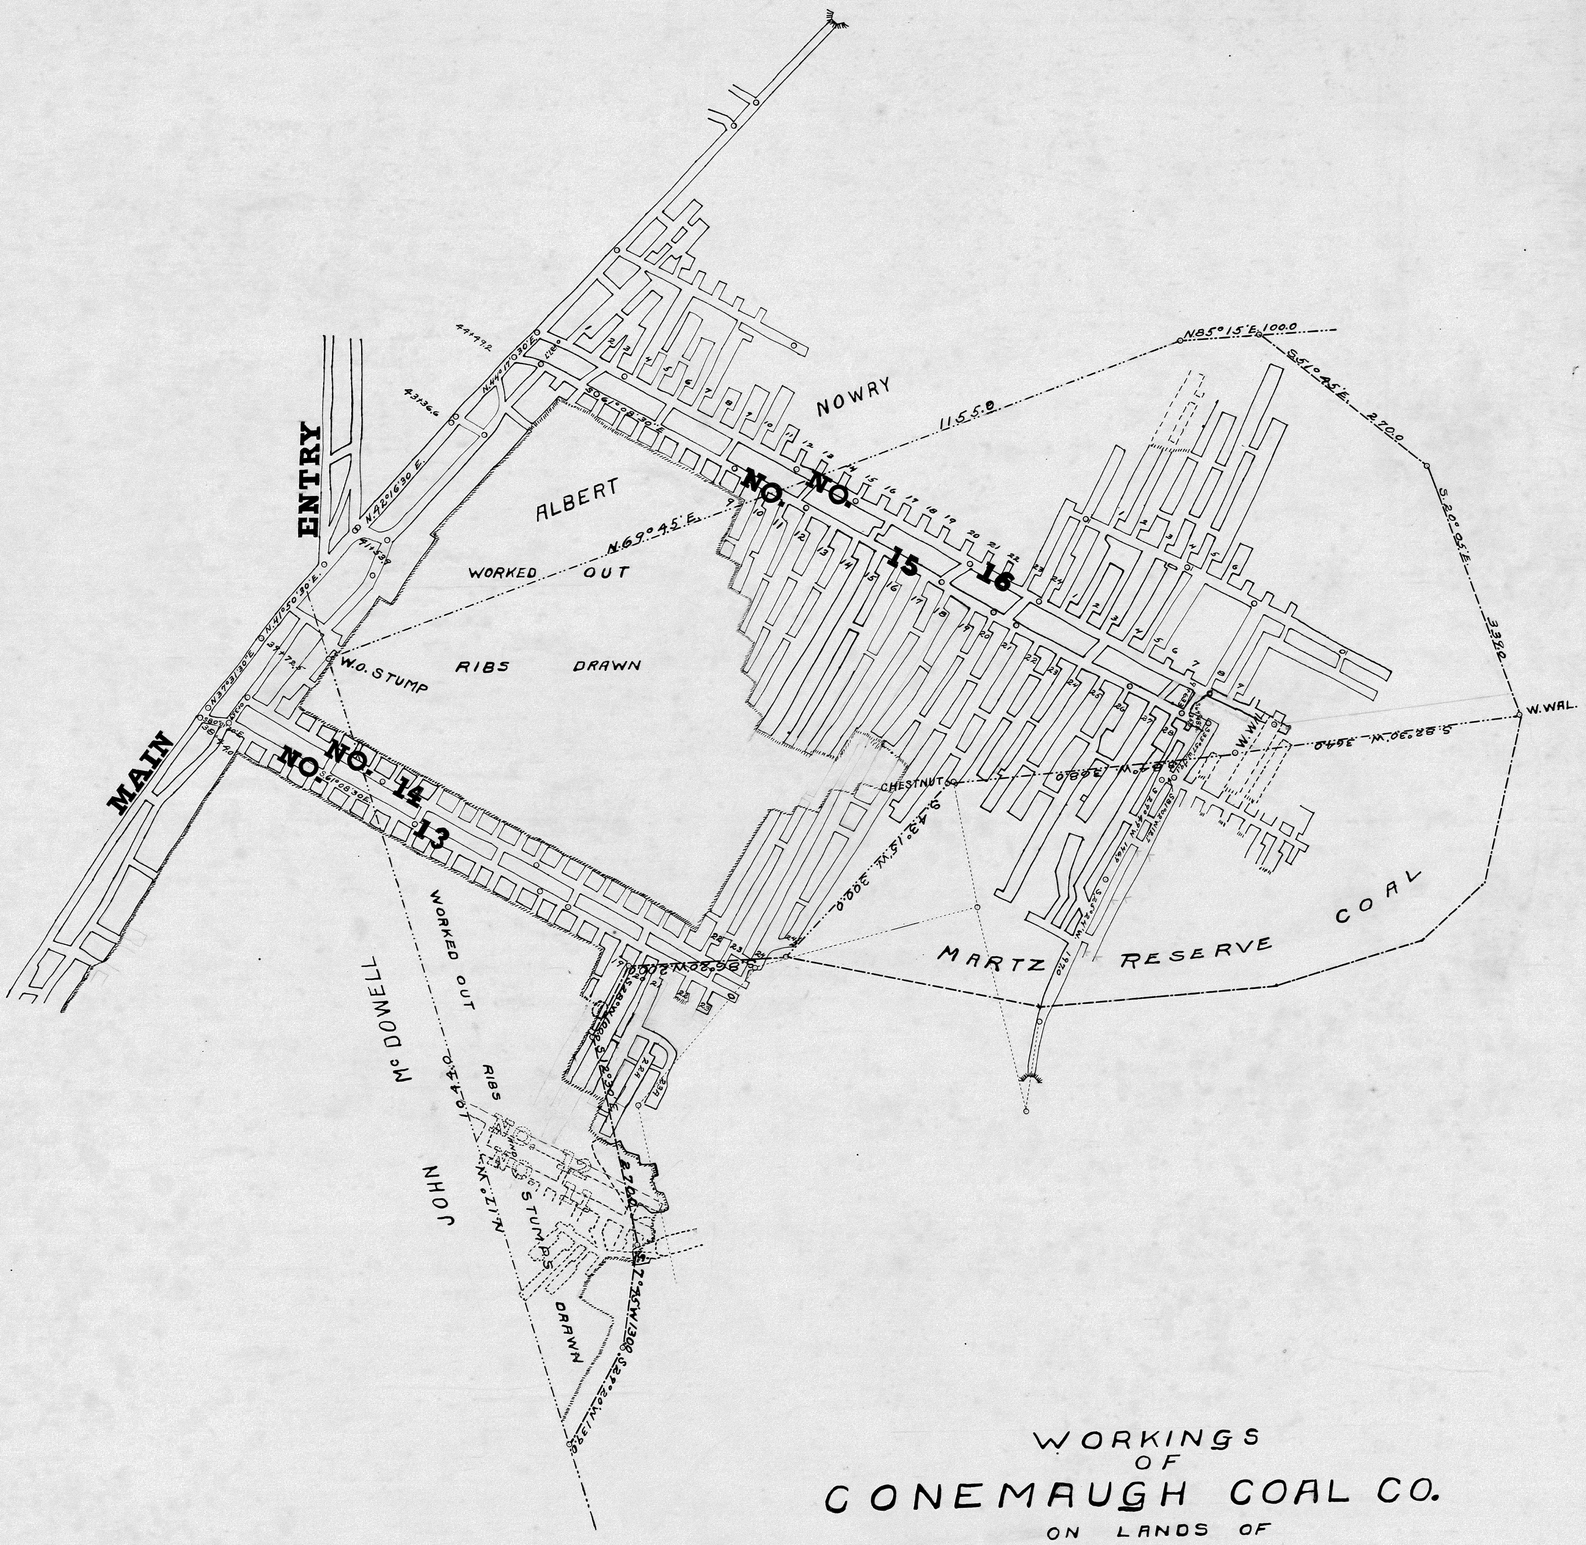

WORKINGS OF CONEMAUGH COAL CO. ON LANDS OF JOHN MARTZ

CONEMAUGH TWP. INDIANA CO., PA.

SCALE 1 IN. = 100 FT.

ALBERT SMITH C.E. SALTSBURG PA.

INSIDE SURVEY MAY 2 & 3 1912.
OUTSIDE SURVEY MAY 3 & 9 1912

4160
drawer Q2

6010
CON 2617-G