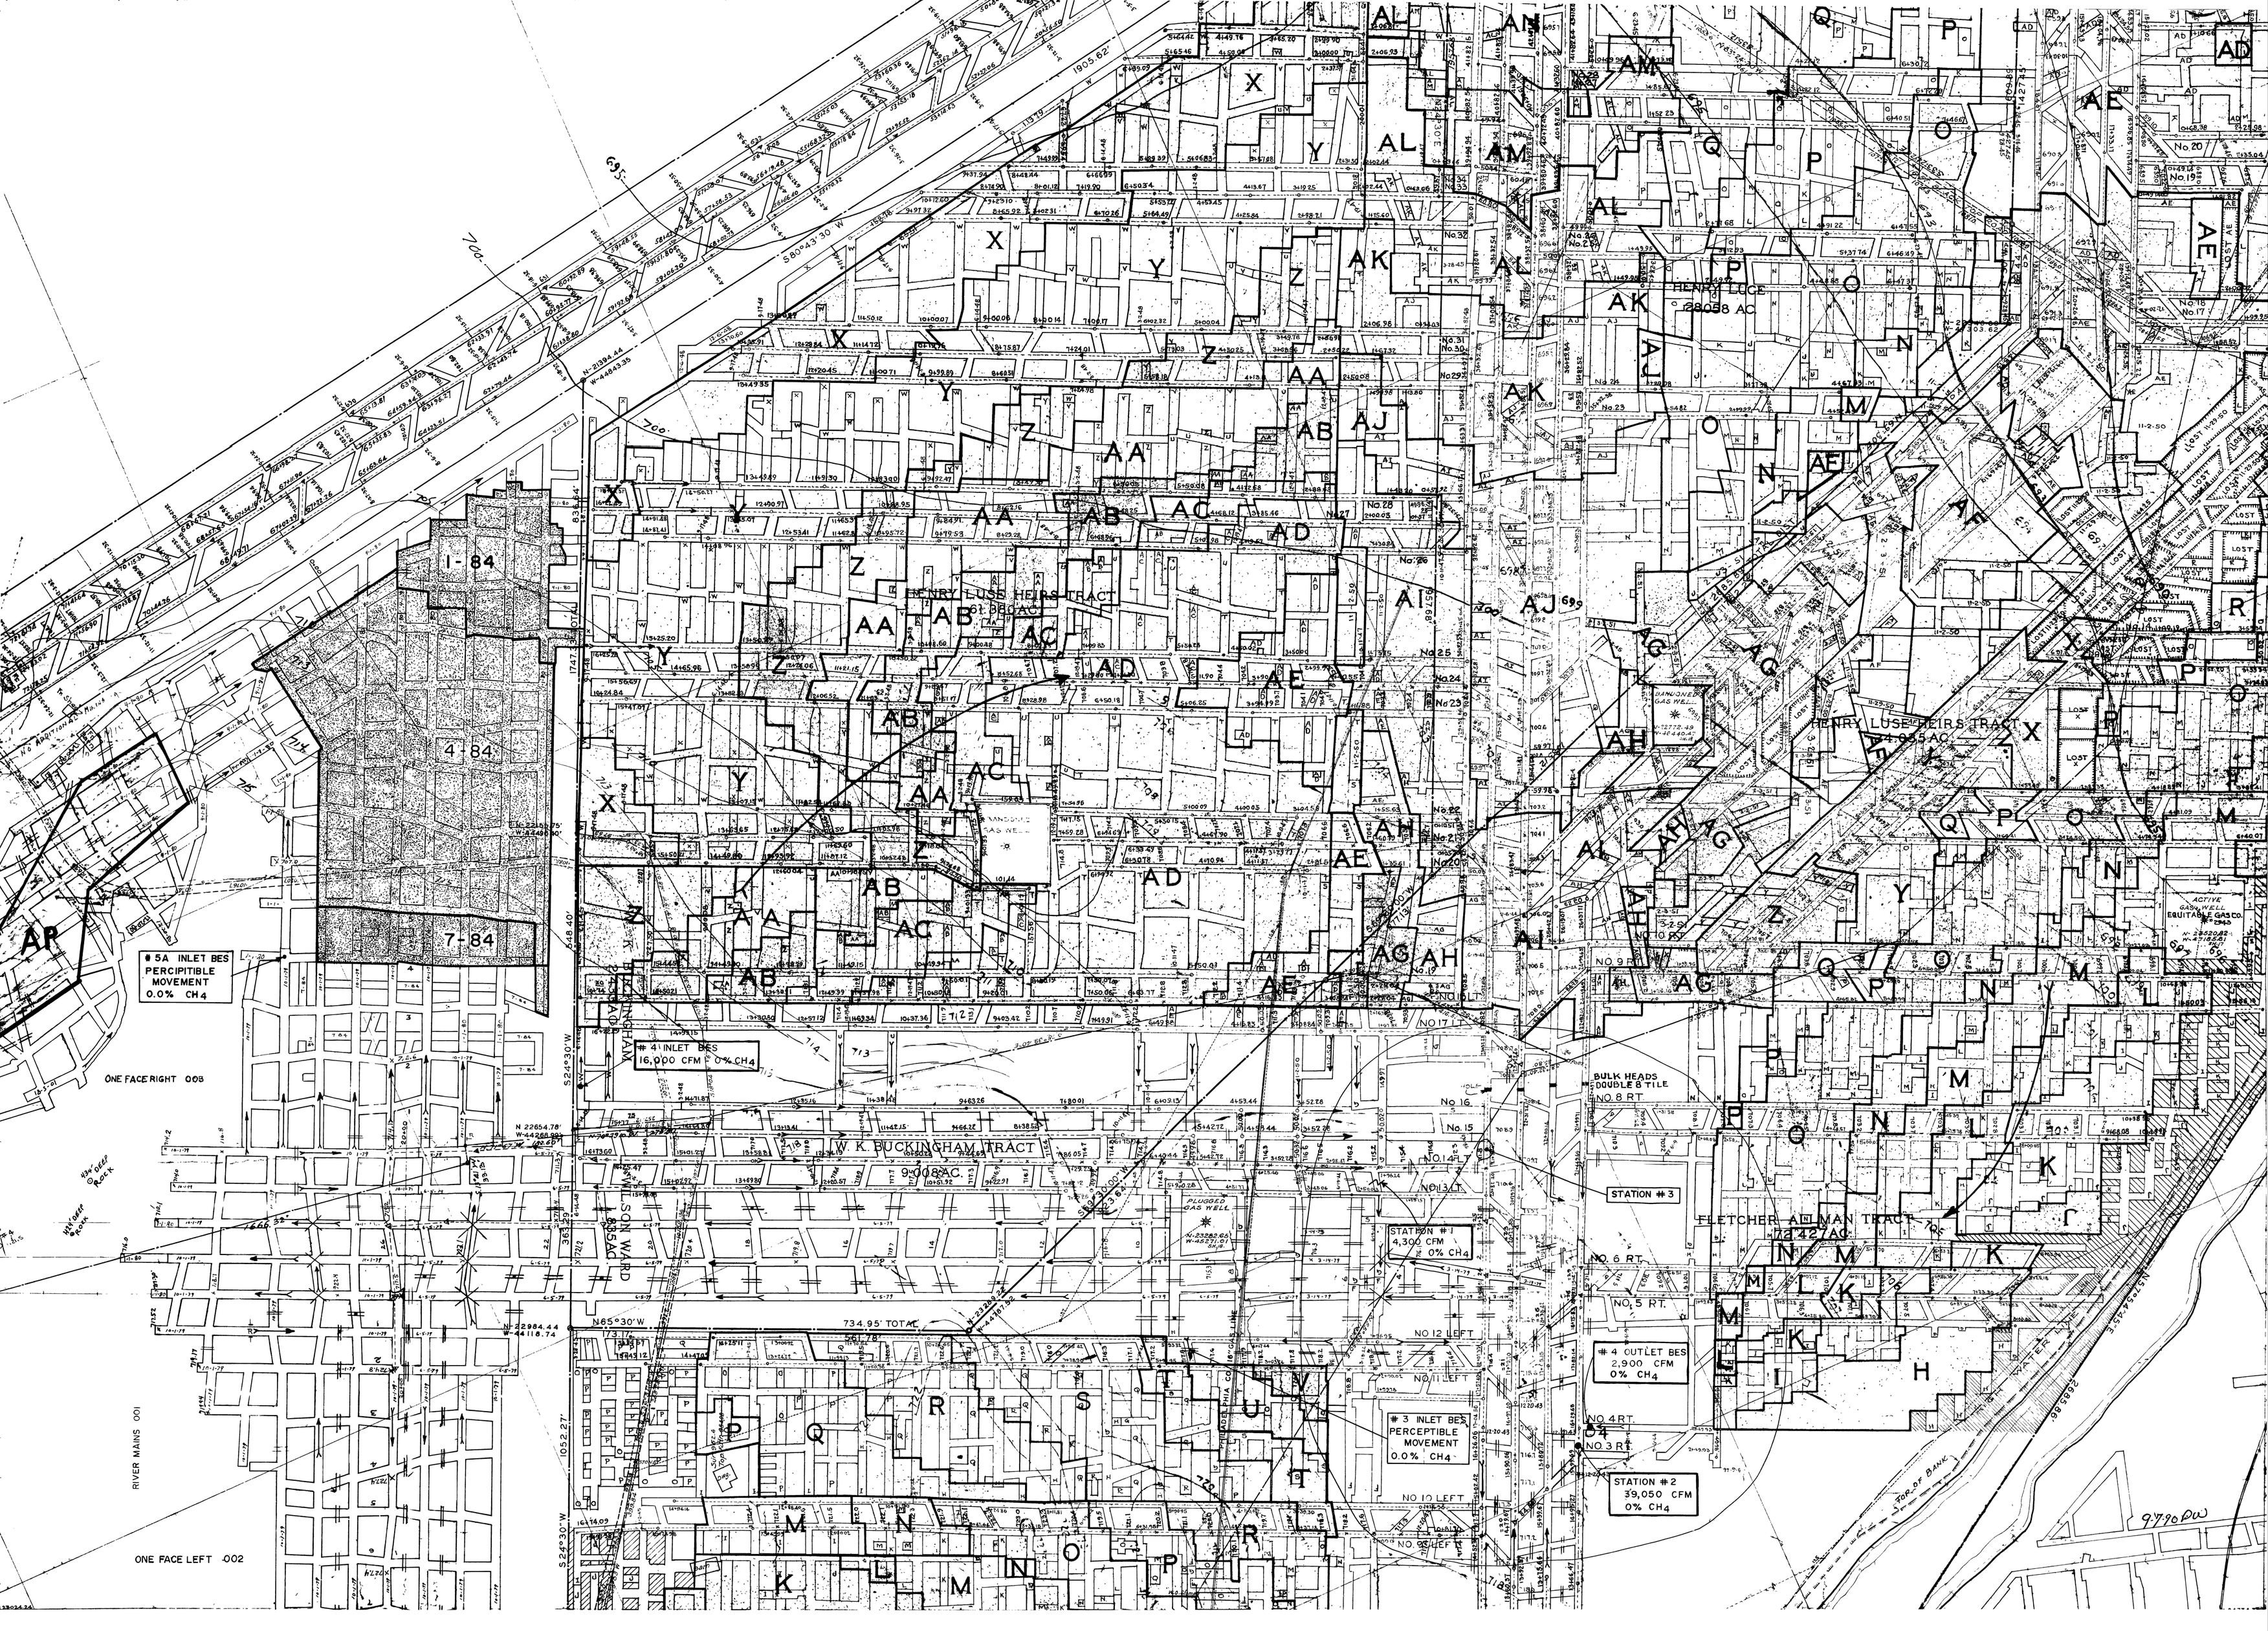

RIVER MAINS 001
ONE FACE LEFT 002
ONE FACE RIGHT 003
424' DEEP ROCK
434' DEEP ROCK
#5A INLET BES PERCIPITIBLE MOVEMENT 0.0% CH4
NO ADDITIONAL MINING
AP
7-84
4-84
1-84
S24°30"W 1052.27'
363.29
S24°30'W 548.40'
1747.33 TOTAL
836.64'
N-22984.44 W-44118.74
N 22654.78 W-44268.90
N-21394.44 W-44843.35
N65°30'W
WILSON WARD 1.835 AC
W. R. BUCKINGHAM
#4 INLET BES 16,000 CFM 0% CH4
W. K. BUCKINGHAM TRACT 9.008 AC.
734.95' TOTAL
N-23269.22 W-44787.92
S69°30'00"W 523.64
PLUGGED GAS WELL
ABANDONED GAS WELL
PHILADELPHIA CO. 16" GAS LINE
HENRY LUSE HEIRS TRACT
S80°43'30"W
1905.62'
#3 INLET BES PERCEPTIBLE MOVEMENT 0.0% CH4
STATION #1 4,300 CFM 0% CH4
NO 10 LEFT
NO 11 LEFT
NO 12 LEFT
No. 15
No 16
NO 17
No. 20
No 23
No 24
No 25
No 26
No 27
No 28
No 29
No 31
No 32
STATION #2 39,050 CFM 0% CH4
#4 OUTLET BES 2,900 CFM 0% CH4
NO. 3 RT
NO. 4 RT
NO. 5 RT
NO. 6 RT
STATION #3
BULK HEADS DOUBLE 8 TILE
NO. 8 RT
NO 9 RT
NO 10 RT
N24°30'E 1957.68
HENRY LUCE 28.058 AC
FLETCHER ANMAN TRACT 14.42 AC
TOP OF BANK
WATER LINE
2685.86'
N57°54'45"E
ACTIVE GAS WELL EQUITABLE GAS CO.
HENRY LUSE HEIRS TRACT
609.89
1427.45
LOST AE
LOST
700
695
699
X
Y
Z
AA
AB
AC
AD
AE
AF
AG
AH
AI
AJ
AK
AL
AM
AN
H
I
J
K
L
M
N
O
P
Q
R
S
T
U
V