


PERMITTED TO
CANON COAL COMPANY
JEFFERSON TWP GREENE COUNTY PENNSYLVANIA
PITT GAS MINE
OWNED & OPERATED BY DYNAMIC RECOVERY INC

STATE SUBSISTENCE SUBMITTAL

MSHA ID No. 36-06478
PITTSBURGH SEAM

SCALE:
1" = 200'

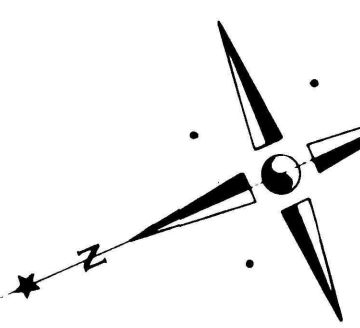

MINERAL OWNERSHIP
U.S. STEEL MINING CO., INC.
NORTHERN DIVISION
33 WEST BEAD
WASHINGTON, PA 15301

TAX MAP & PARCEL NO.	SURFACE OWNER
1501-130A	TEB RESOURCES INC.
1501-131	MARLETTA RICHARDSON
1501-135	TEB RESOURCES INC.
1501-136	"
1501-148	"
1501-150A	"
1501-151	"
1501-152	"
1501-153	"
1501-157	"

- LEGEND
- CONTINGUATED MINING 10/16/90-4/15/91
 - PERMIT BOUNDARY
 - MINING COMPLETED AREA
 - SUPPORT AREA AFTER MINING
 - PREVIOUS 6 MONTH MINING AREA
 - SURFACE PROPERTY AREA
 - UNPROTECTED STRUCTURES BEFORE 4/27/66
 - STRUCTURES BUILT AFTER 4/27/66
 - STRUCTURES NO LONGER IN EXISTENCE
 - COAL LEFT IN PLACE
 - GOB AREA

