

 


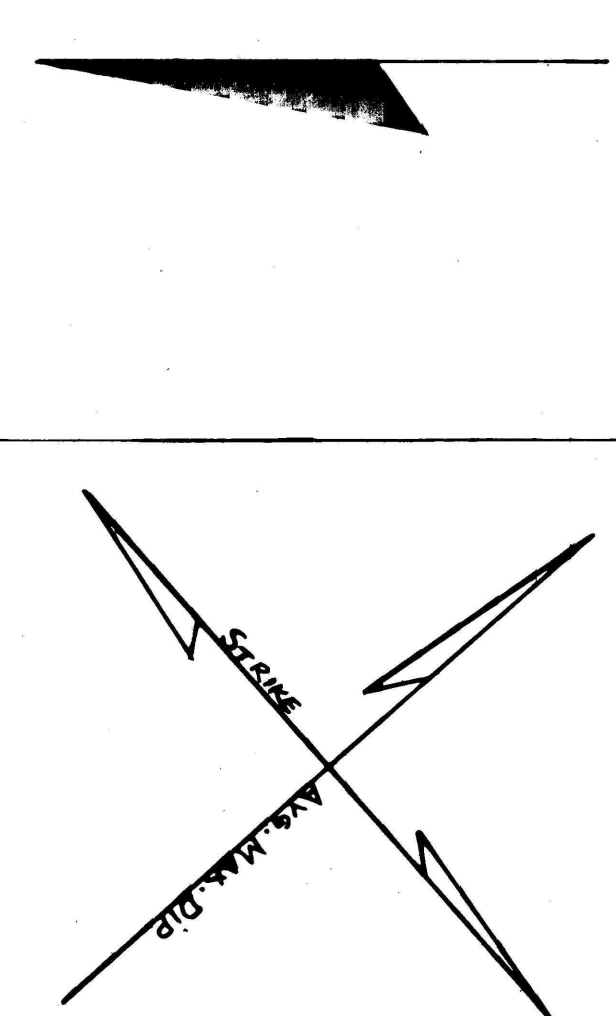

JAMISON NO. 1
JAMISON COAL COMPANY
SALINA, PA.
BELL TWP. WESTMORELAND CO.
UPPER FREEPORT SEAM
SCALE: 1" = 500'
MAIN OFFICE: 111 N. MAIN ST. GREENSBURG, PA.

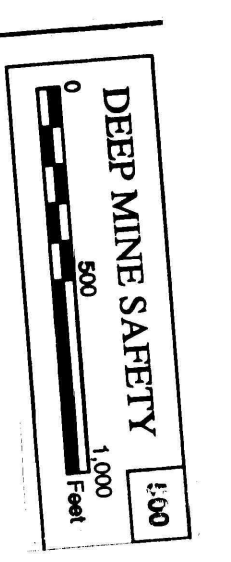

REVISIONS:
JULY 22, 1965
AUG 21, 1965