


D.P.H.⁸
D.P.H.¹
D.P.H.²
D.P.H.³
D.P.H.⁴
D.P.H.⁵
D.P.H.⁶
D.P.H.⁷

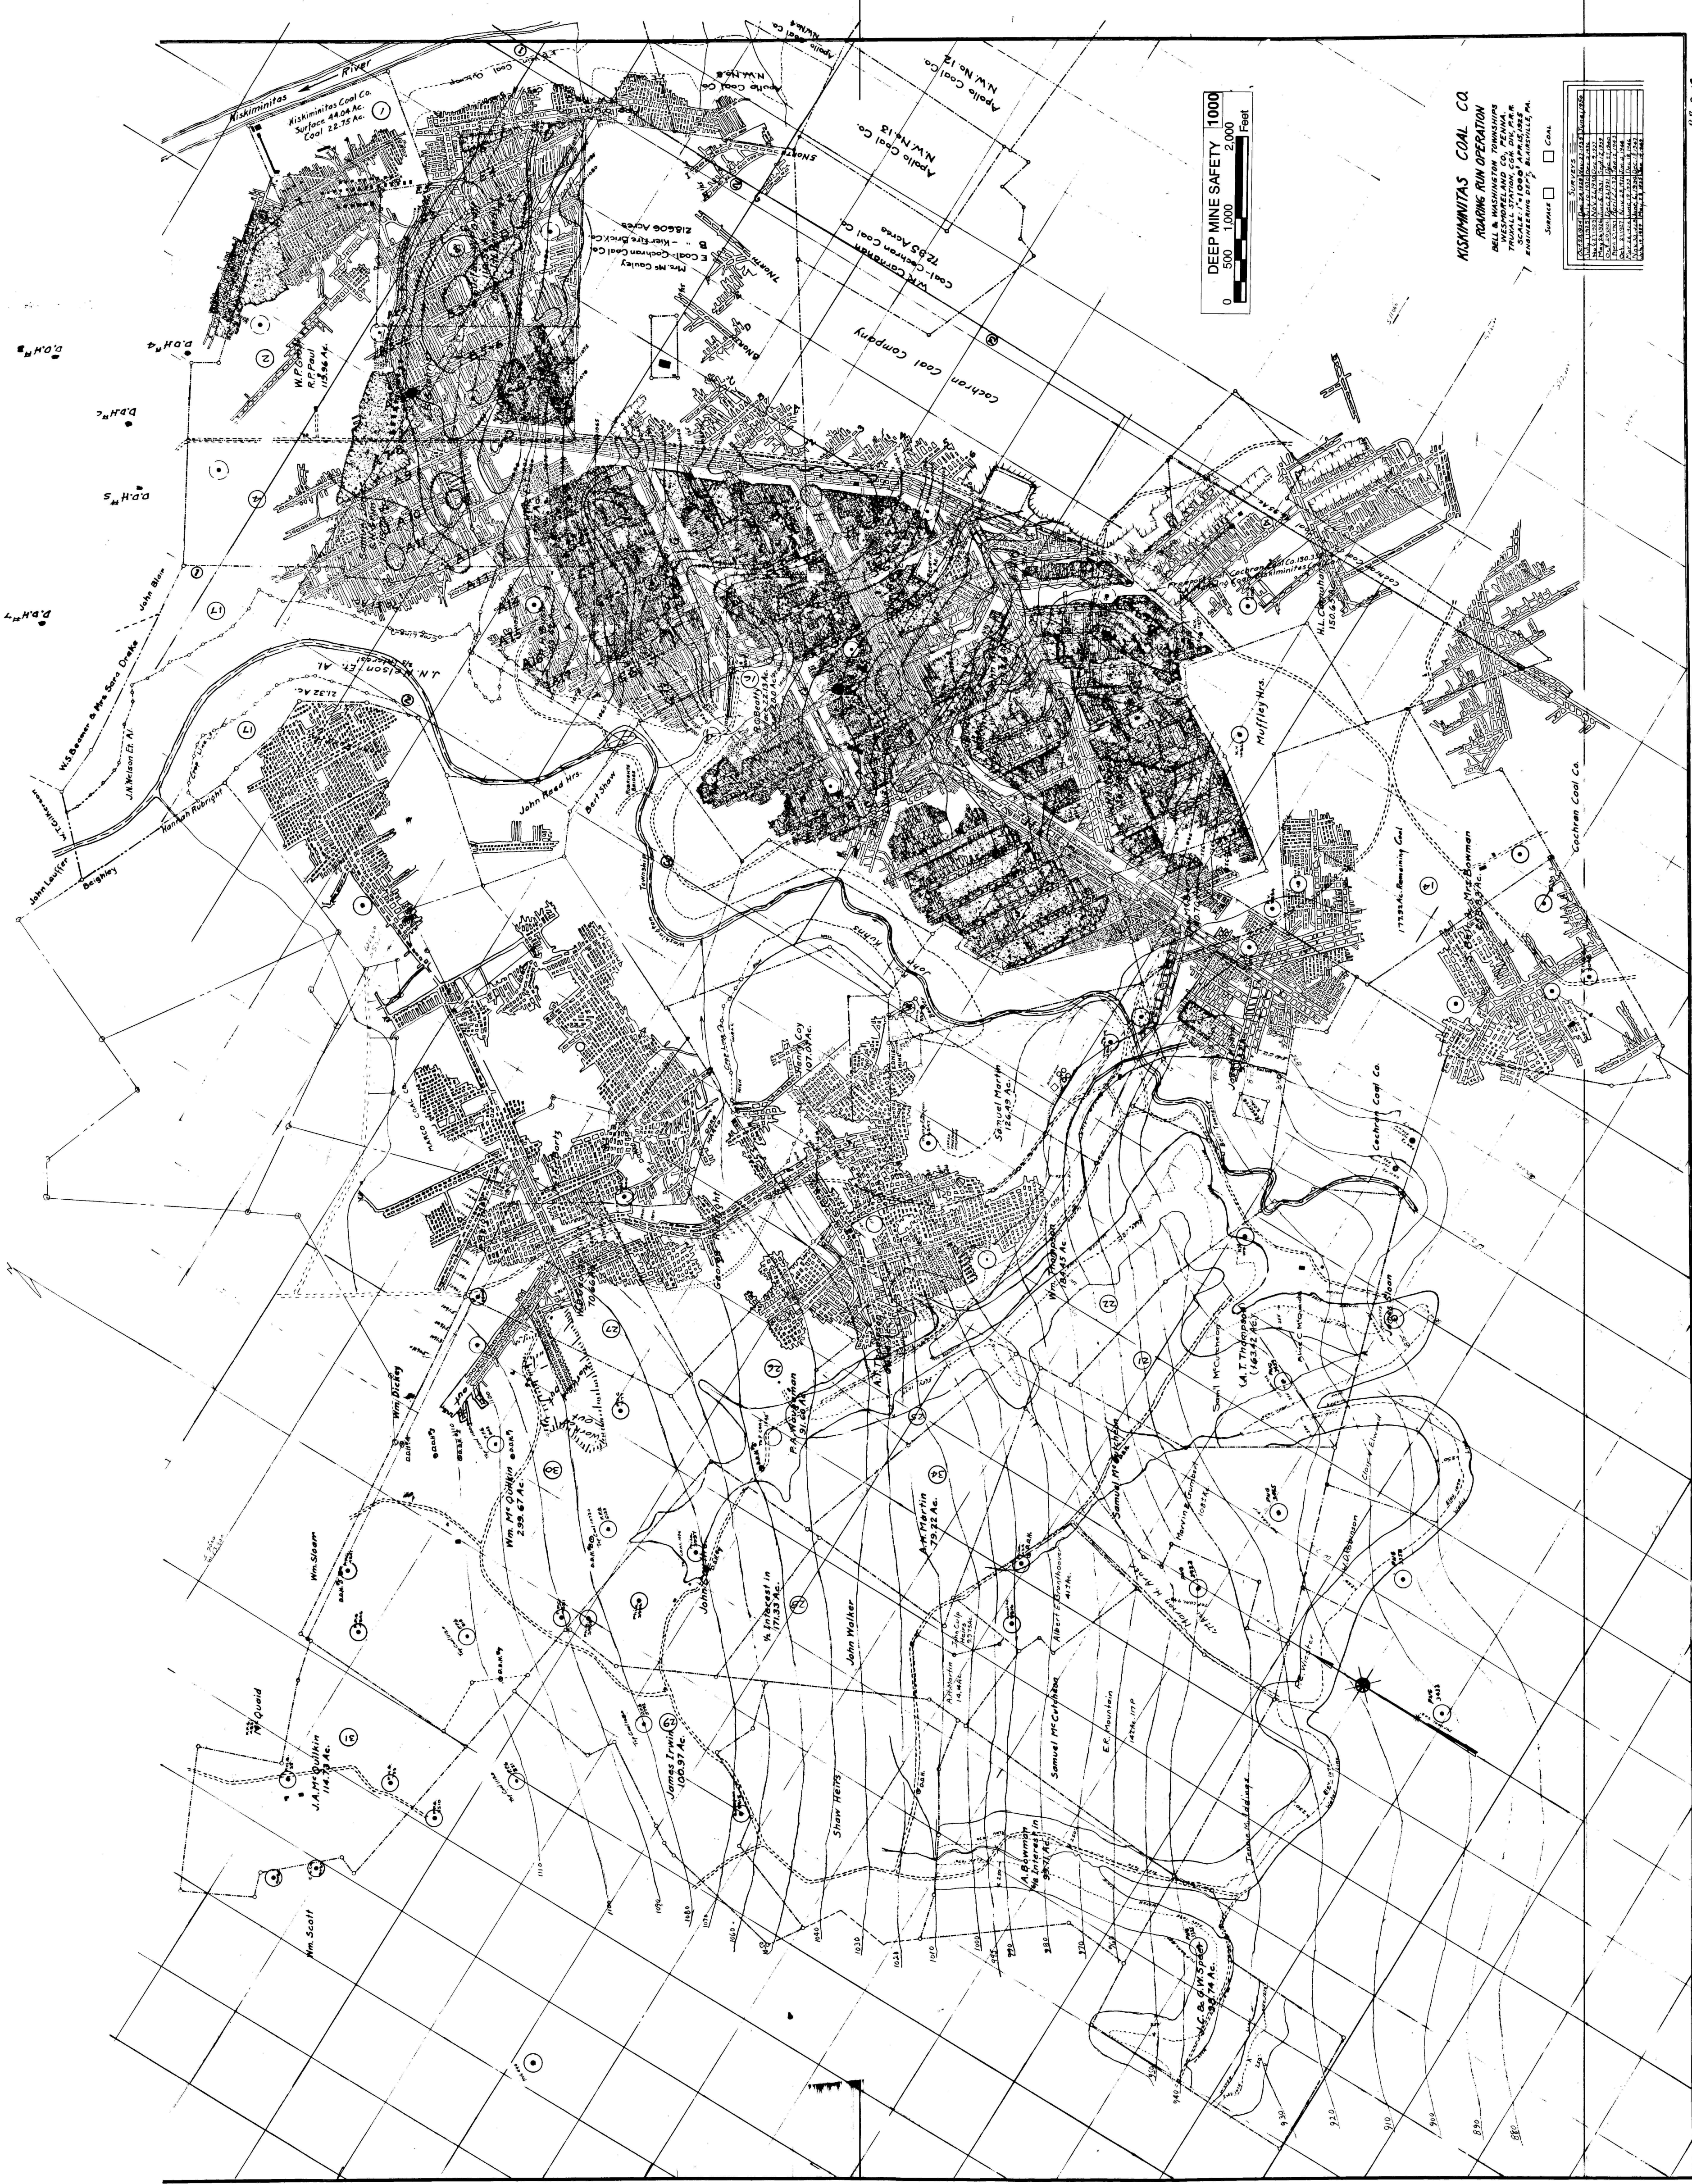

DEEP MINE SAFETY 1000
0 500 1000 2000
Feet

KISKIMINITAS COAL CO.
ROARING RUN OPERATION
DELL & WASHINGTON TOWNSHIP
W. VIRGINIA
SCALE 1" = 1000' APPROXIMATE
ENGINEERING DEPT. BLAINVILLE, PA.

SOURCES	
U.S. GEOLOGICAL SURVEY	1898
U.S. GEOLOGICAL SURVEY	1900
