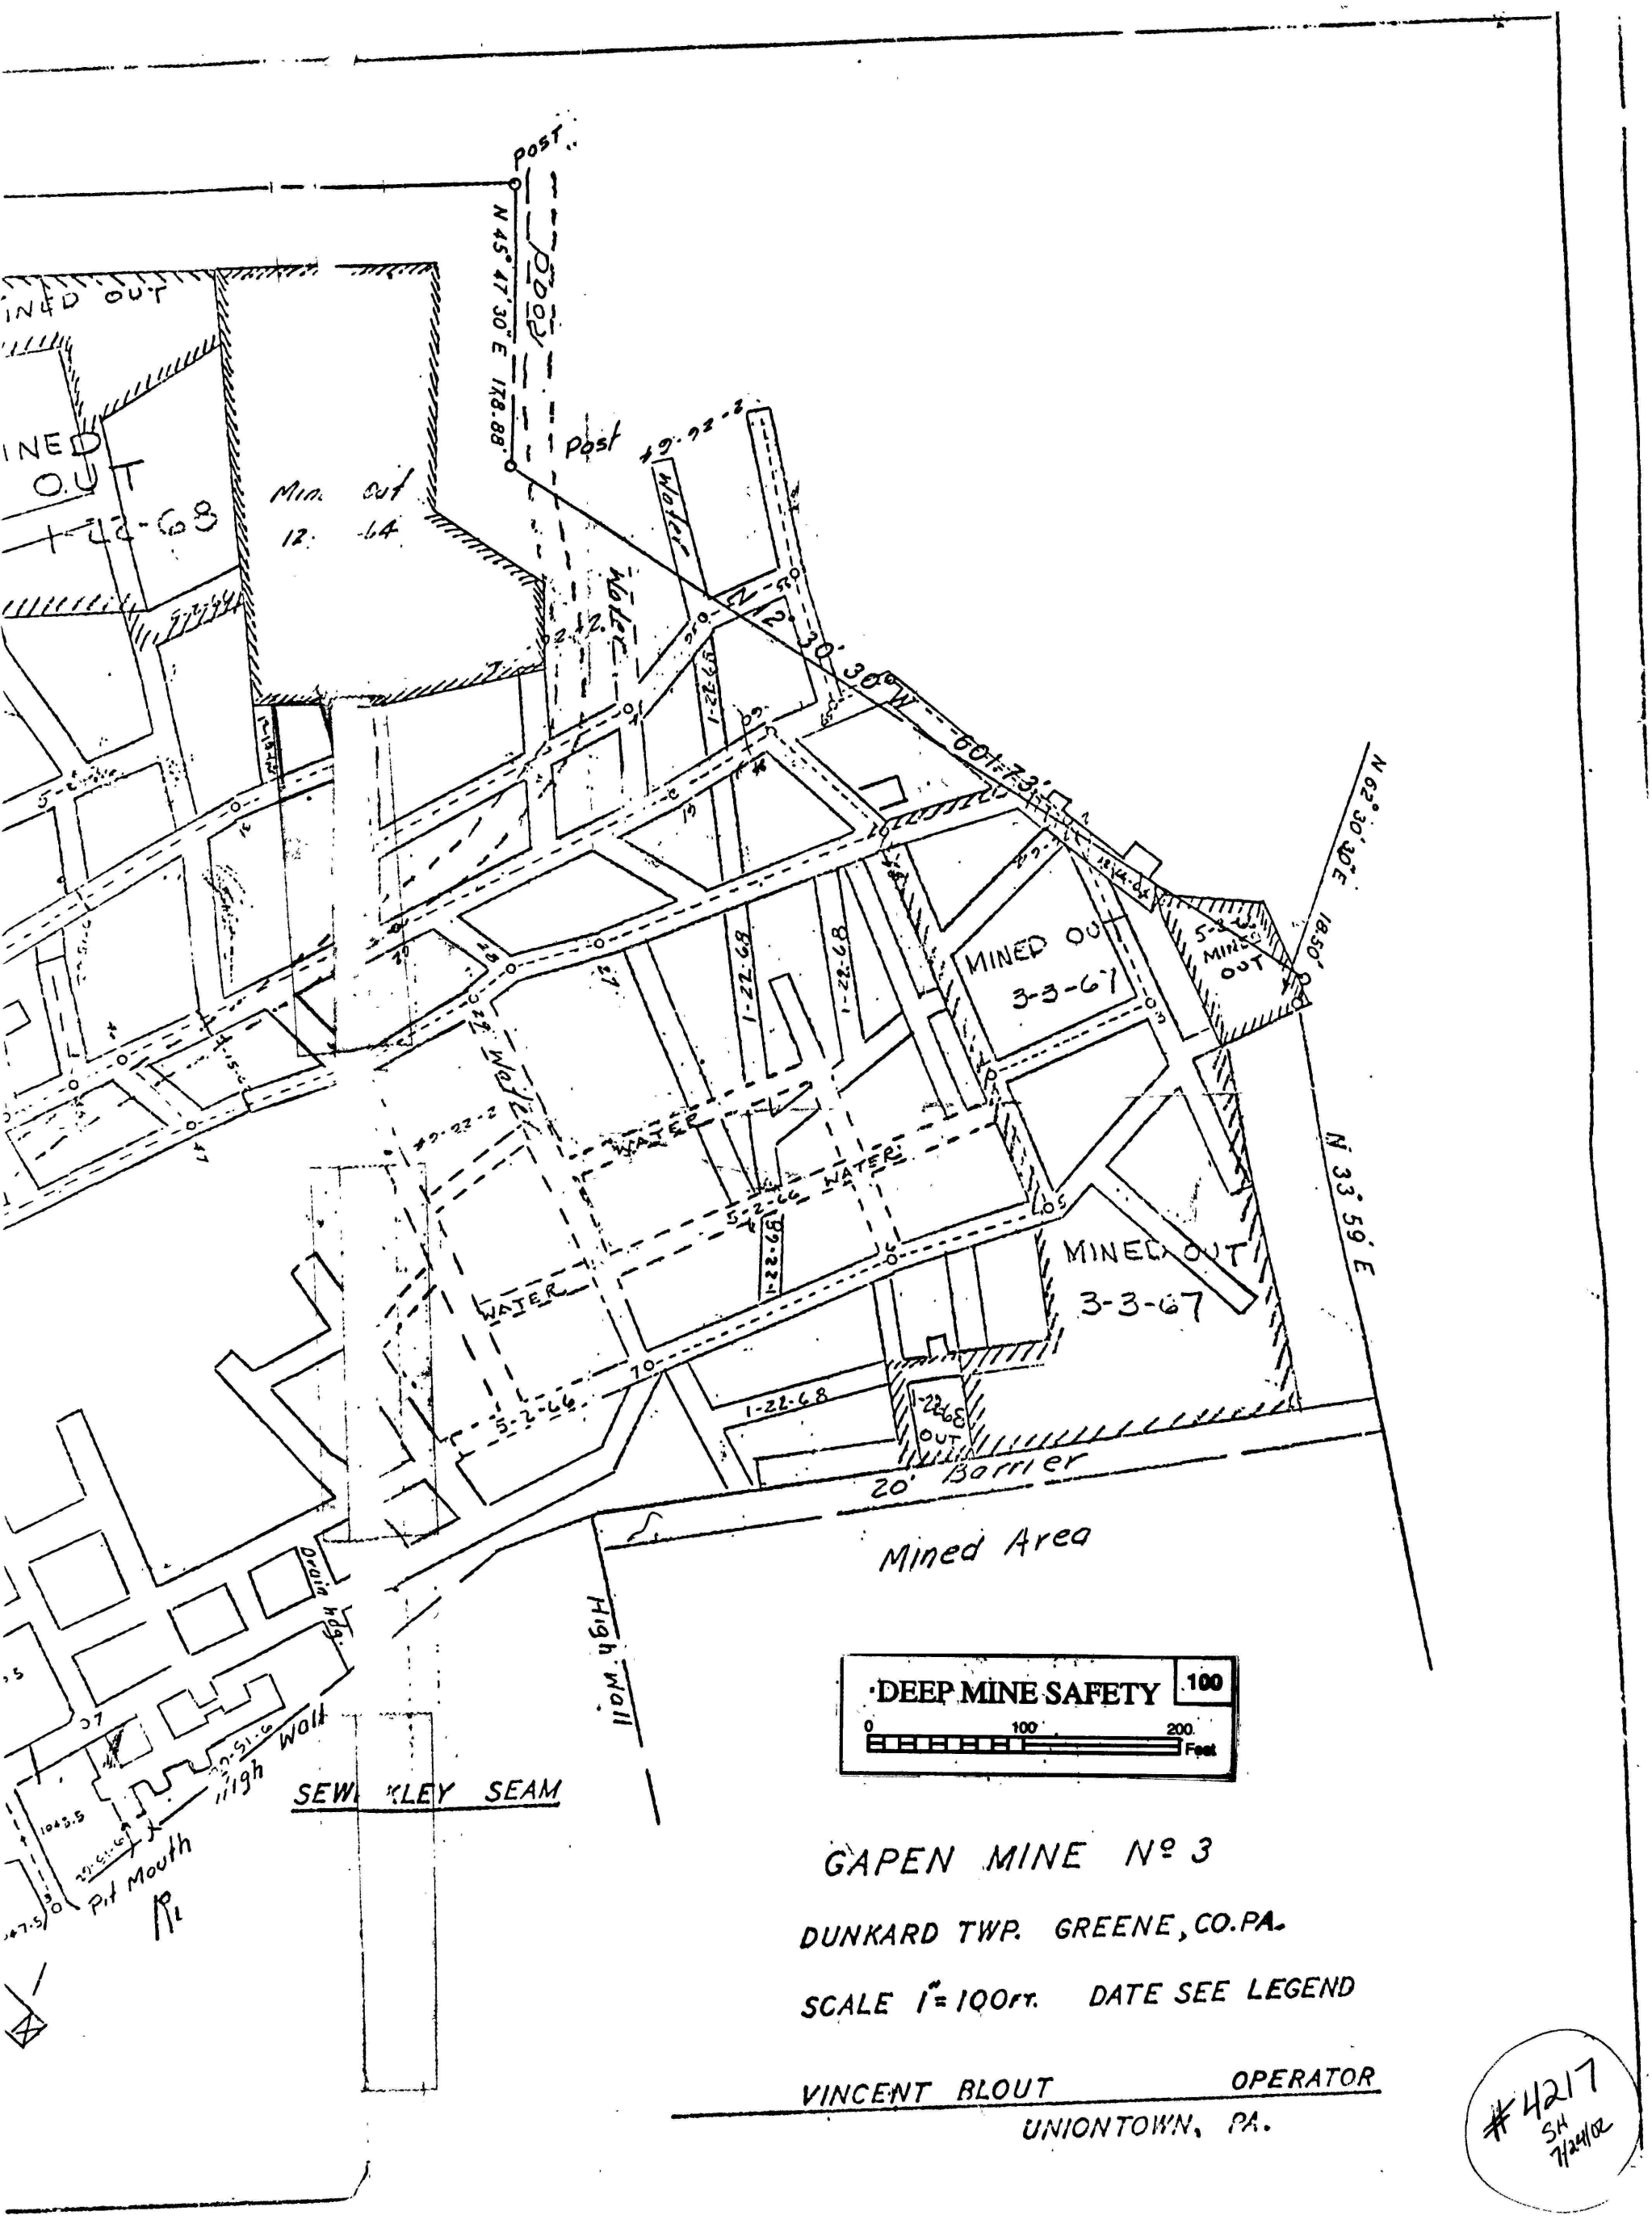

GAPEN MINE Nº 3

DUNKARD TWP. GREENE, CO. PA.

SCALE 1" = 100 ft. DATE SEE LEGEND

VINCENT BLOUT OPERATOR

UNIONTOWN, PA.

#4217
SH
7/24/02