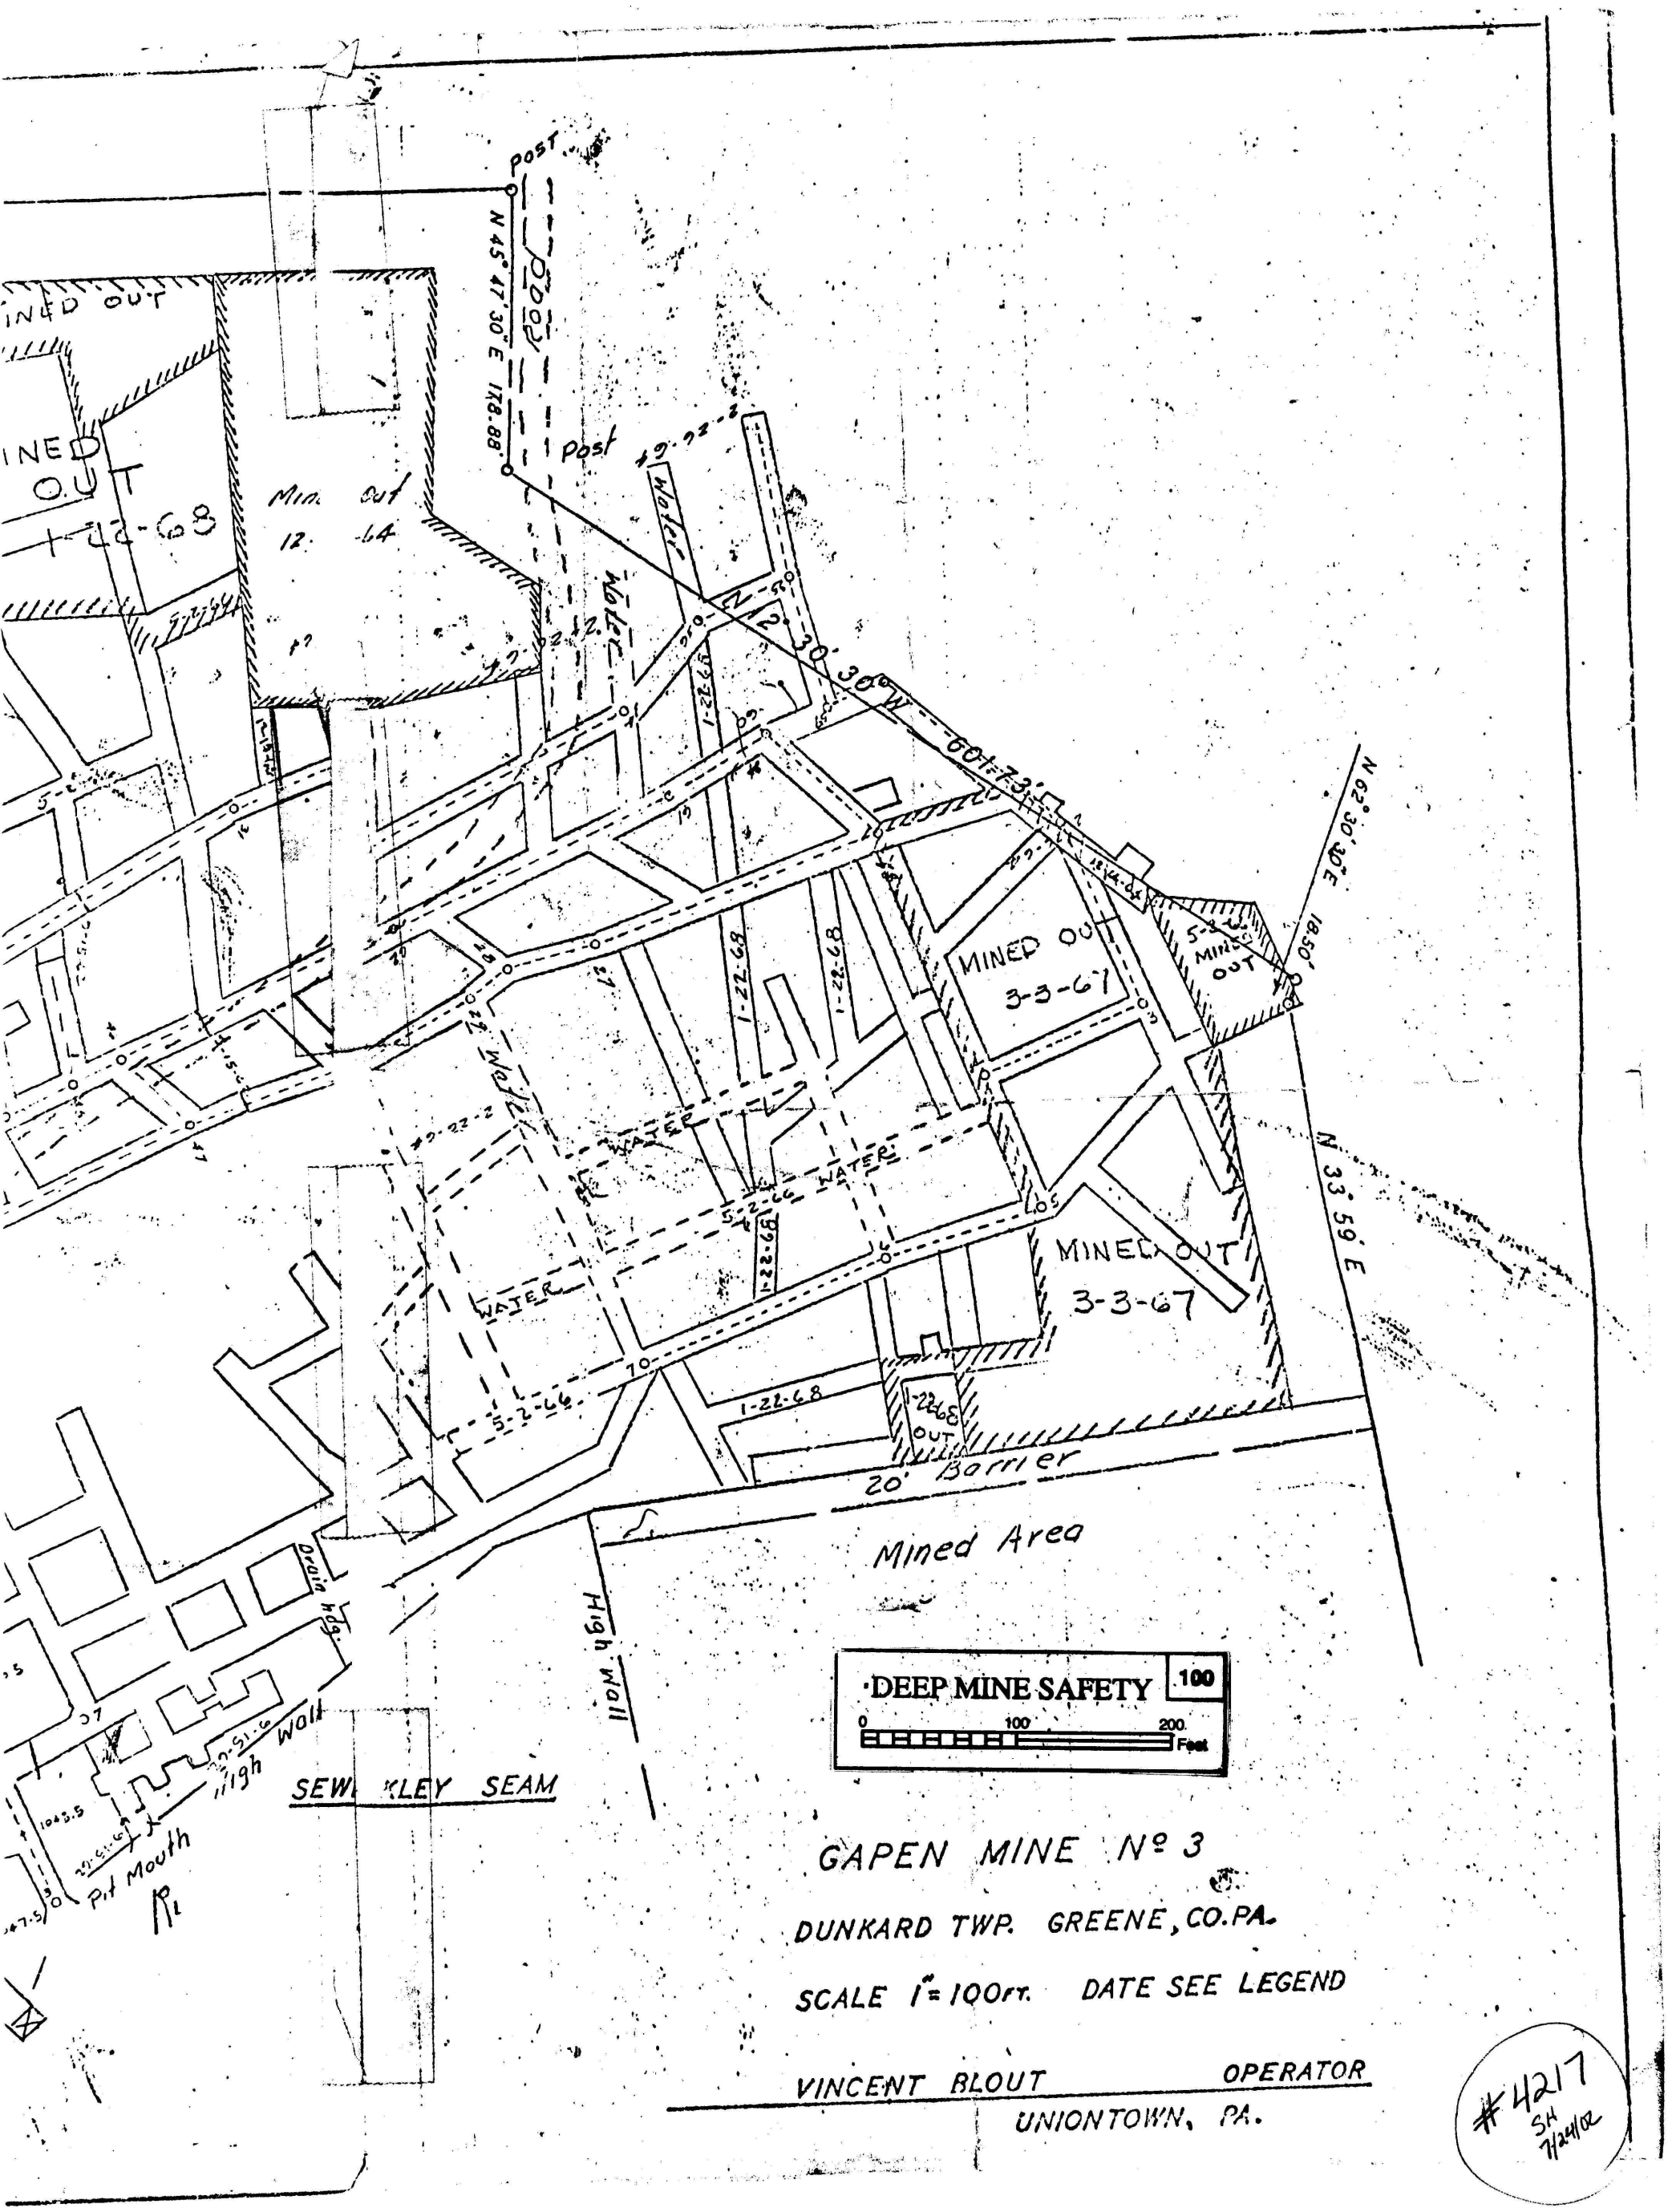
MINED OUT
1-22-68
Min. Out
12-64
POST
N 45° 47' 30" E 178.88'
Road
Post
Water
N 12° 30' 30" W 601.73'
1-22-68
MINED OUT
3-3-67
N 62° 30' 30" E 185.0'
N 33° 59' E
WATER
5-2-66
MINED OUT
3-3-67
20' Barrier
Mined Area
Drain Hdg.
High Wall
SEWICKLEY SEAM
Pit Mouth
DEEP MINE SAFETY
100
0
100
200
Feet
GAPEN MINE Nº 3
DUNKARD TWP. GREENE, CO. PA.
SCALE 1" = 100 ft. DATE SEE LEGEND
VINCENT BLOUT OPERATOR
UNIONTOWN, PA.
#4217
SH
7/24/02