


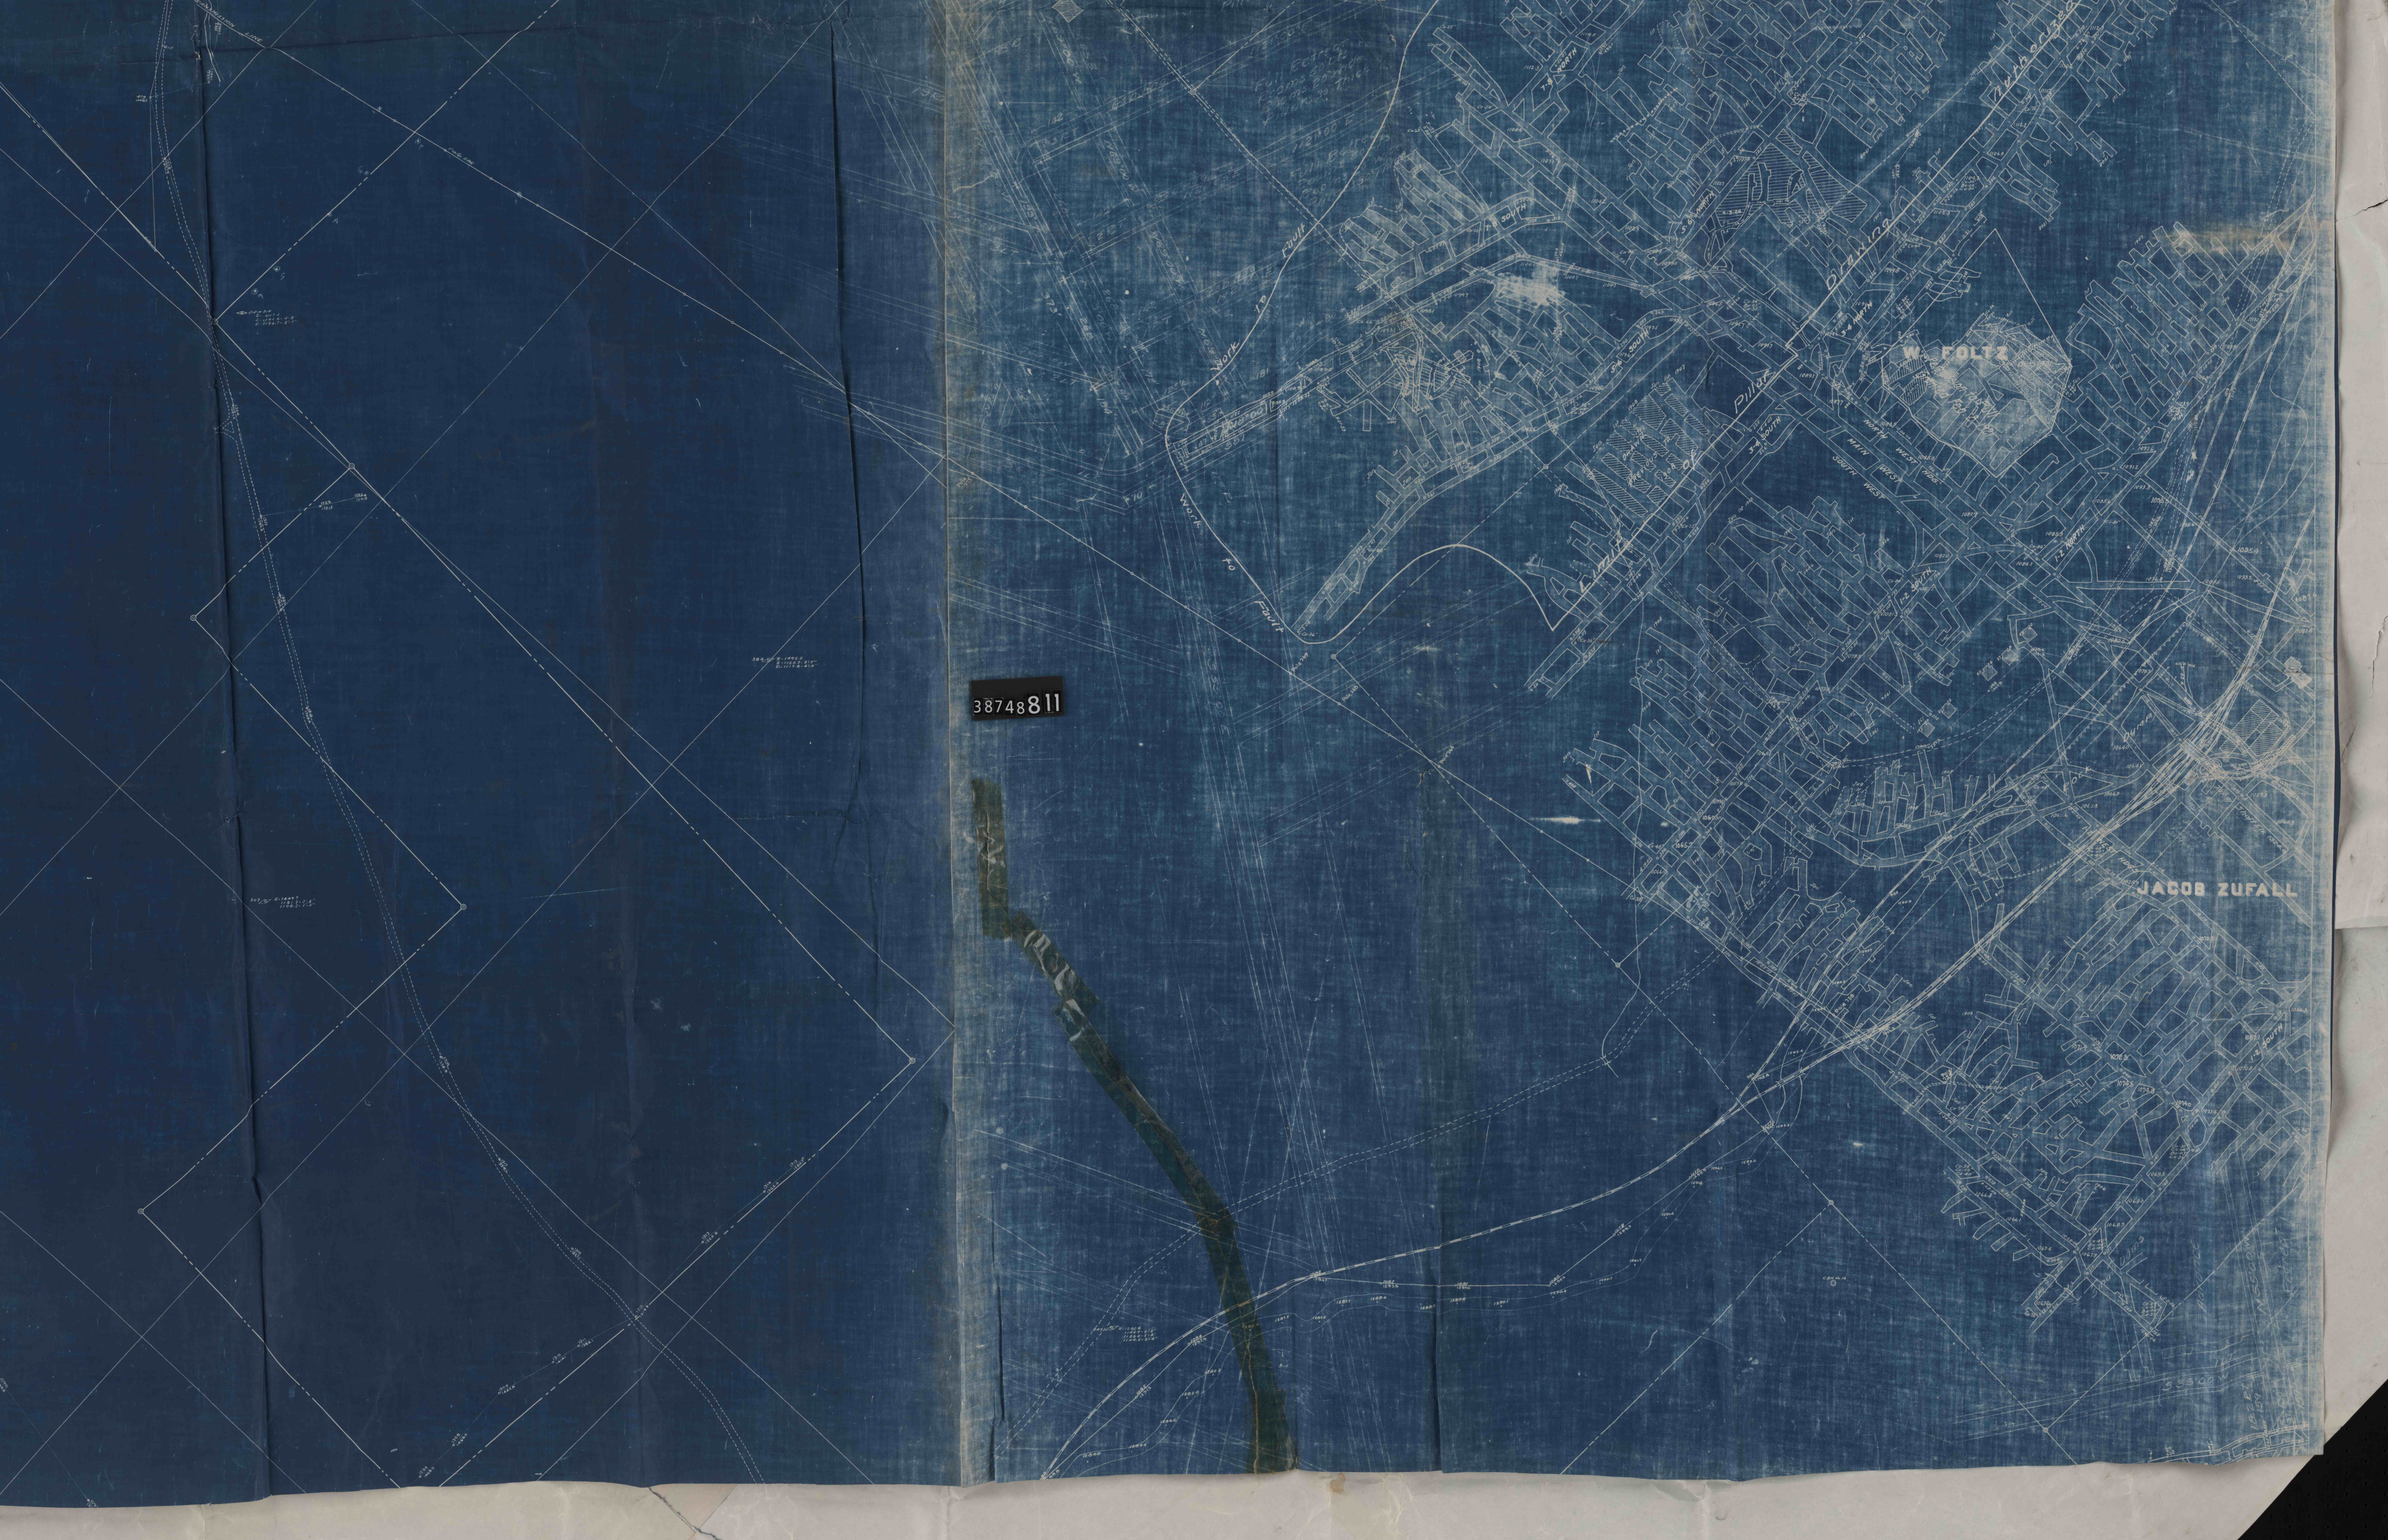

3874811

JACOB ZUFALL