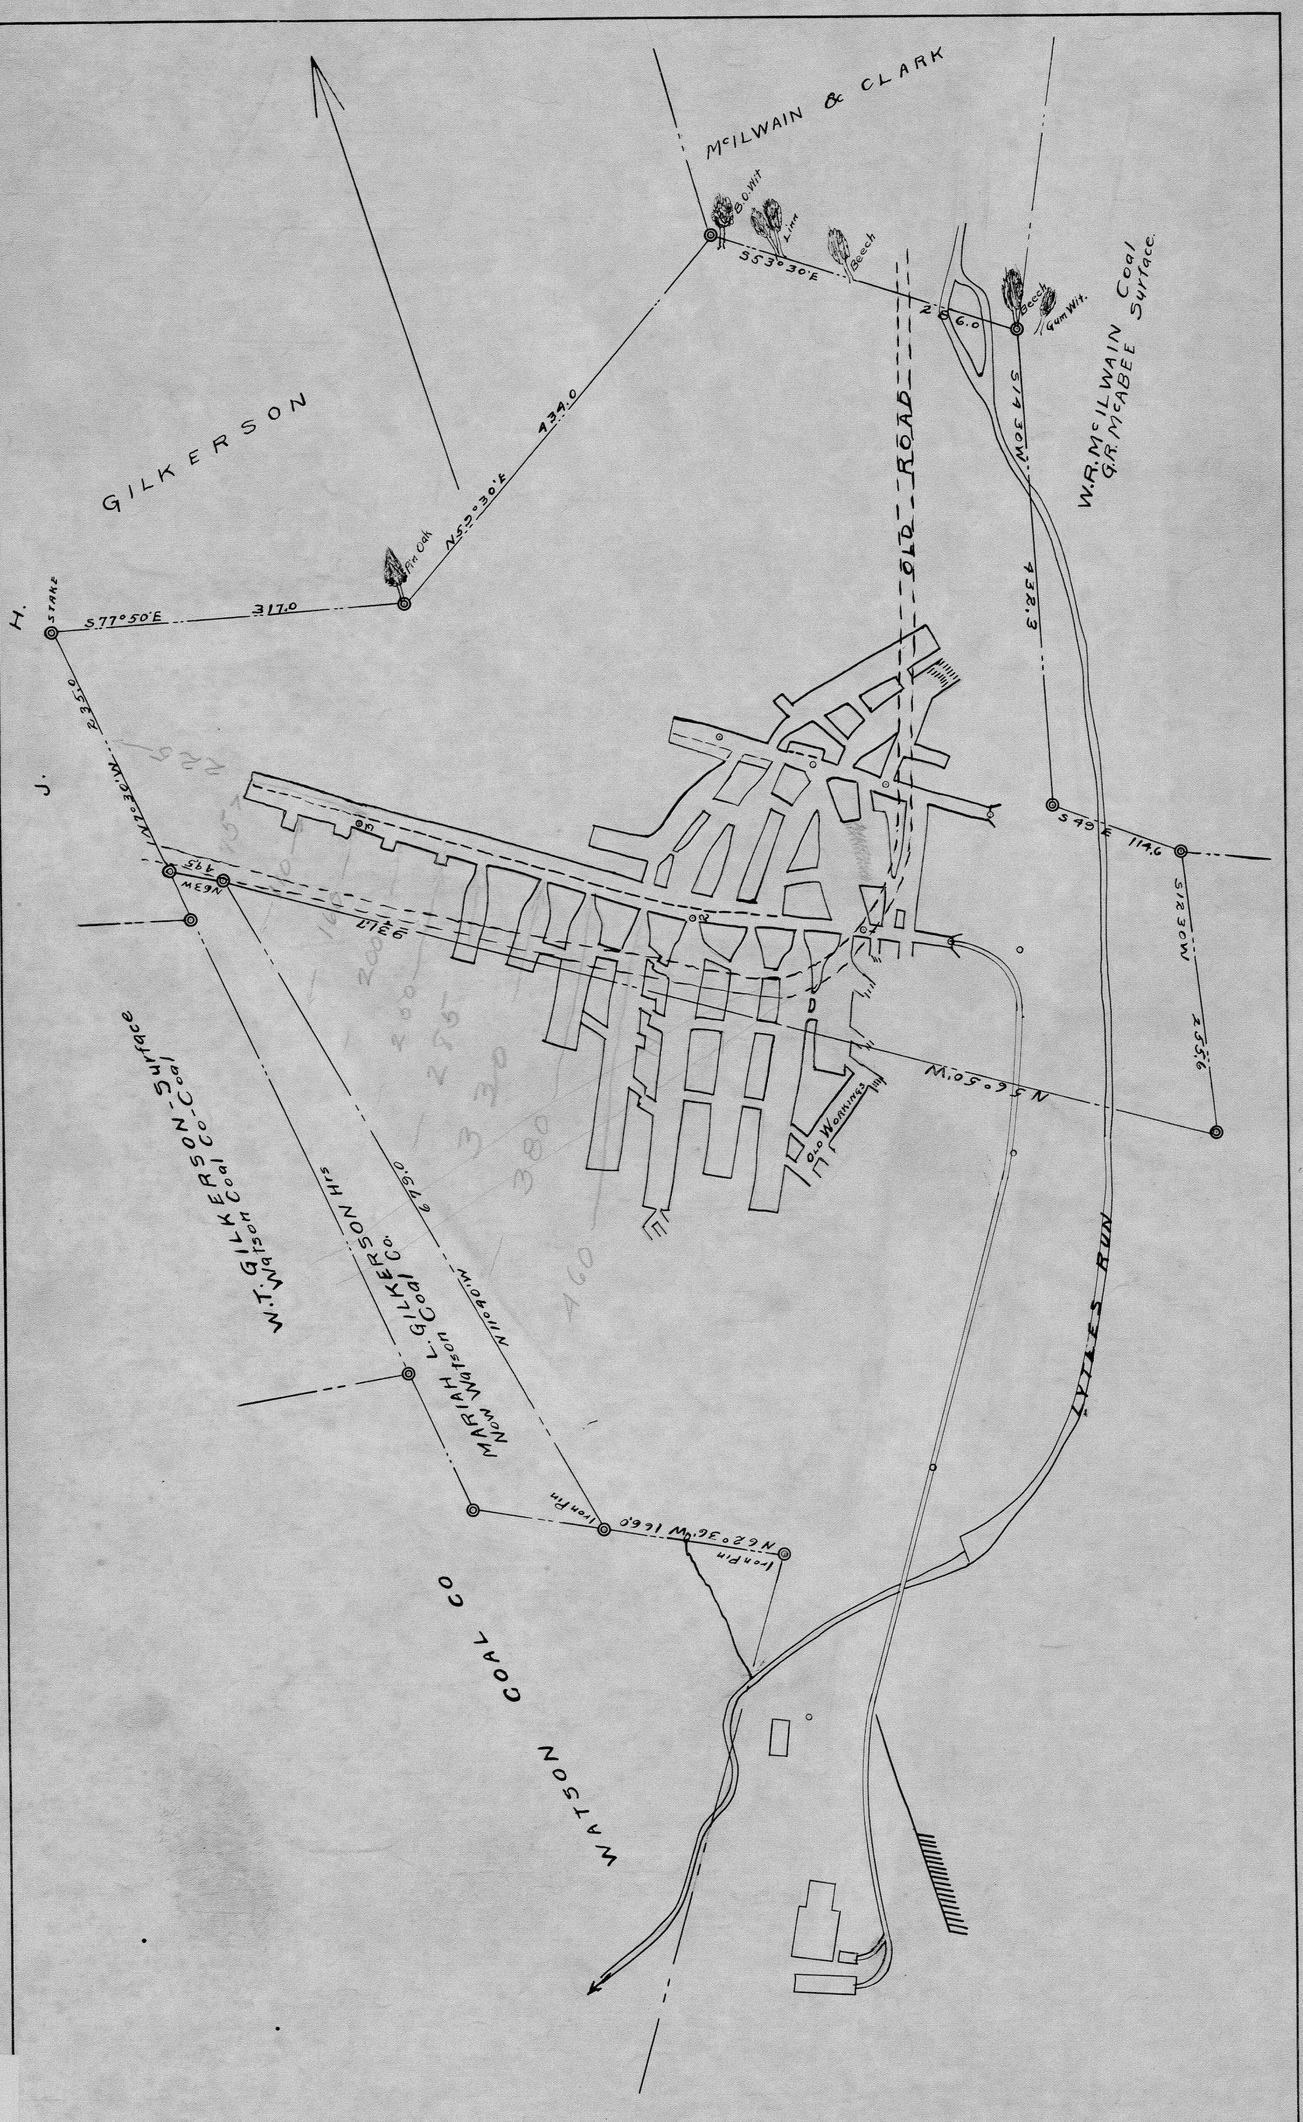


G.R. McABEE POWDER & OIL CO

MINE

Tunnelton Indiana County Penna.

Scale 1" = 100' June 13 1919 Albert Smith CE
Saltsburg Pa.

4226Q5 Tun. 5924