

4234
MISC 8433

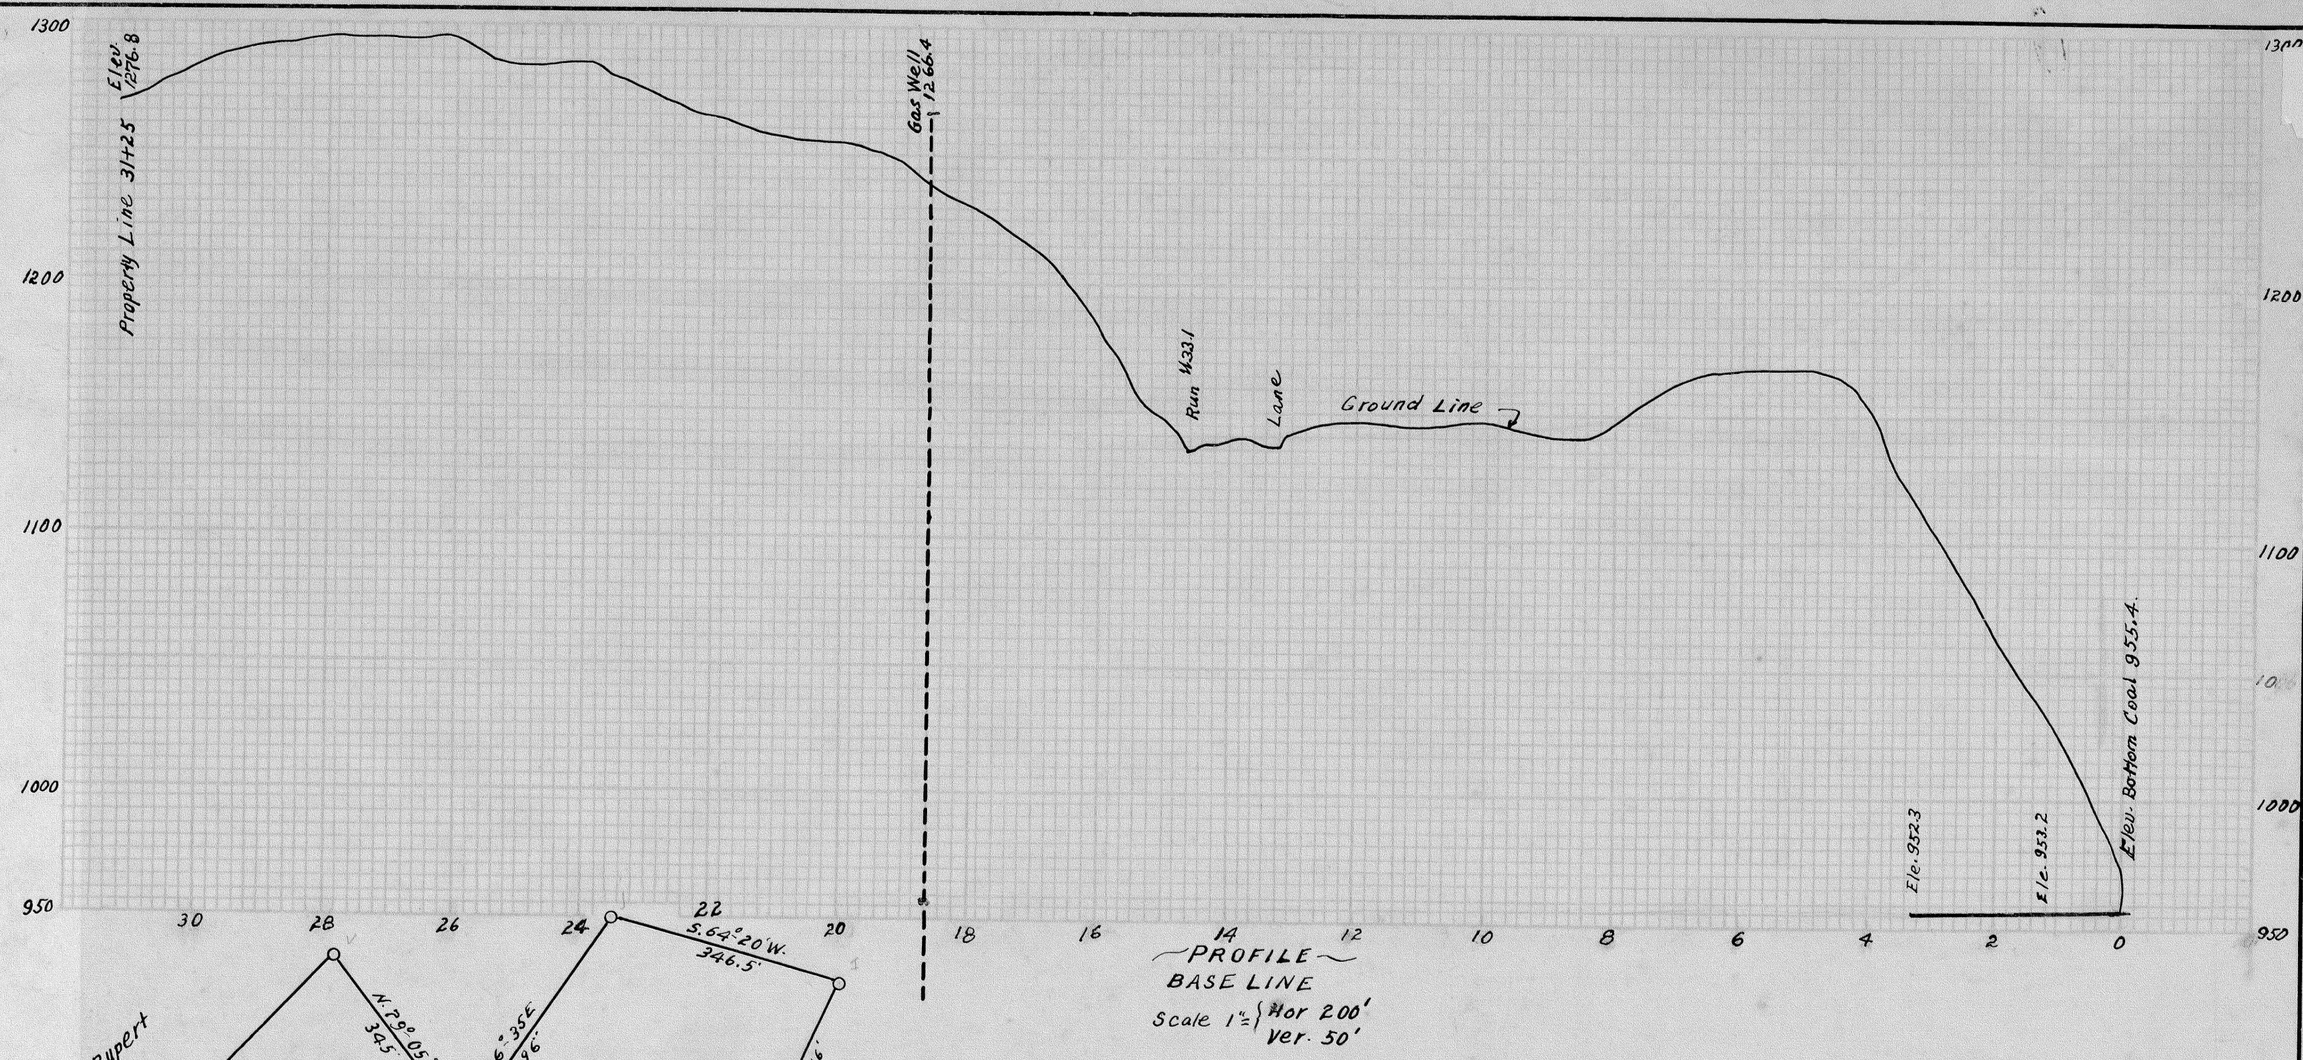

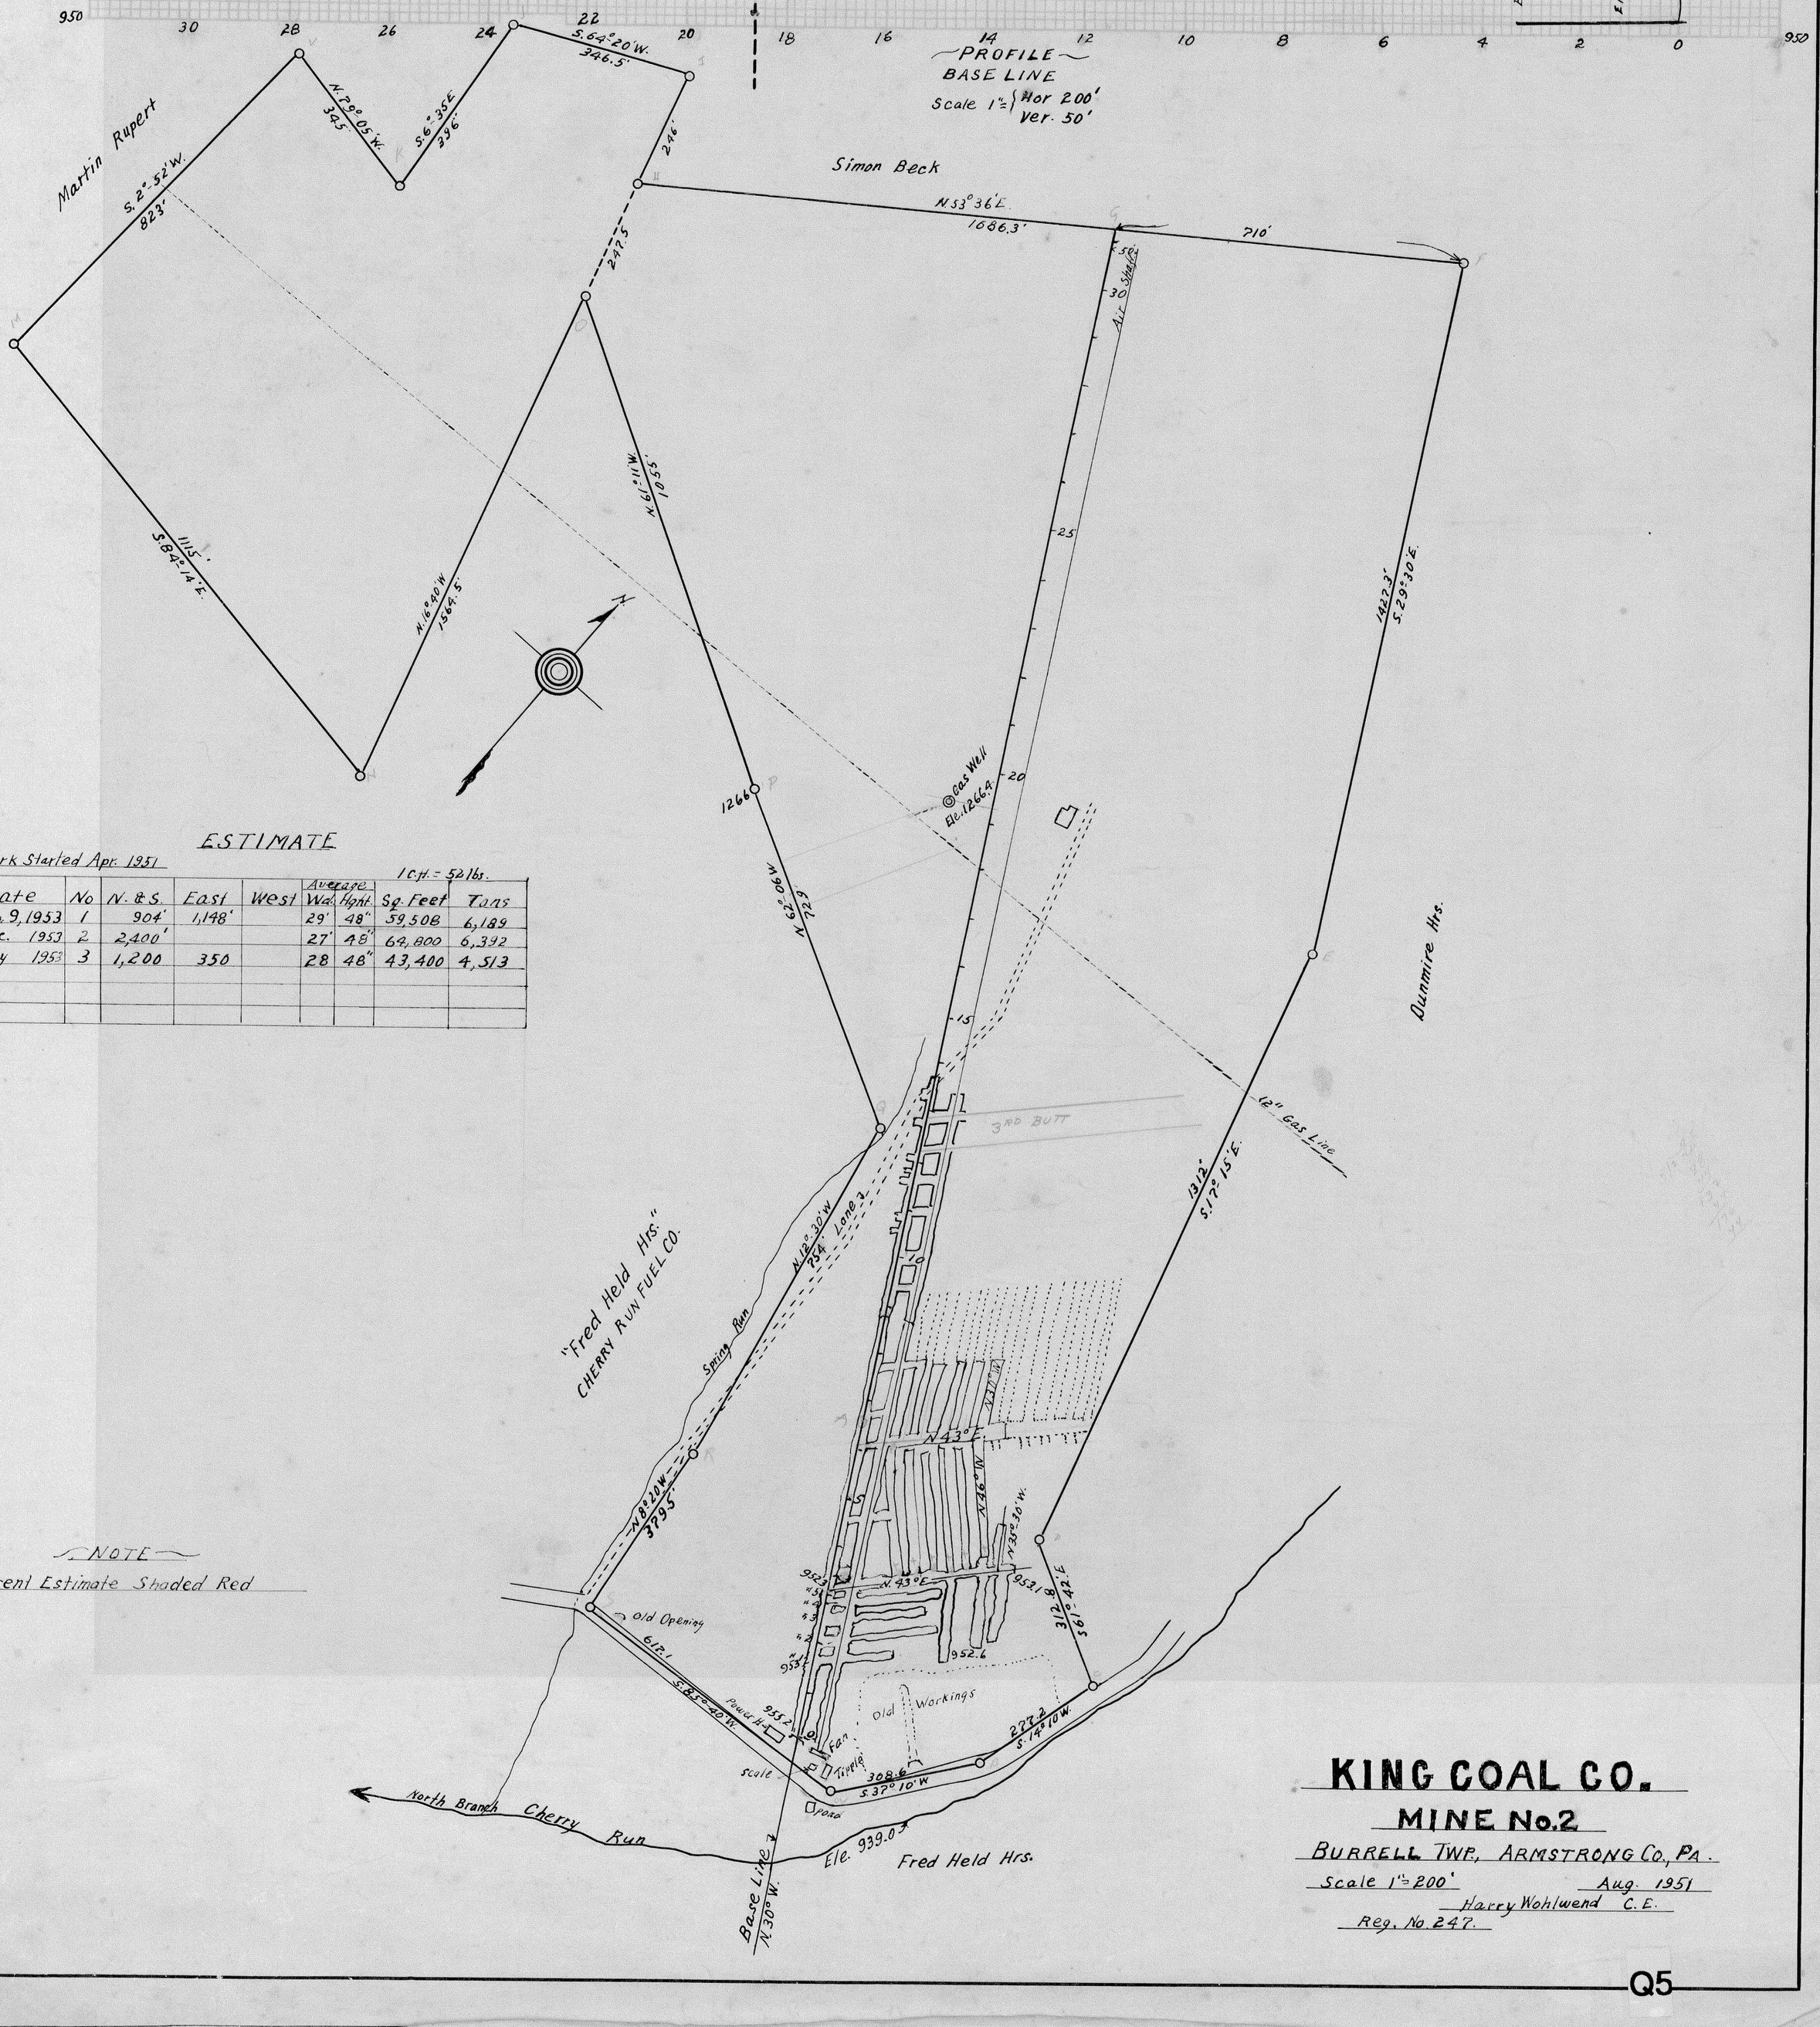

ESTIMATE

Work Started Apr. 1951

1 C.f. = 52 lbs.

Date	No	N. & S.	East	West	Average Wid.	Average Hght.	Sq. Feet	Tons
Feb. 9, 1953	1	904'	1,148'		29'	48"	59,508	6,189
Dec. 1953	2	2,400'			27'	48"	64,800	6,392
May 1953	3	1,200	350		28	48"	43,400	4,513

NOTE
Present Estimate Shaded Red

KING COAL CO.
MINE No. 2

BURRELL TWP., ARMSTRONG CO., PA.

Scale 1" = 200' Aug. 1951

Harry Wohlwend C. E.

Reg. No. 247.

MISC 5354
Q5