


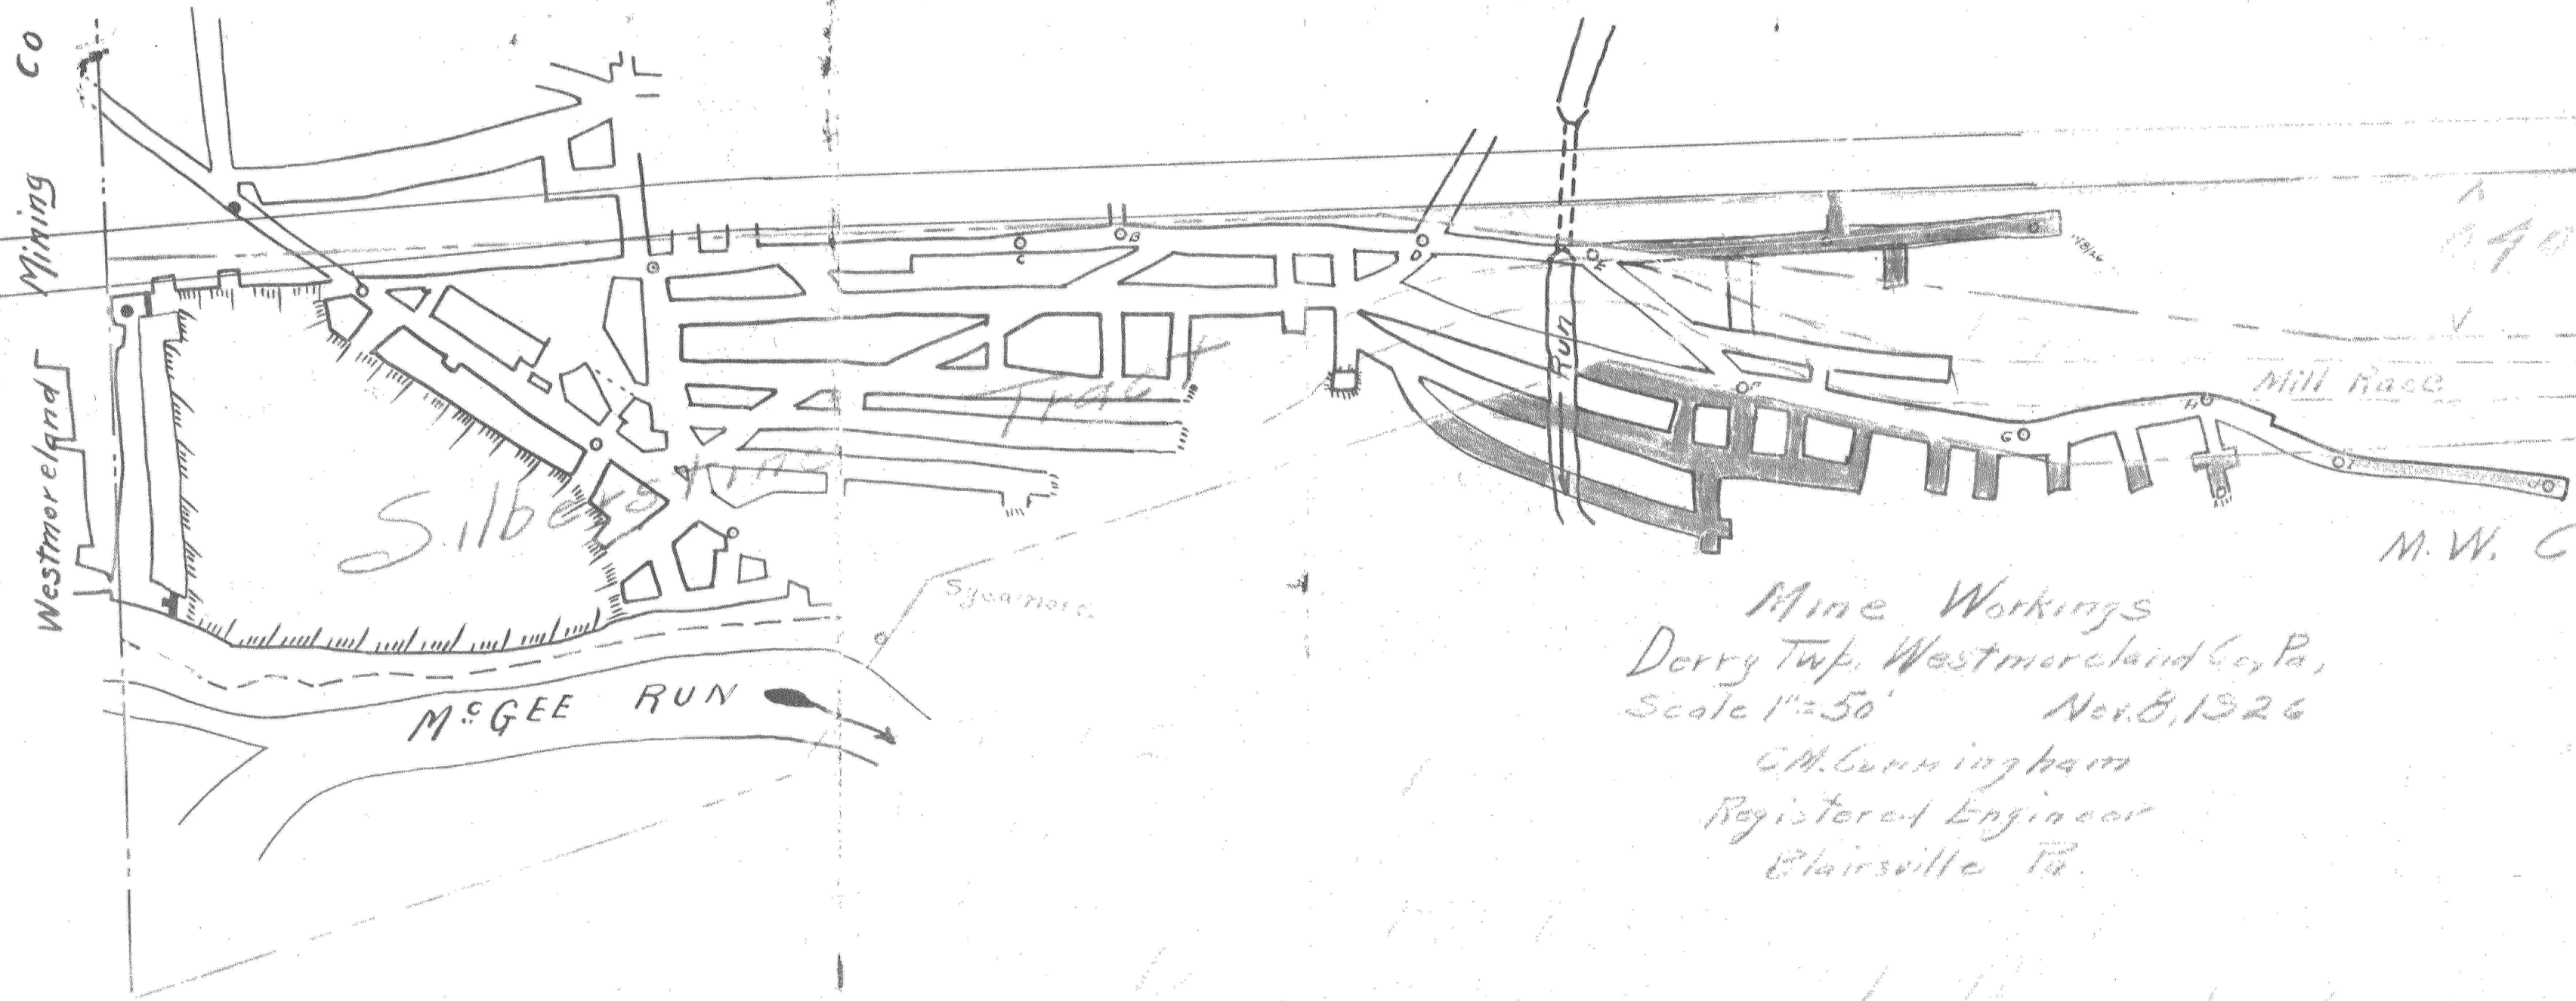

Mine Workings
Derry Twp. Westmoreland Co, Pa.
Scale 1"=50' Nov. 8, 1926
C.M. Cunningham
Registered Engineer
Blairsville Pa.

040A
M.W. Currow
Red Oak
Mill Race
