


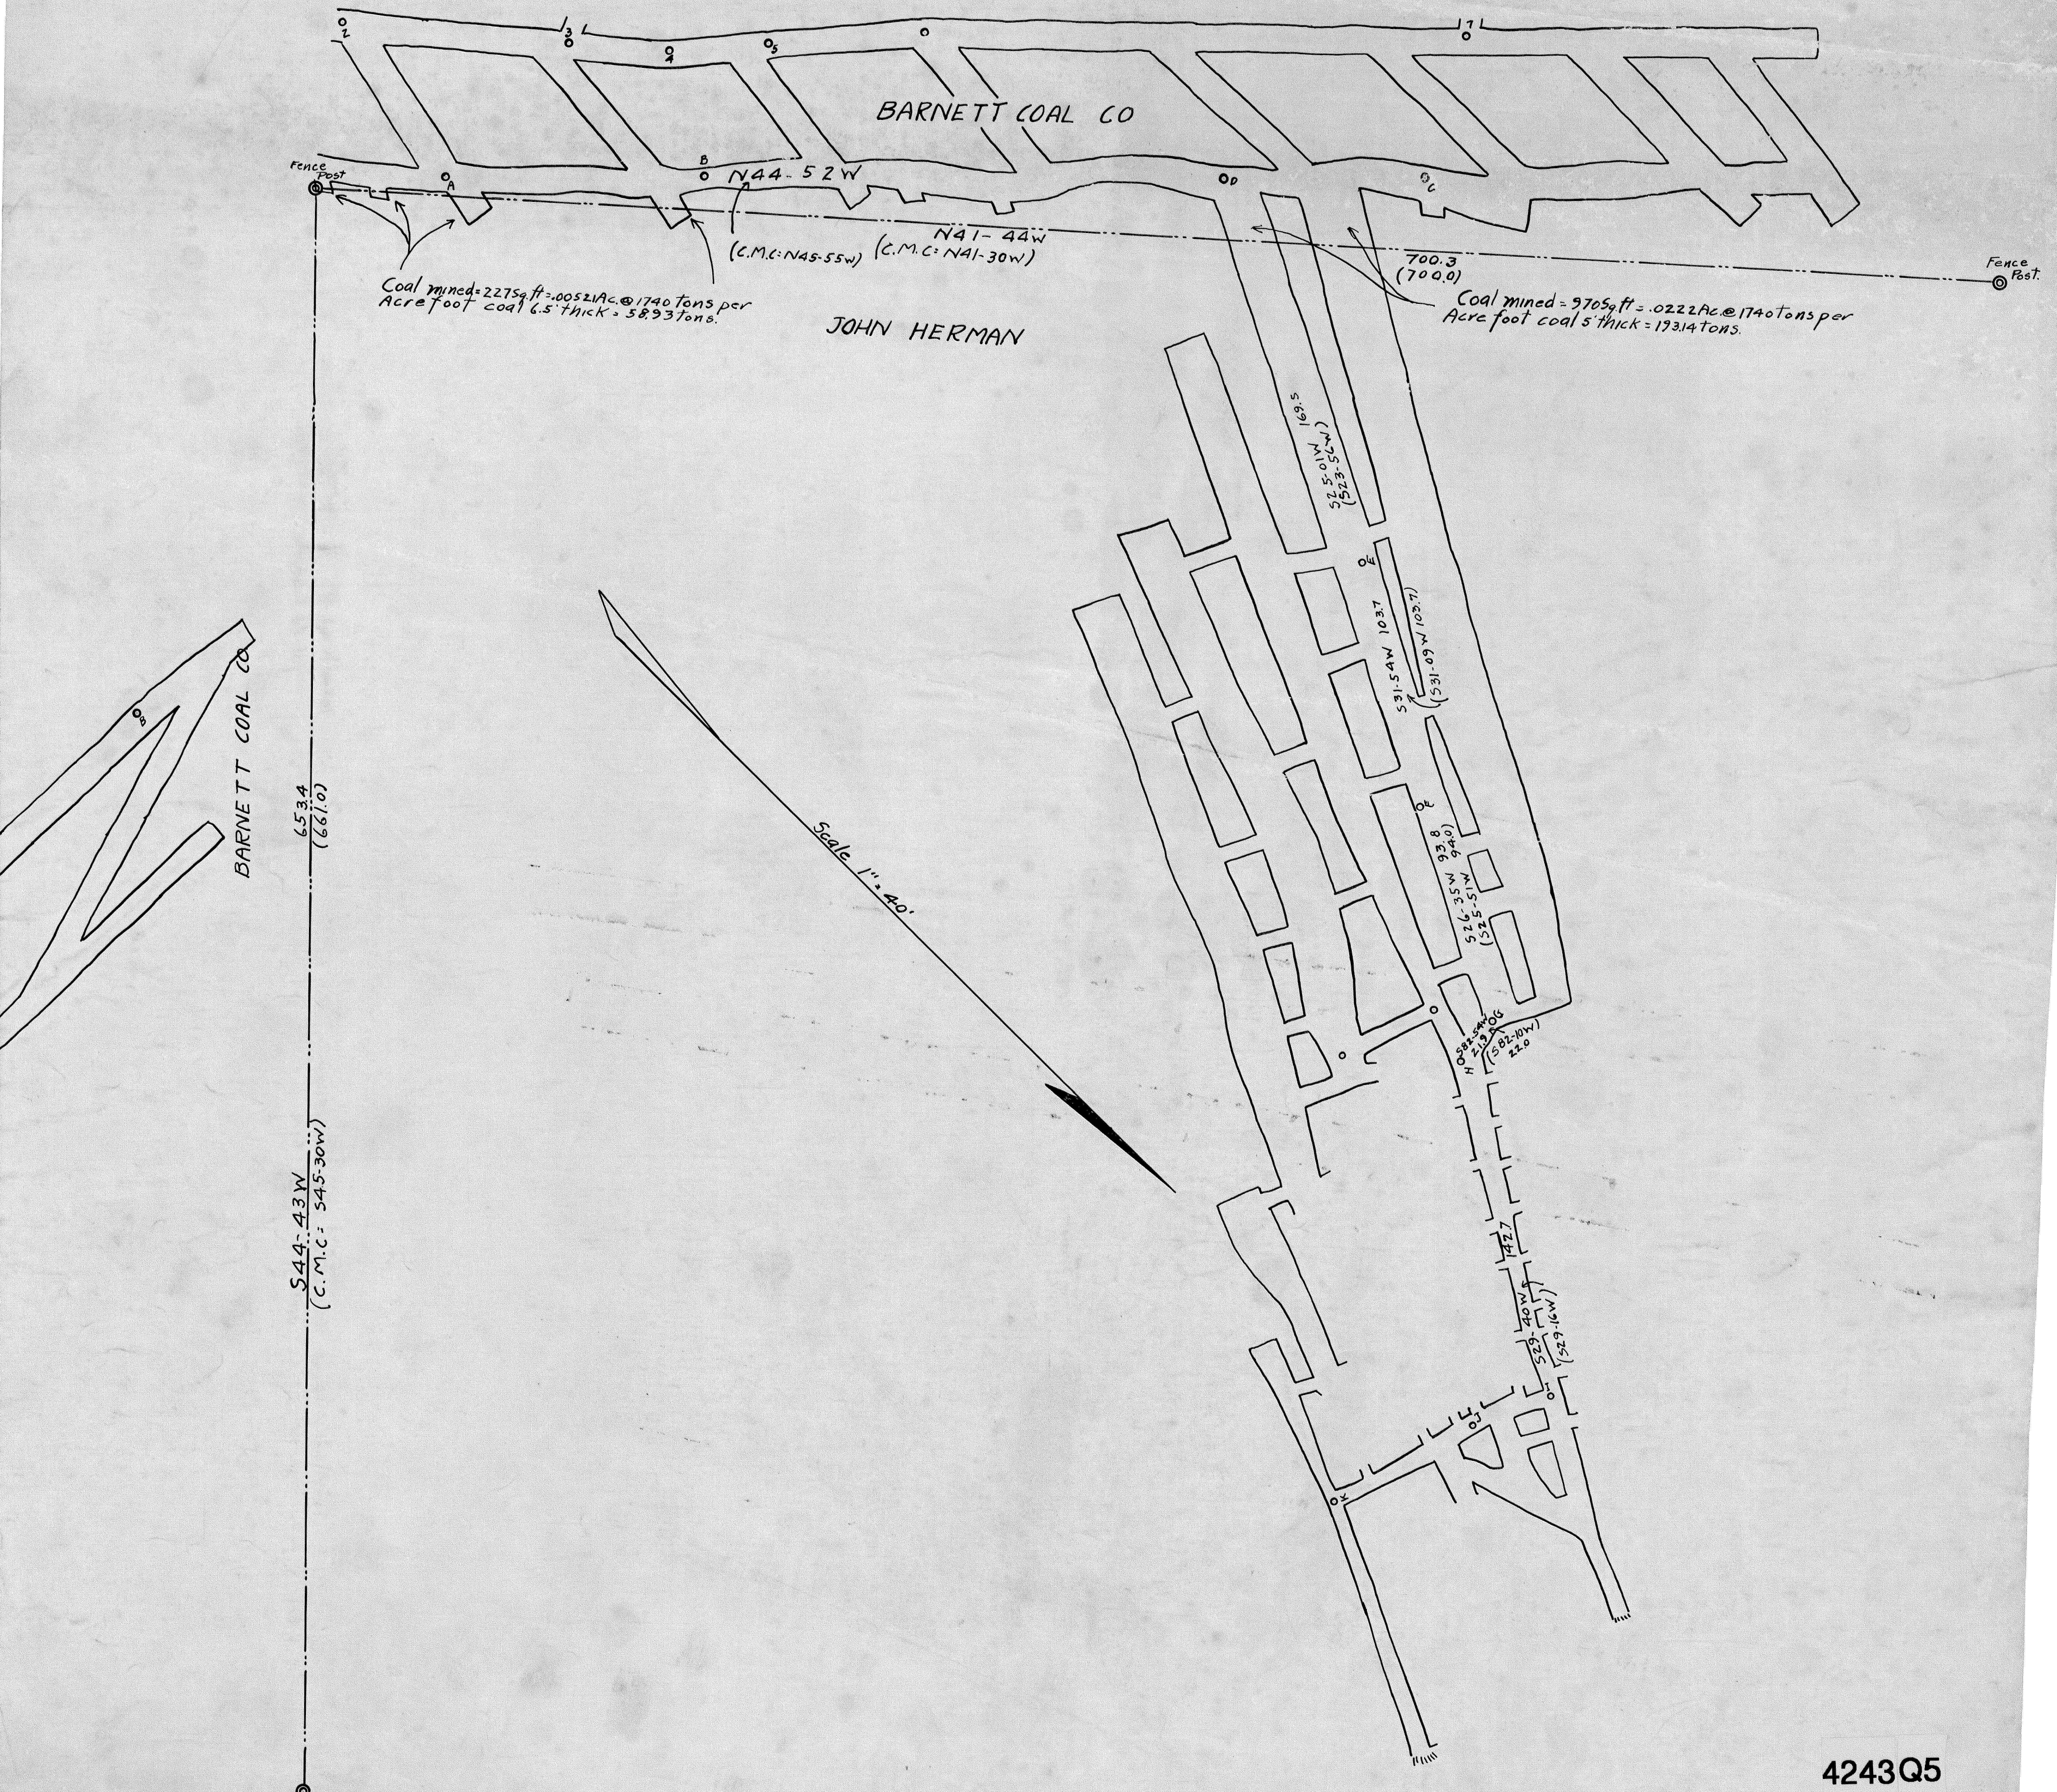

Fence Post

Coal mined = 2275₉ ft = .00521 Ac. @ 1740 tons per
Acre foot coal 6.5' thick = 58,933 tons.

JOHN HERMAN

700.3
(700.0)

Coal mined = 9705₉ ft = .0222 Ac. @ 1740 tons per
Acre foot coal 5' thick = 19,314 tons.

Fence Post

BARNETT COAL CO

653.4
(661.0)

S44-43W
(C.M.C. = 545-30W)

Scale 1" = 40'

S25-01W 169.5
(523-55W)

S31-54W 103.7
(531-09W 103.7)

S26-35W 93.8
(525-51W)

S29-40W 142.7
(529-16W)

4243Q5

Bar 8401