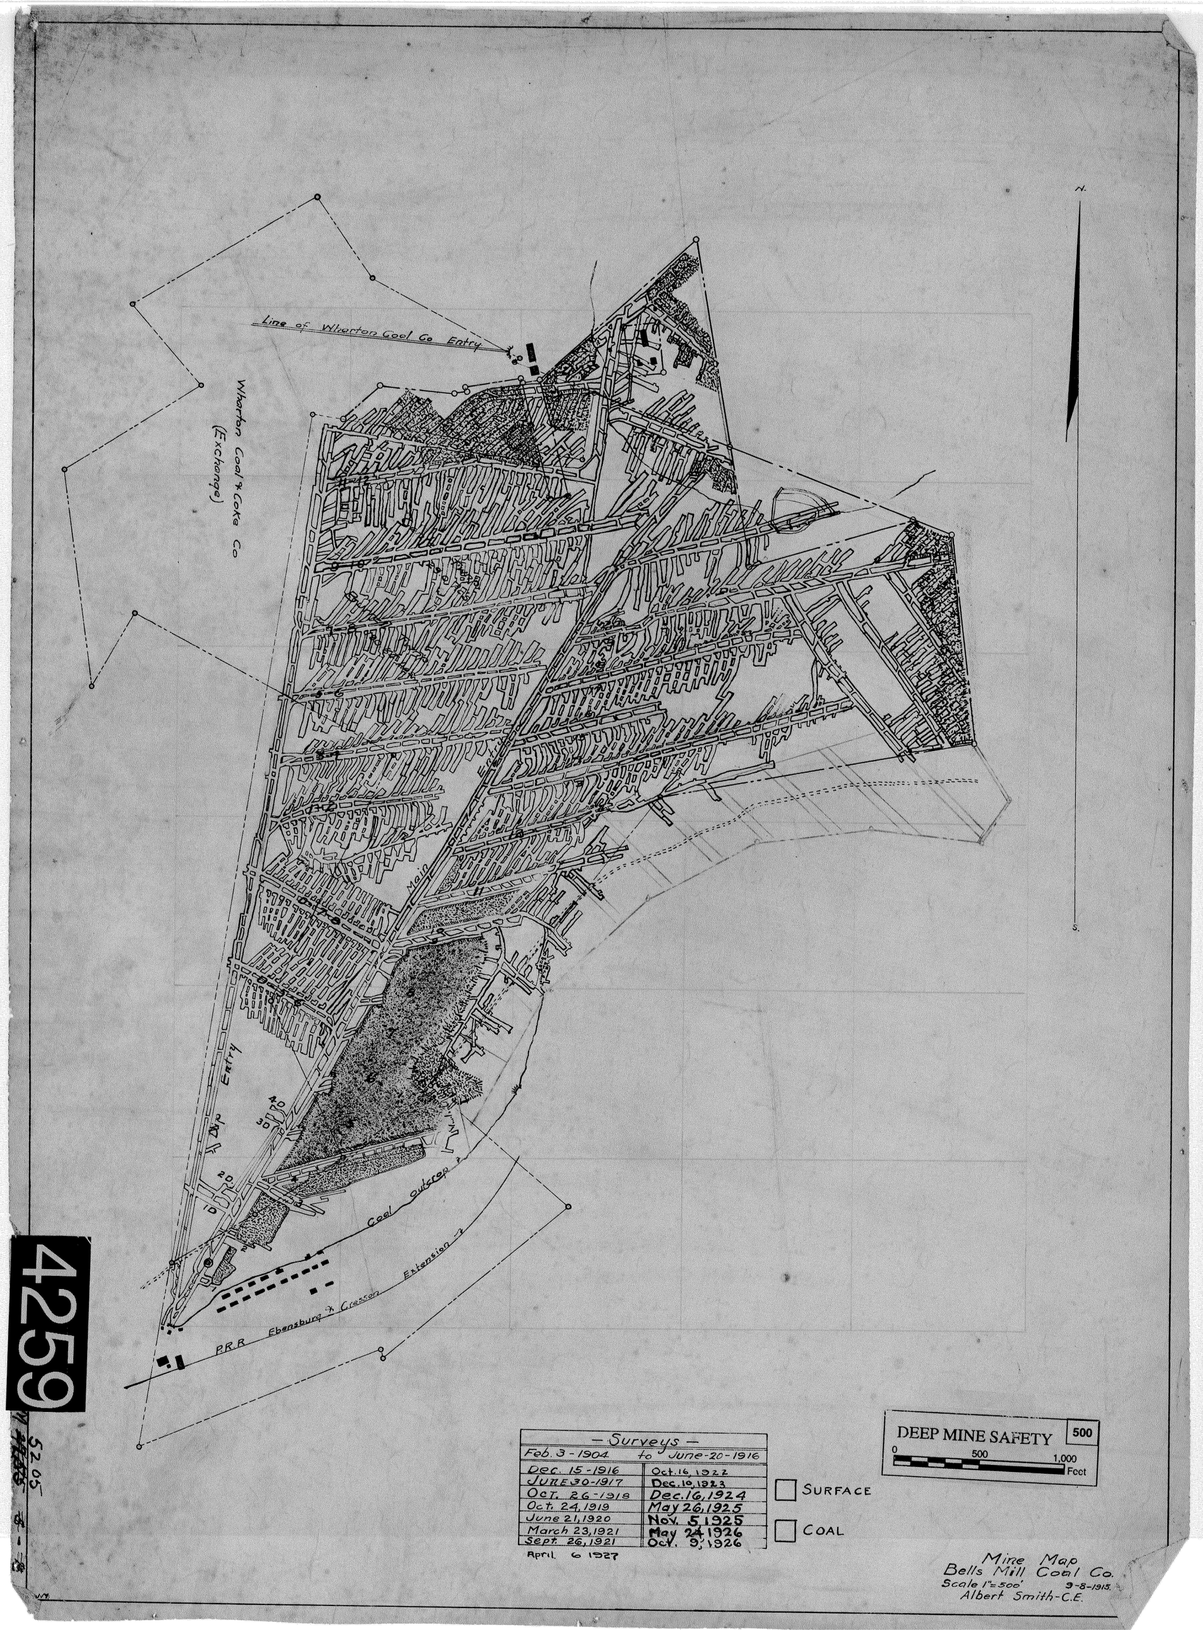
N.
Line of Wharton Coal Co Entry
Wharton Coal & Coke Co
(Exchange)
Entry
Coal Outcrop
Extension of
PRR Ebensburg & Cresson
Surveys
Feb 3 - 1904 to June-20-1916
Dec. 15-1916 Oct. 14 1922
JUNE 30-1917 Dec. 19 1923
Oct. 26-1918 Dec. 16, 1924
Oct. 24, 1919 May 26, 1925
June 21, 1920 Nov. 5 1925
March 23, 1921 May 24 1926
Sept 26, 1921 Oct. 9, 1926
April 6 1927
SURFACE
COAL
DEEP MINE SAFETY
0 500 1,000 Feet
Mine Map
Bells Mill Coal Co.
Scale 1"=500'
9-8-1915
Albert Smith-C.E.

4259

52 05