


BLAIRSVILLE CEMETERY

MAHER LAND

OTHER PART OF CATHOLIC CEMETERY

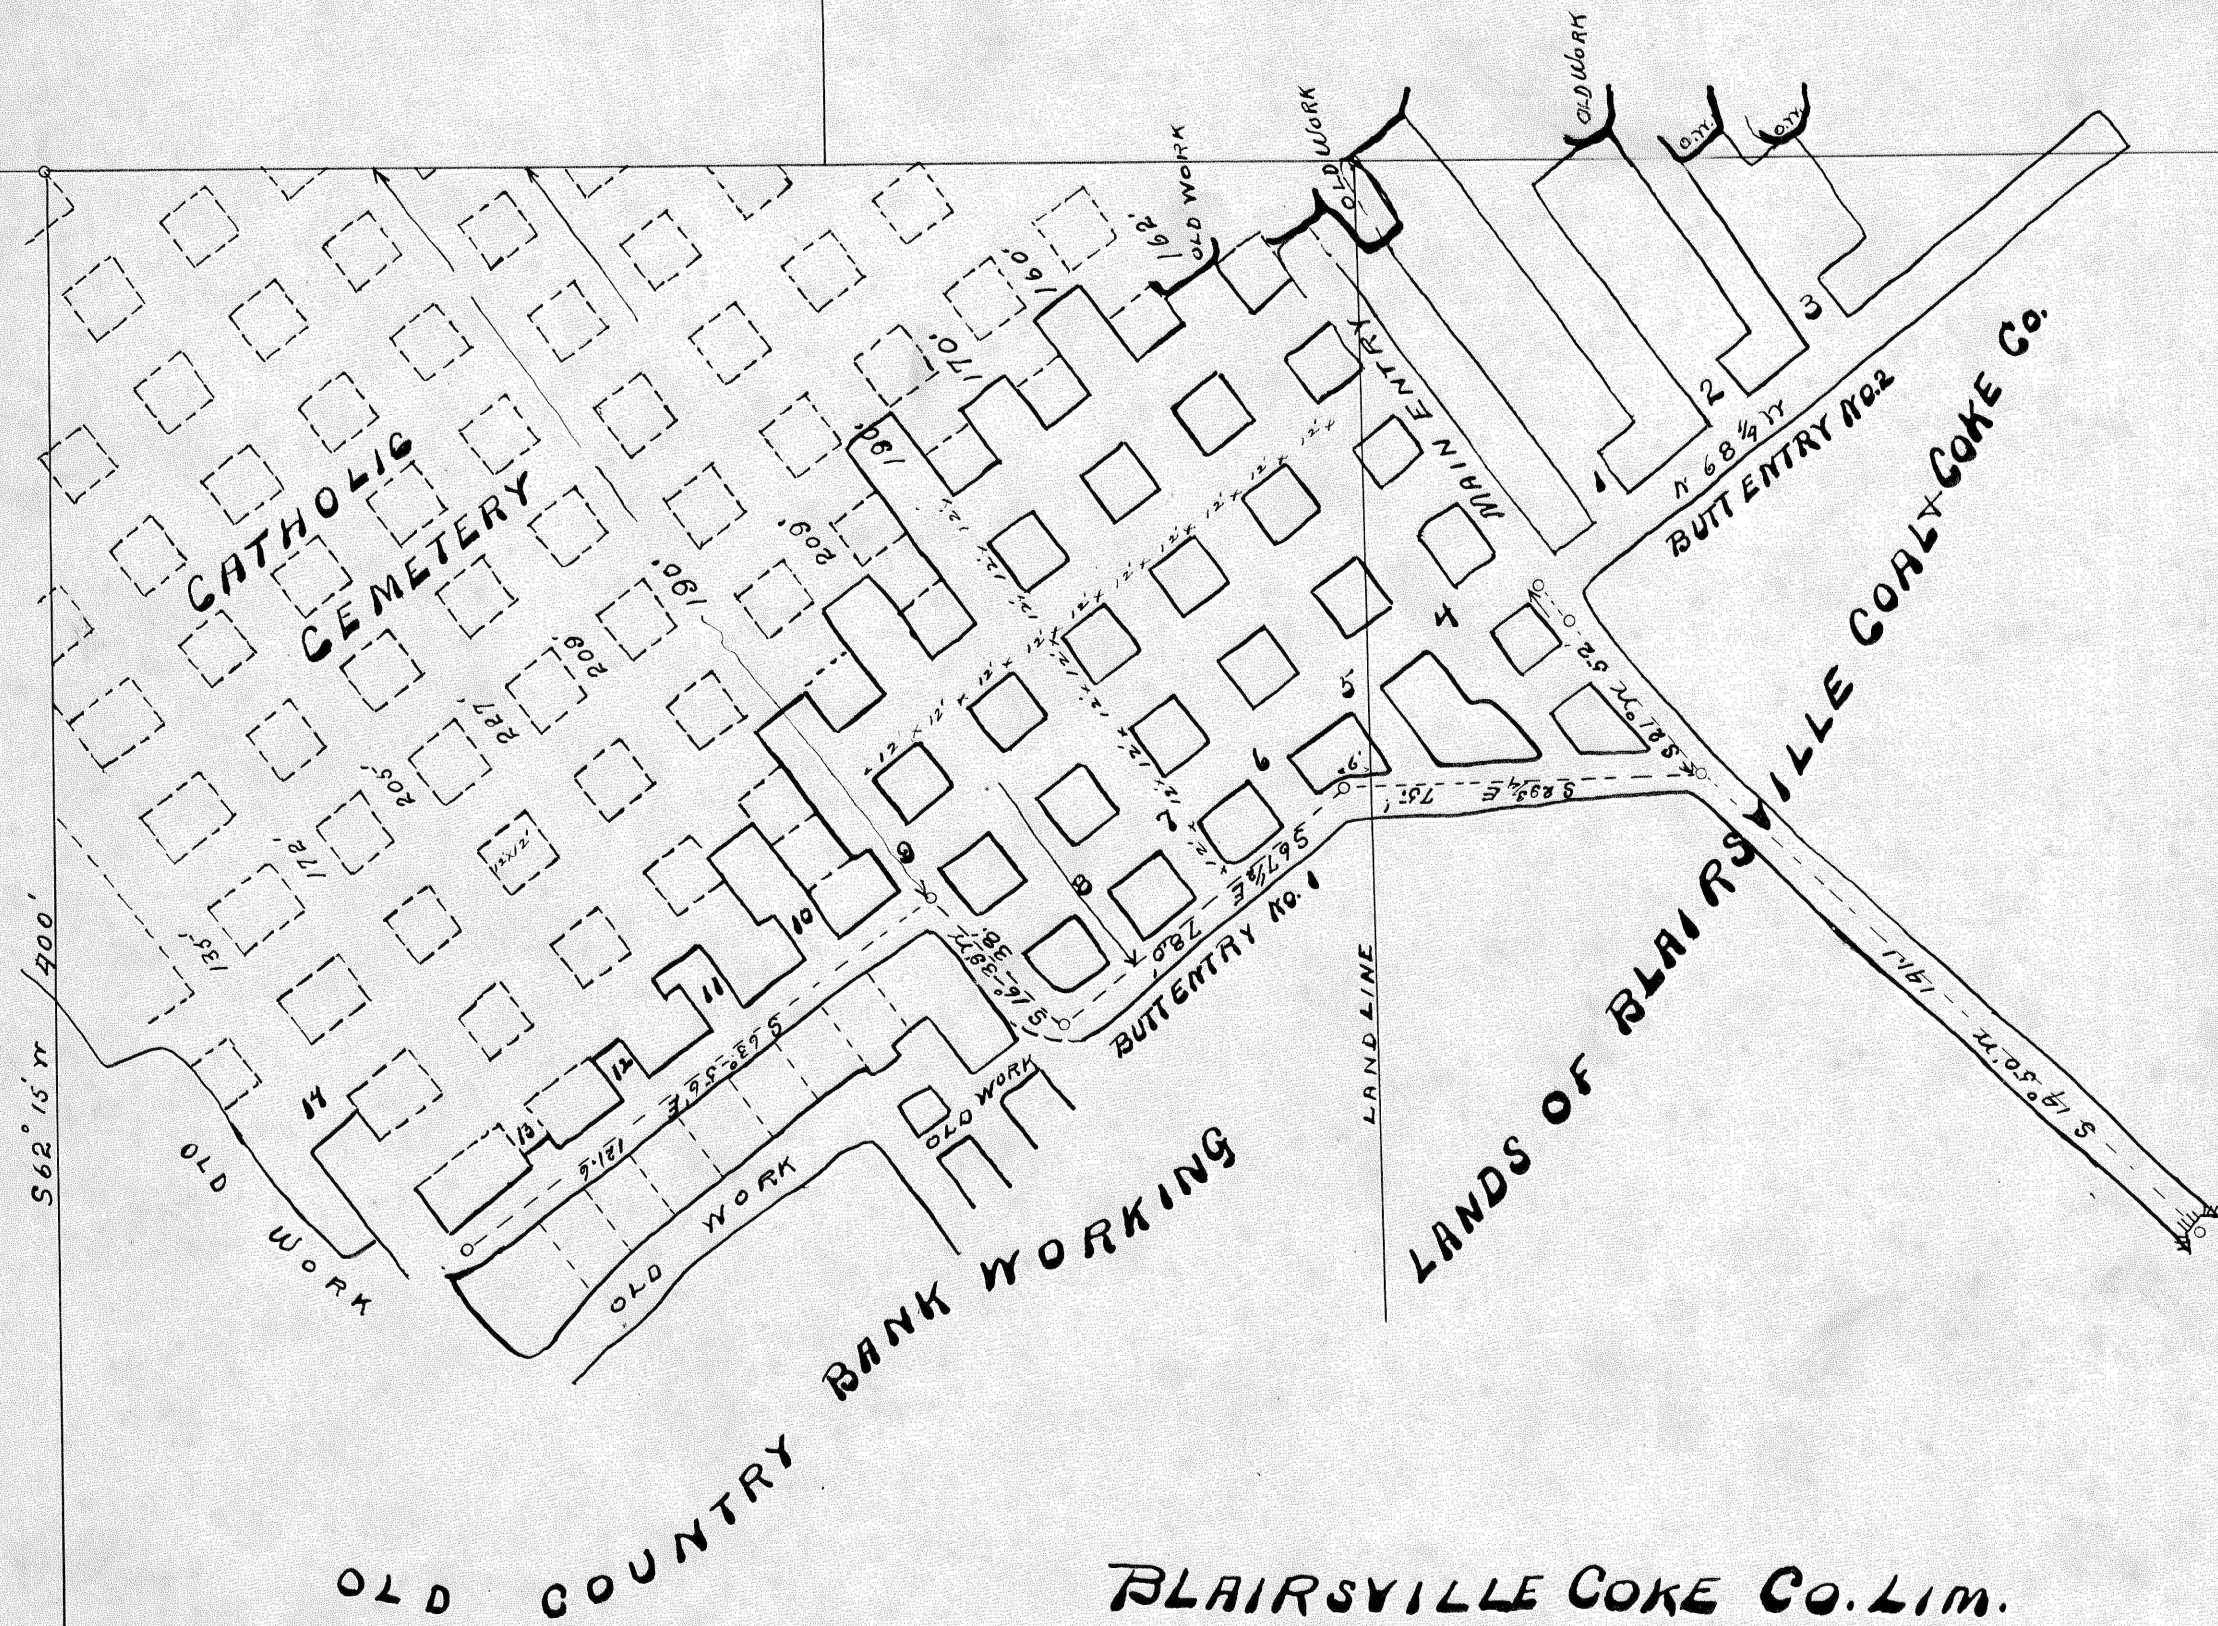

BLAIRSVILLE COKE CO. LIM.

NO. 2 MINE

WILSON & SMITH
CIVIL ENGINEERS

JAN. 4. 1902.

SCALE 1" = 40'

4261