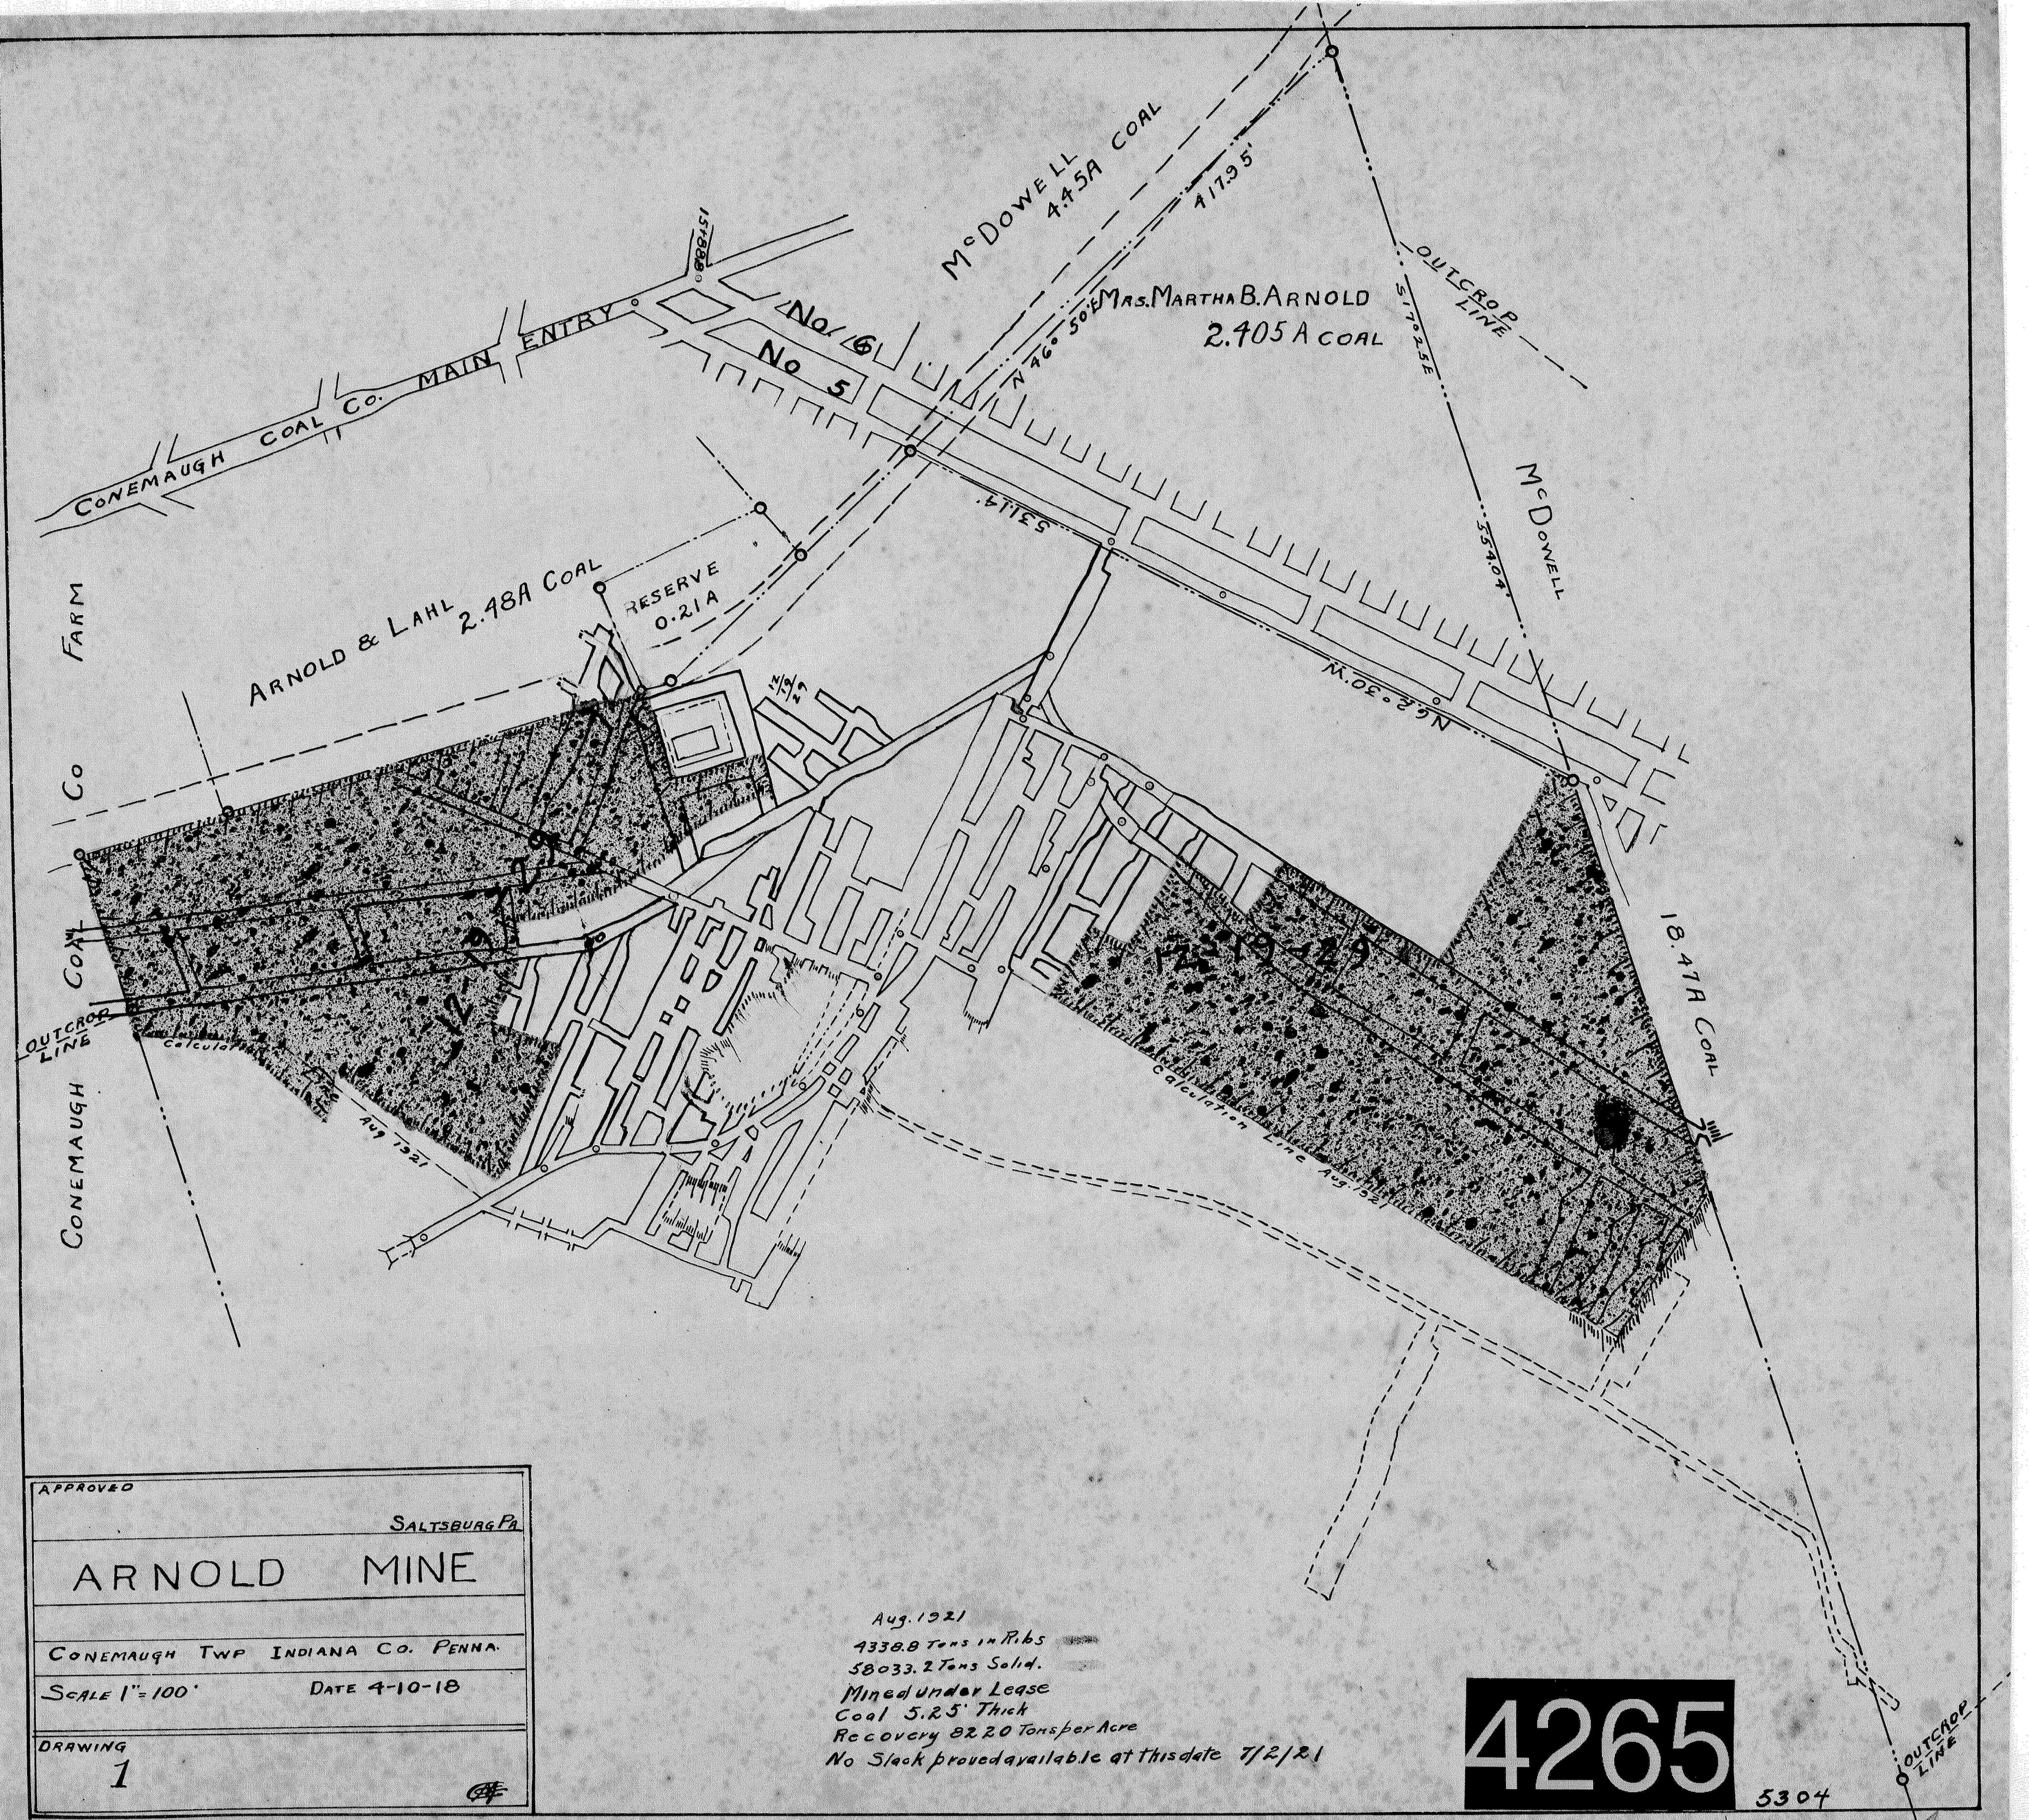
Conemaugh Coal Co. Main Entry
15888
No. 6
No. 5
McDowell 4.45A Coal
417.35'
N 46° 50' E
Mrs. Martha B. Arnold 2.405 A Coal
Outcrop Line
S 17° 25' E
554.04'
McDowell
531.14'
N 62° 30' W
Arnold & Lahl 2.48A Coal
Reserve 0.21 A
Farm
Co
Conemaugh Coal Co
Outcrop Line
Calculation Line
Aug 1921
18.47A Coal
Calculation Line Aug 1921

APPROVED

SALTSBURG PA.

ARNOLD MINE

CONEMAUGH TWP INDIANA CO. PENNA.

SCALE 1" = 100'
DATE 4-10-18

DRAWING
1

Aug. 1921
4338.8 Tons in Ribs
58033.2 Tons Solid.
Mined under Lease
Coal 5.25' Thick
Recovery 8220 Tons per Acre
No Slack proved available at this date 7/2/21

4265

5304

Gen. ~~2038~~ -