

WORKINGS
OF THE
GRAFF COAL CO.
UNDER LANDS OF
THOMPSON M^CCREA



SITUATED IN BLACKLICK TWP, INDIANA CO., PA.

SCALE 1"=100 FT.

SURVEYS,

JUNE 21, 1911
OCT. 5, 1911

ALBERT SMITH C.E.
SALTSBURG PA.

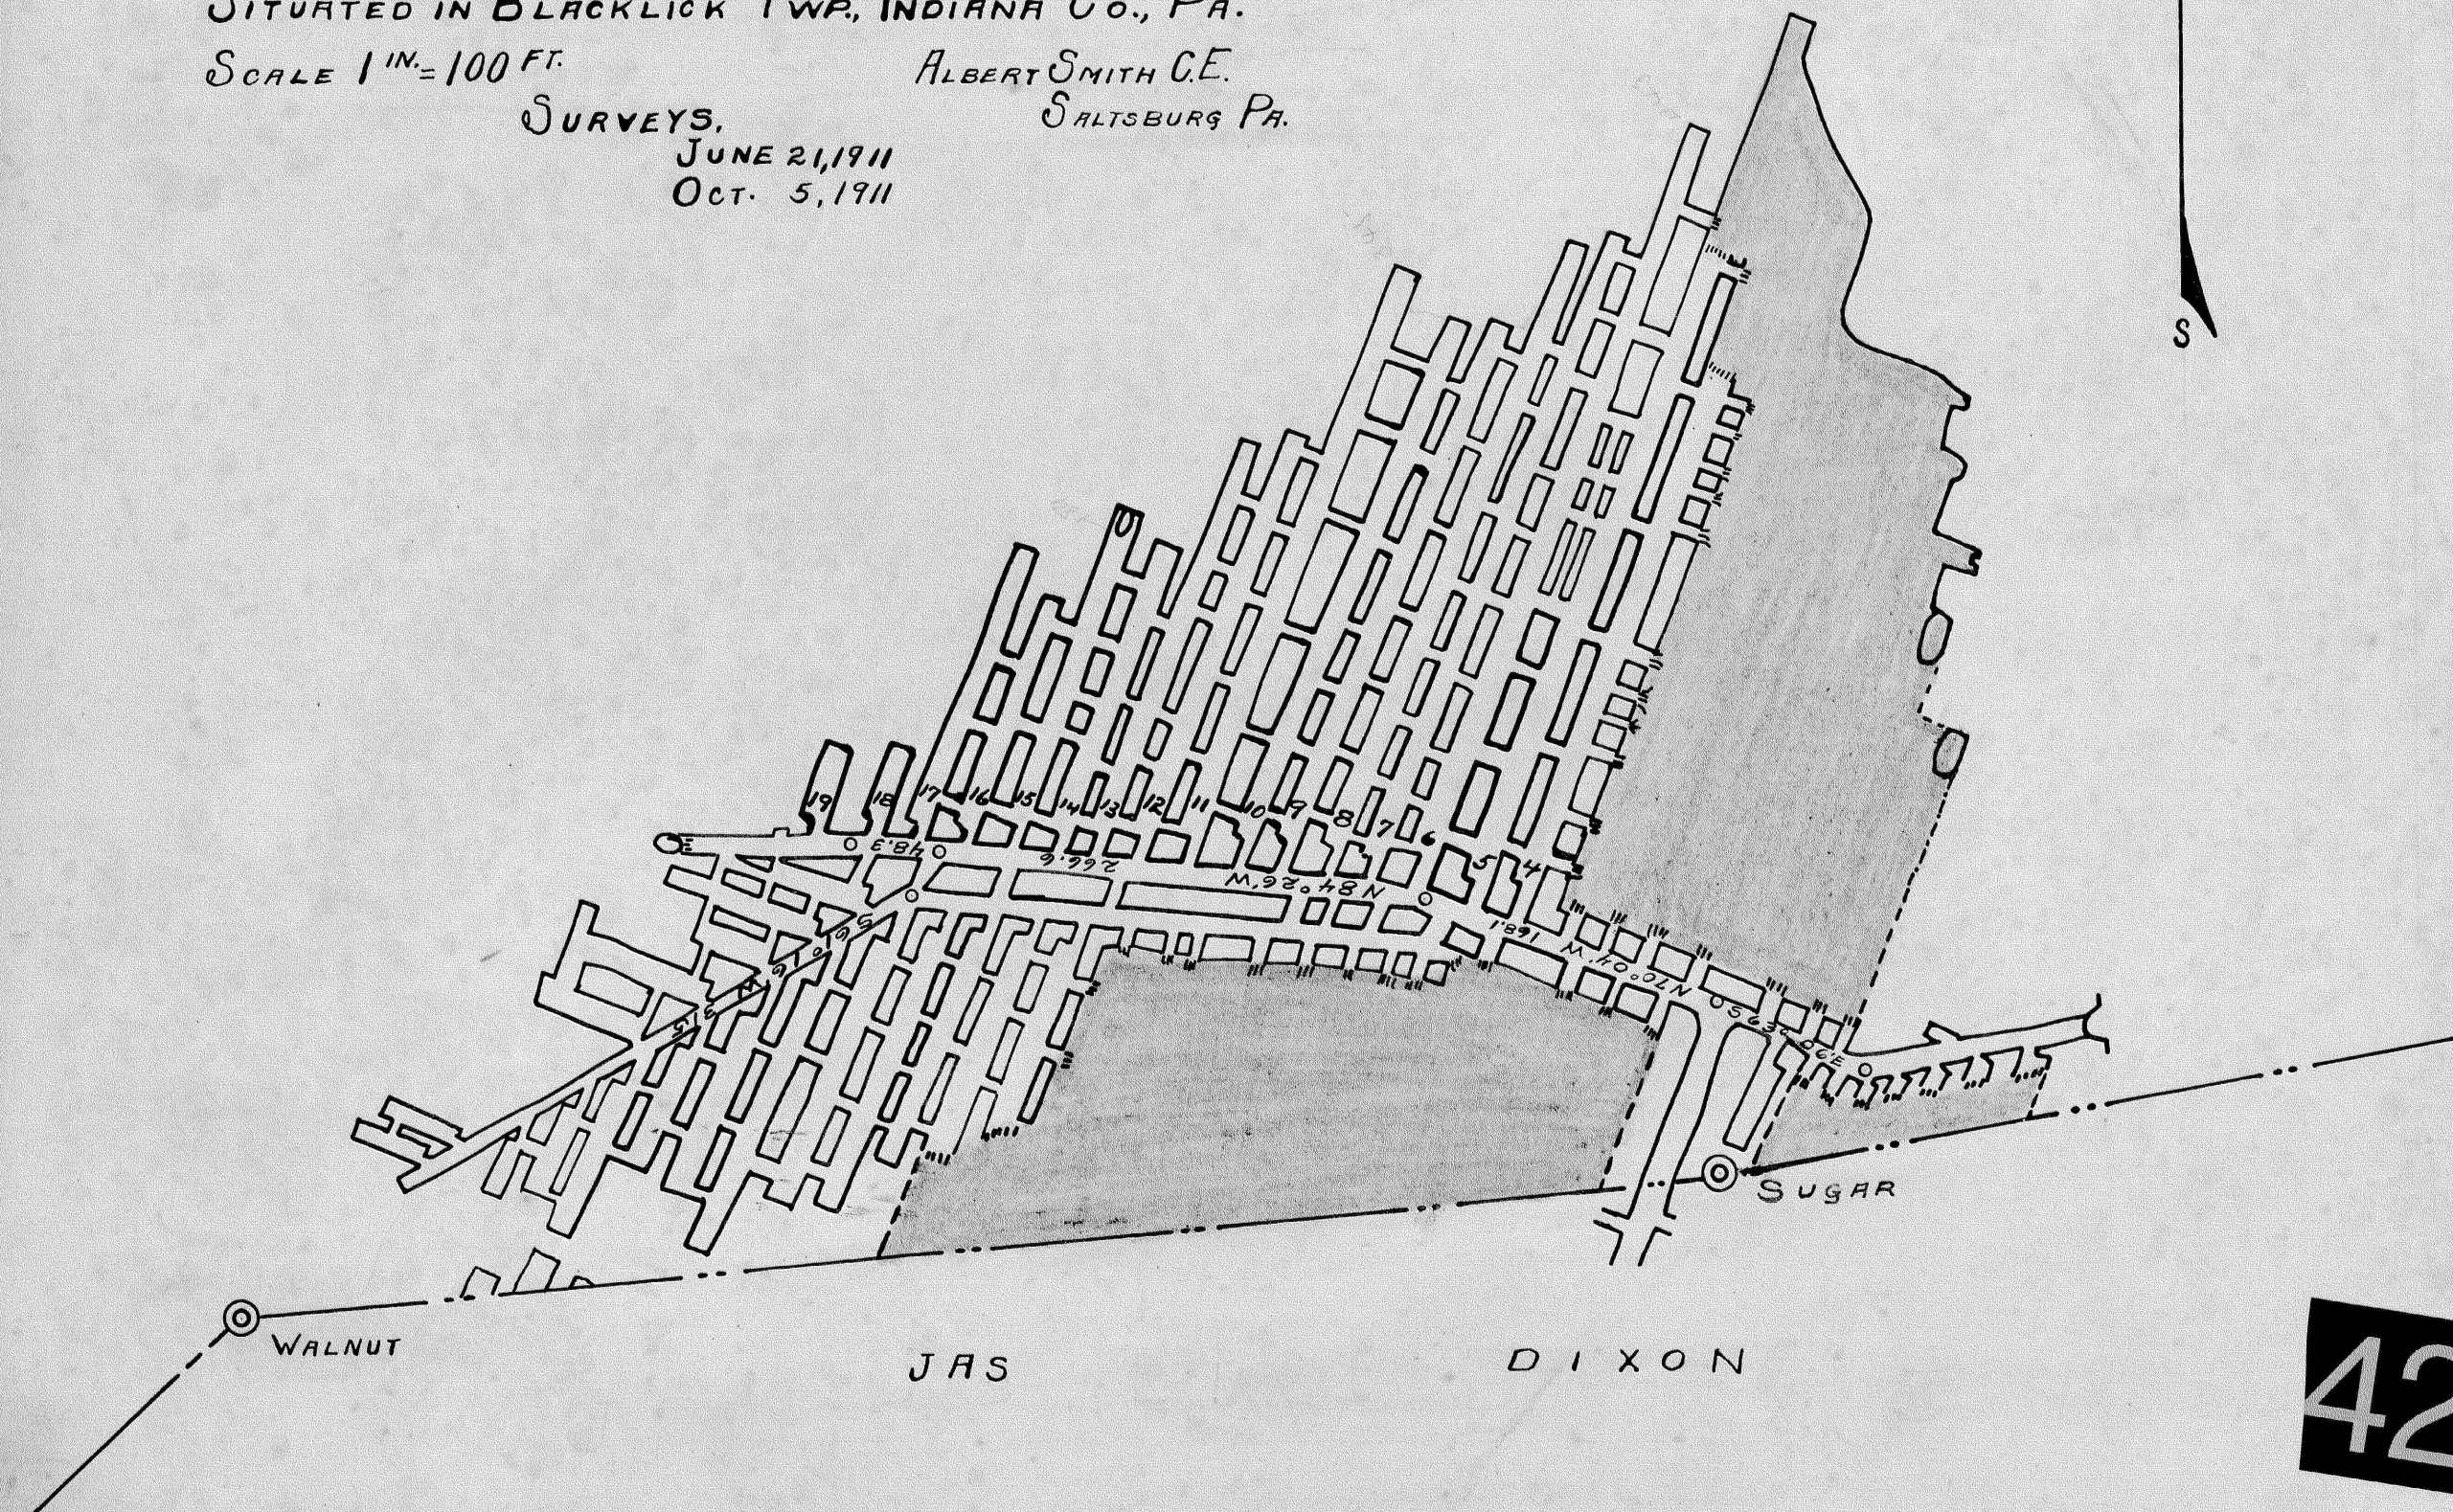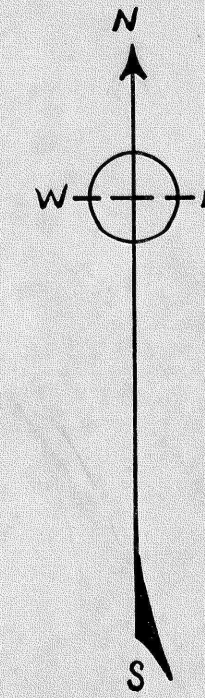

4269

5330
G.C. 2688-54