


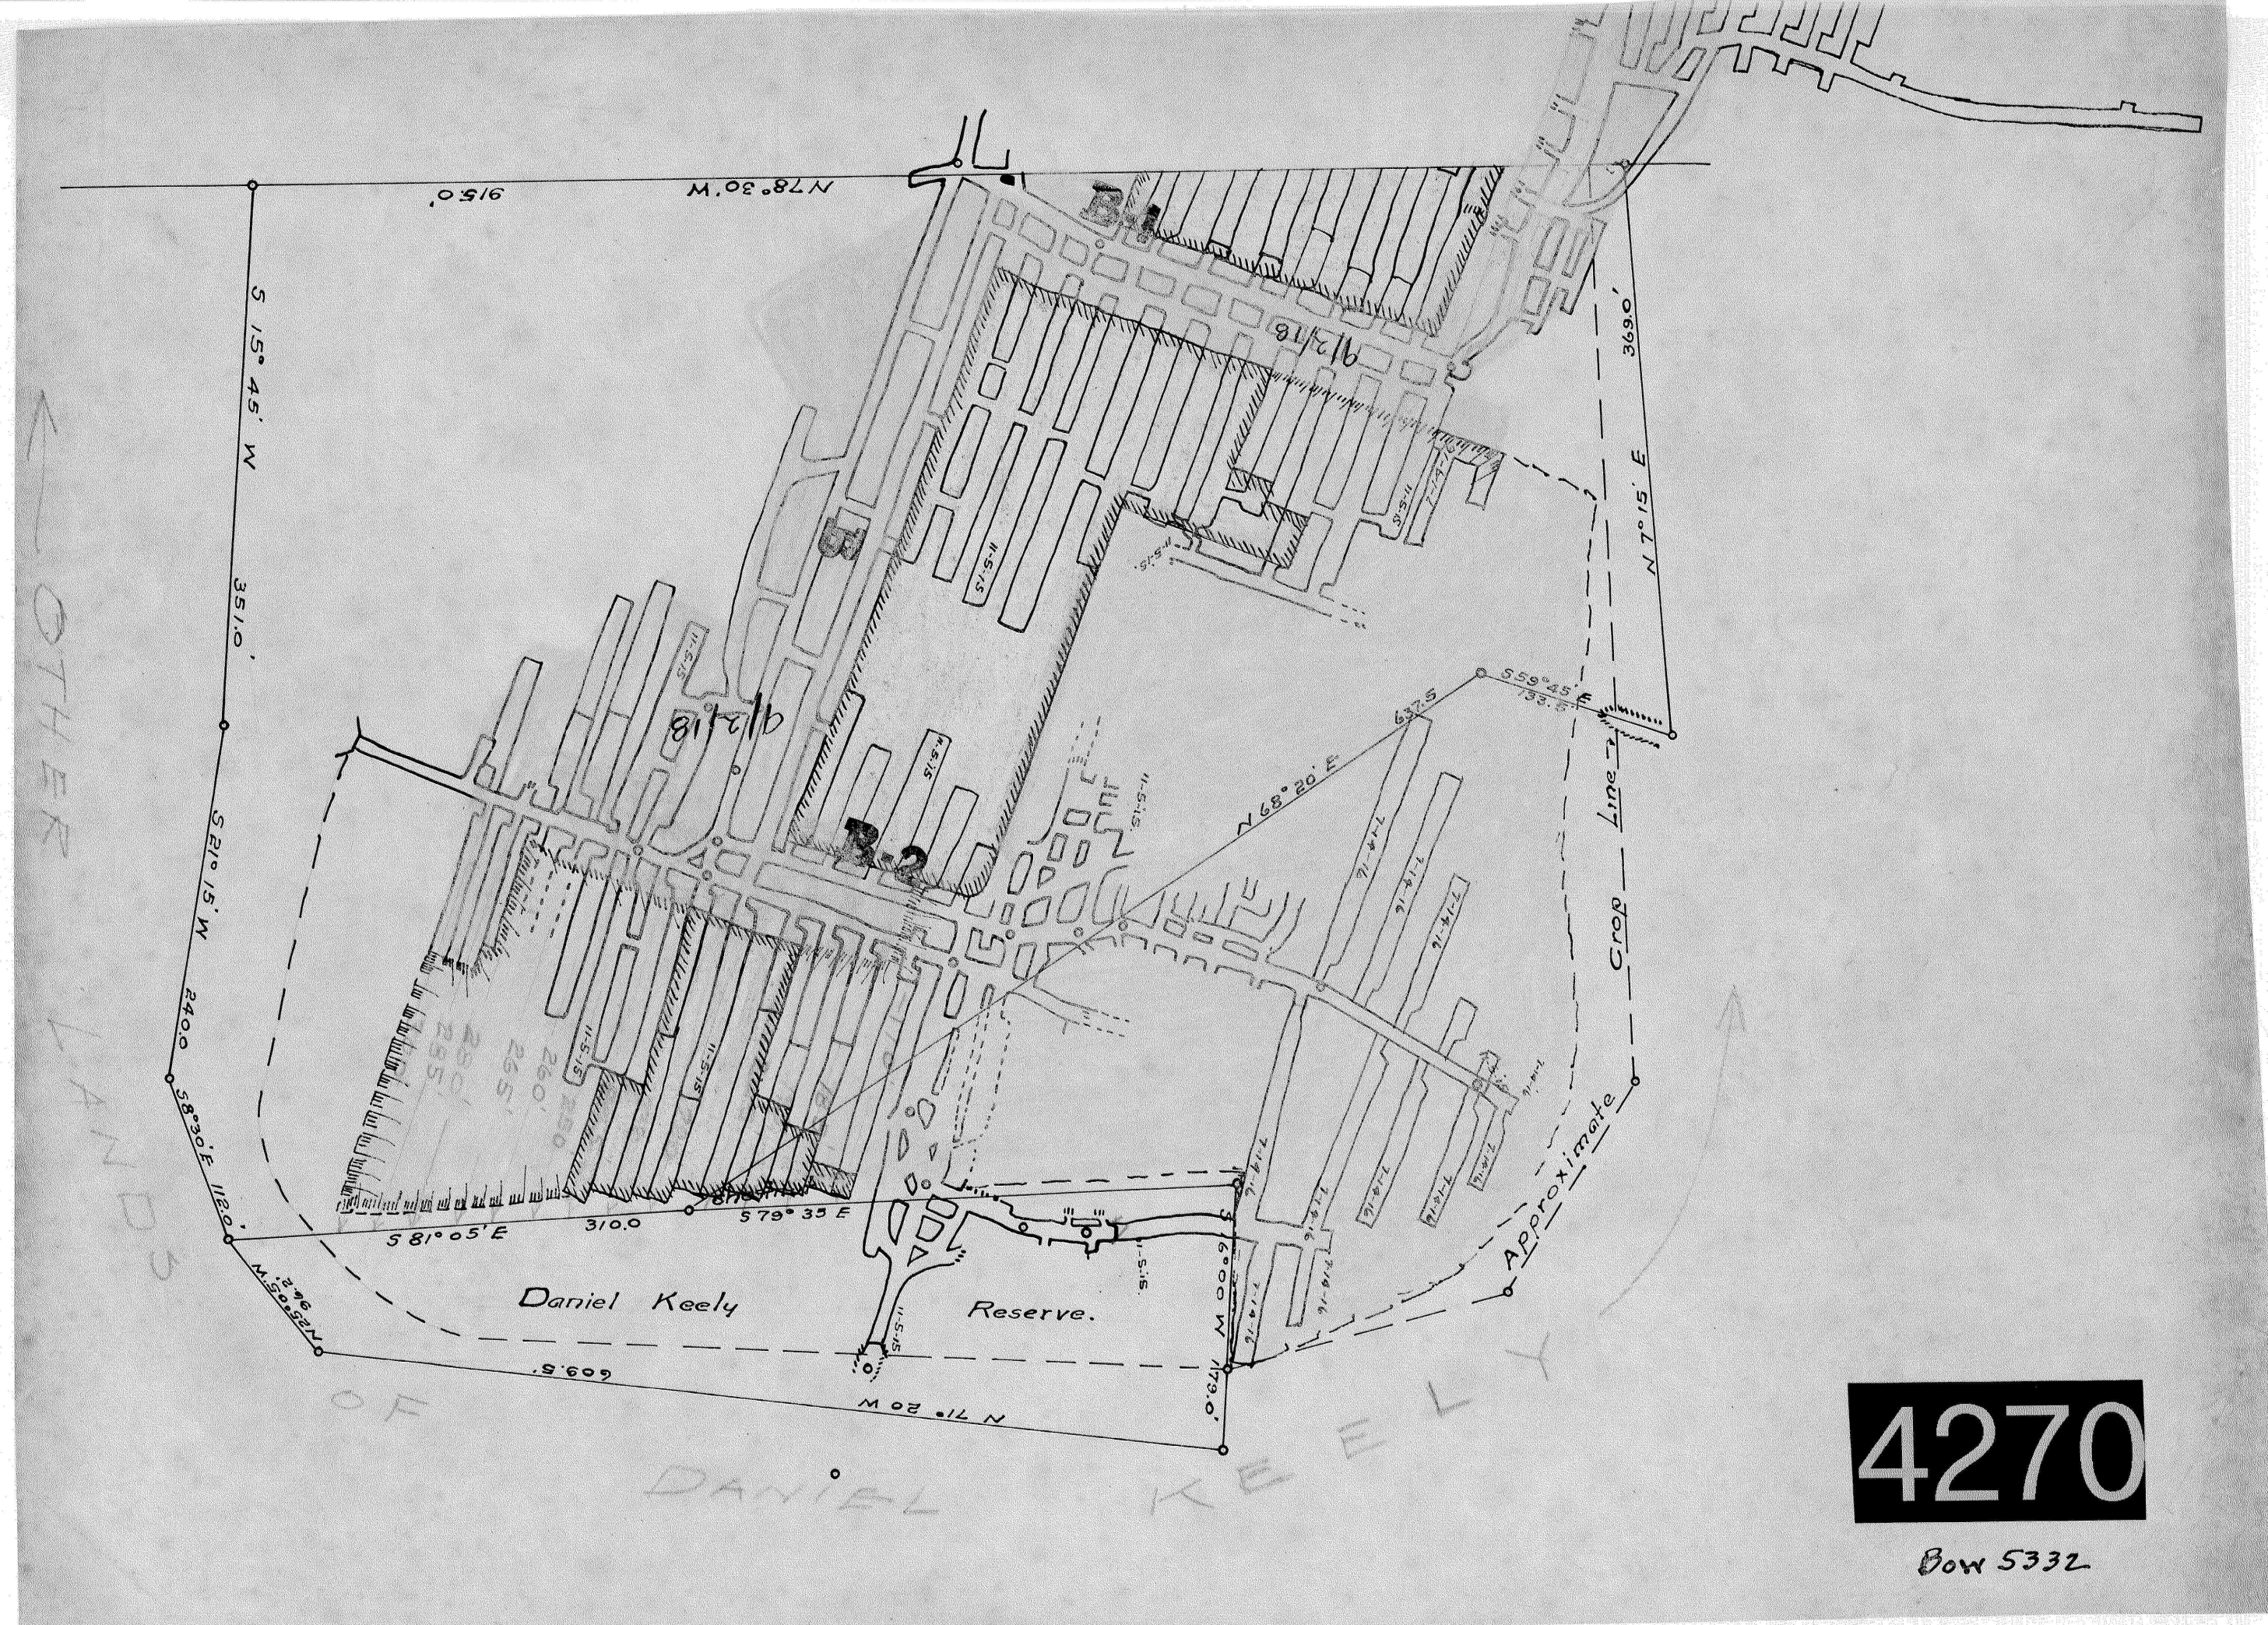

4270

Bow 5332