


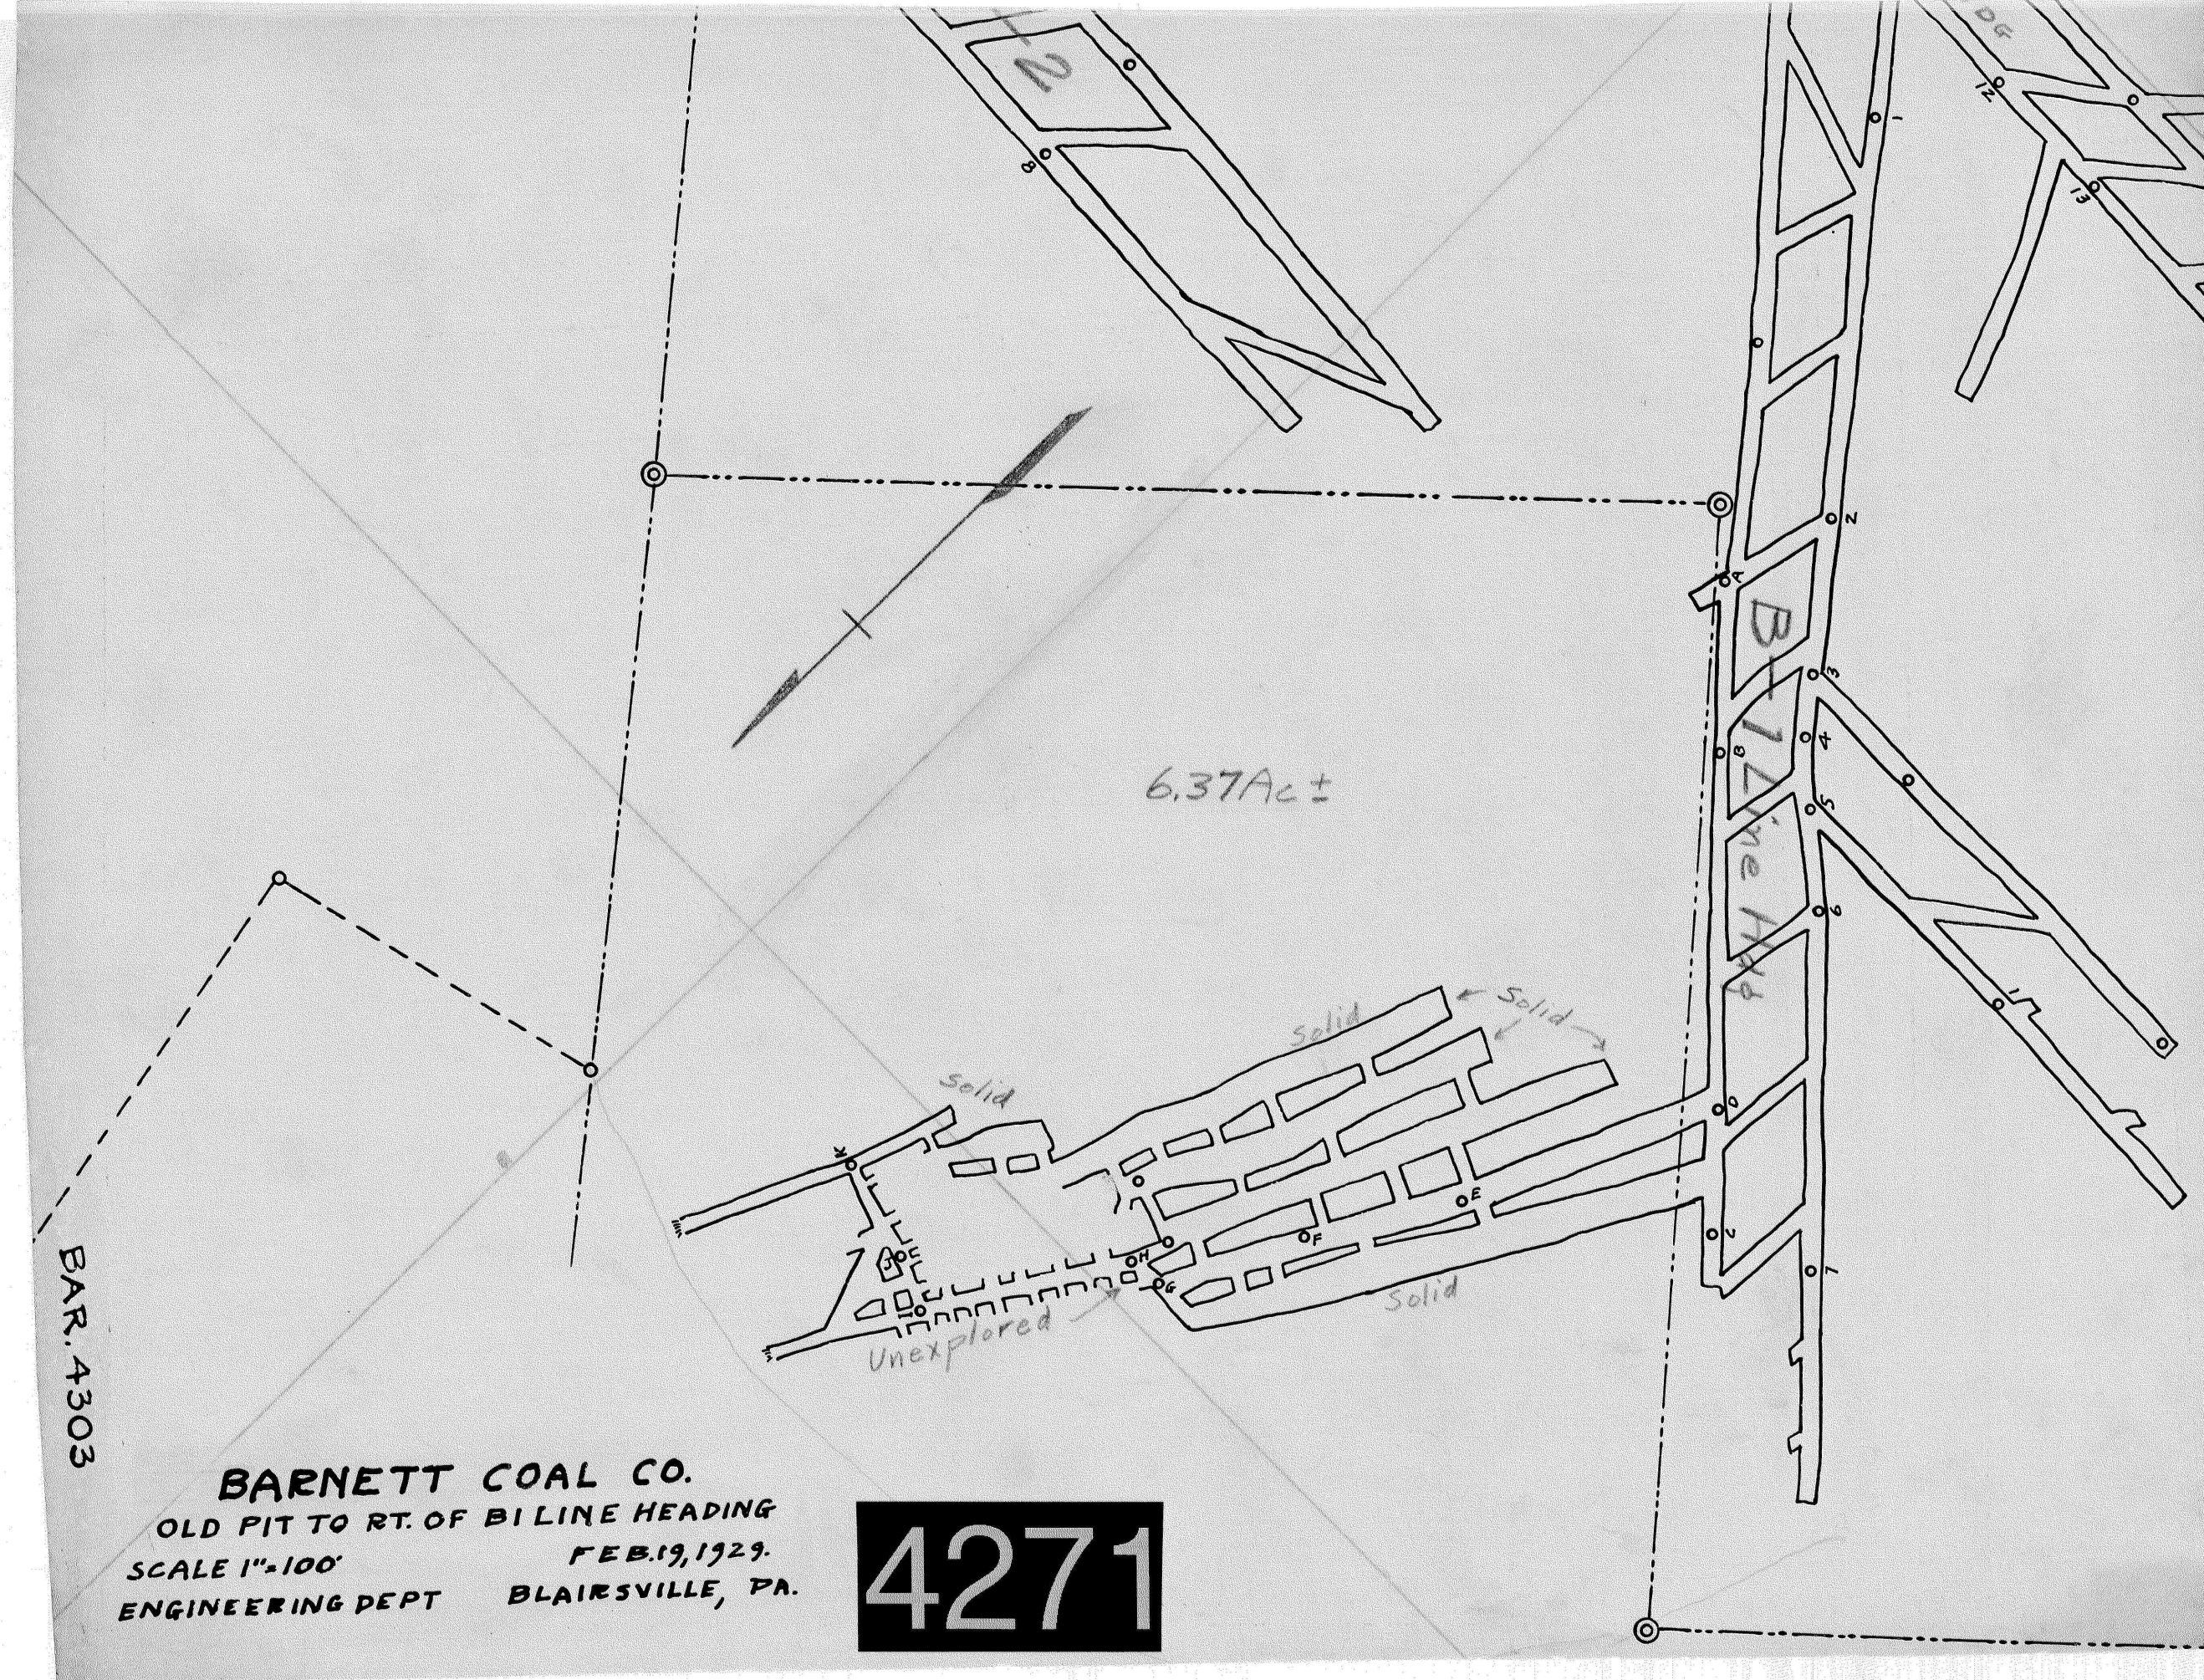

4271