


Westmoreland Mining Co.

Old Coketown
Workings

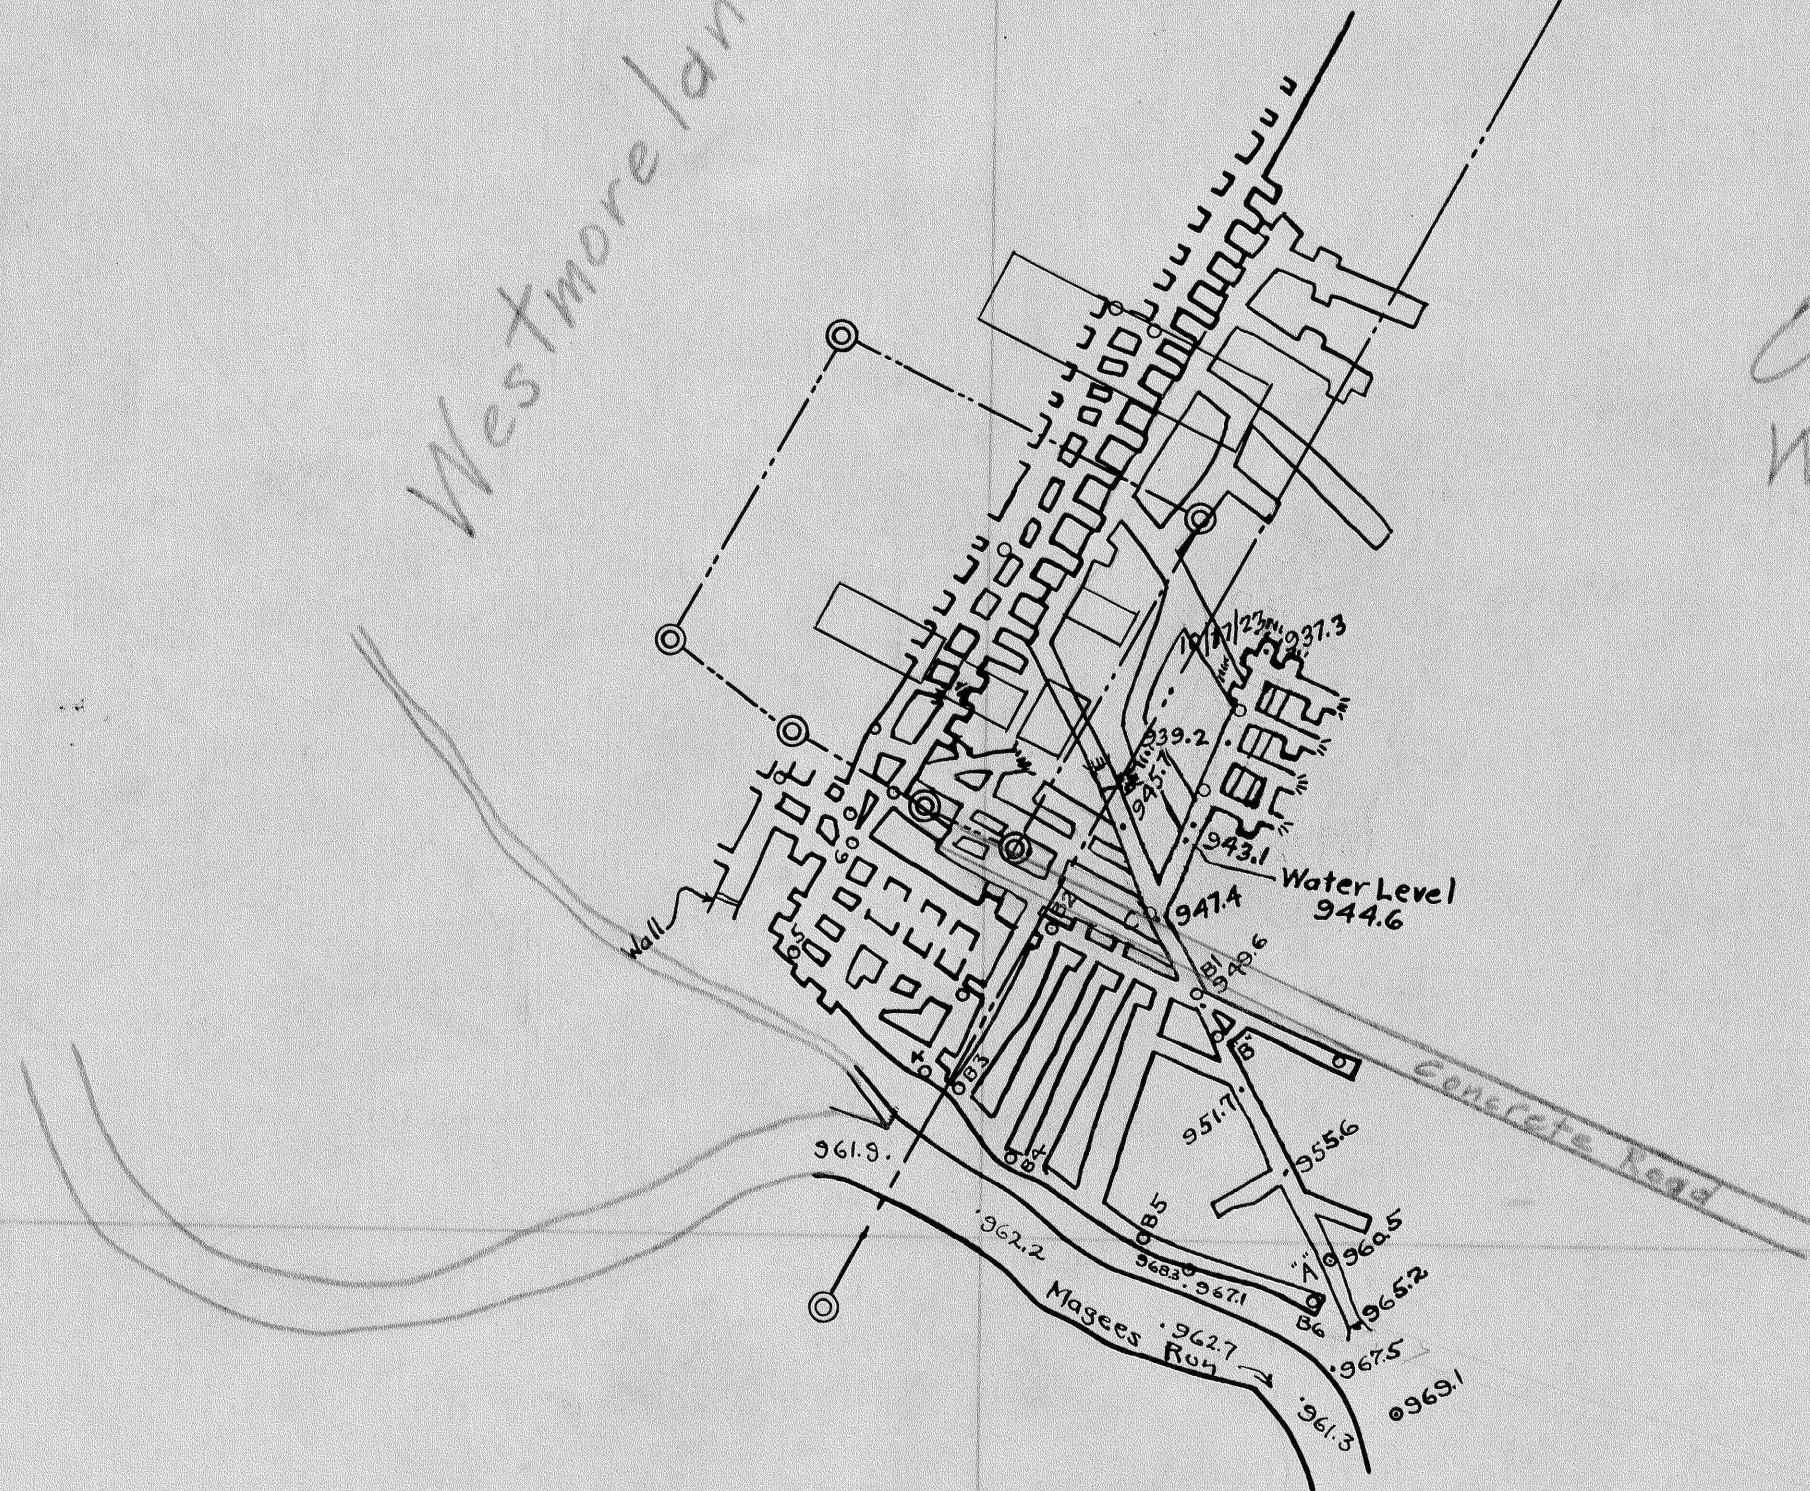

Curnow & Delafura Pit
Scale 1"=100'

4274

West. 3177 4-7
4609