


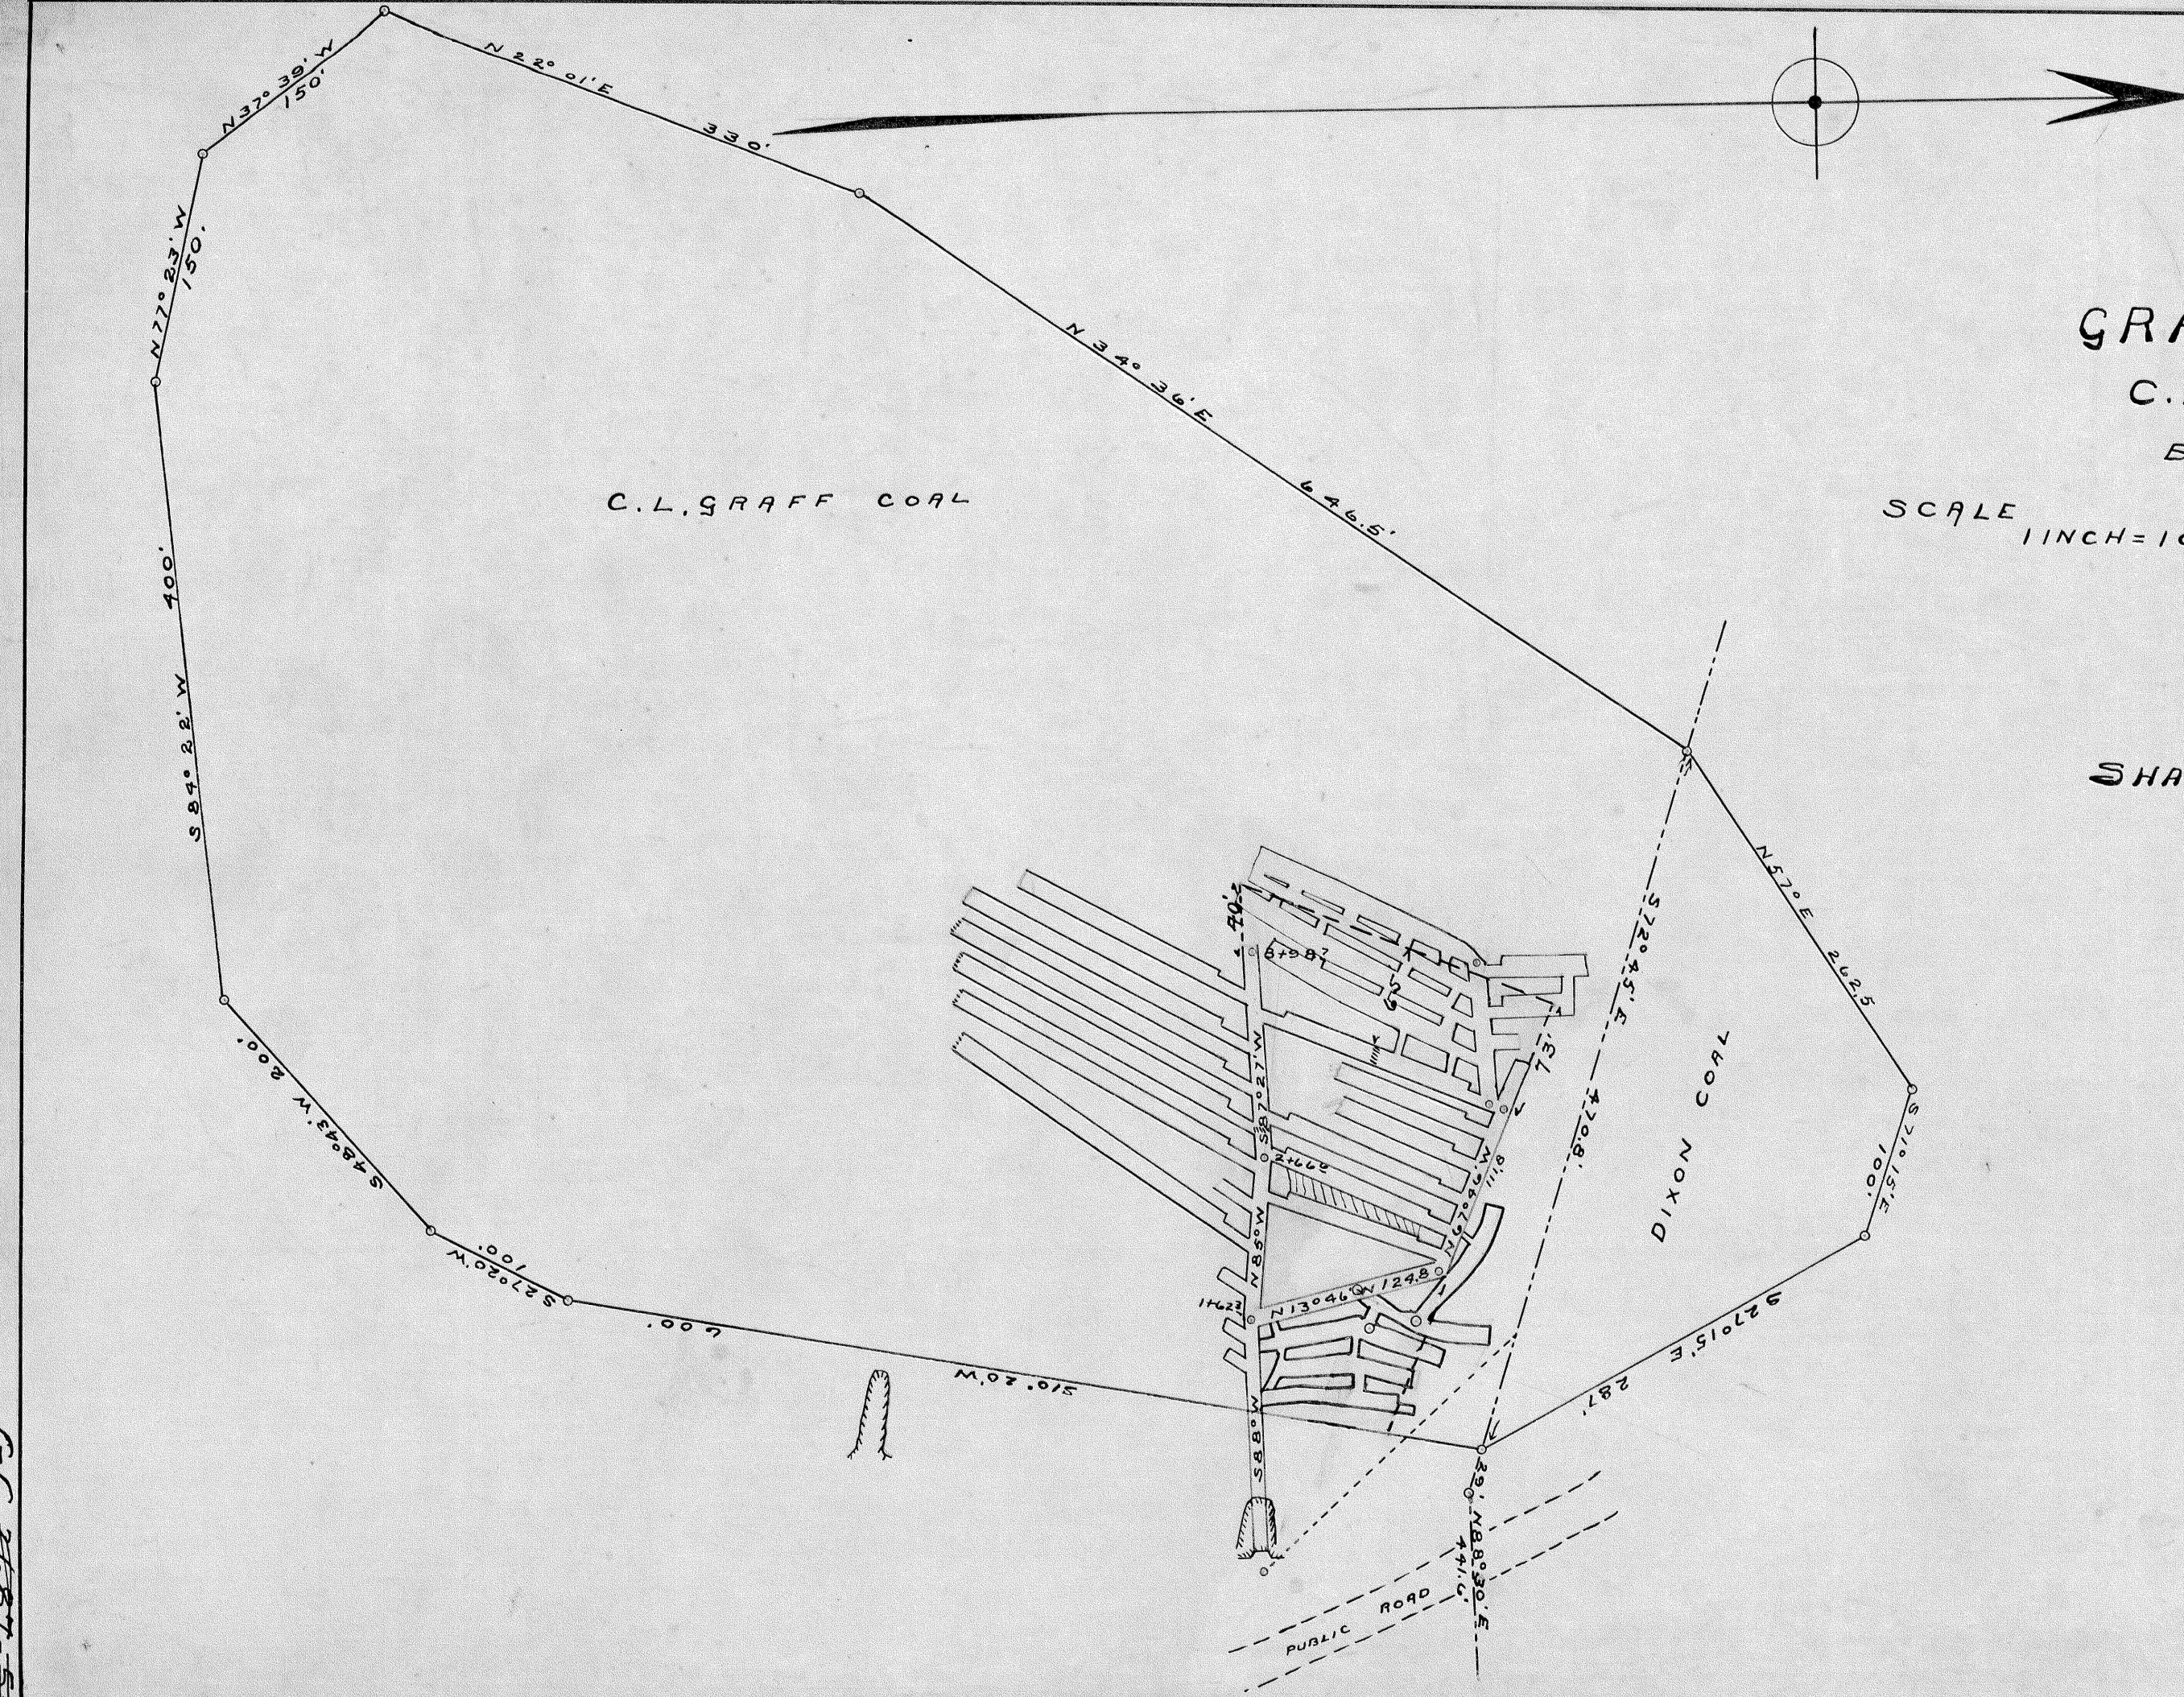

GRAFF COAL CO
C.L. GRAFF PIT.
BLACKLICK PENNA.

SCALE
1 INCH = 100 FT.

ALBERT SMITH.
ENG.

NOV. 16" 1904.
DEC. 9" 1908.
JAN. 30" 1912

SHADED AREA = ONE ACRE
RESERVED BY C.L. GRAFF

G.C. 2687-5-10.
5854

4276