


4277

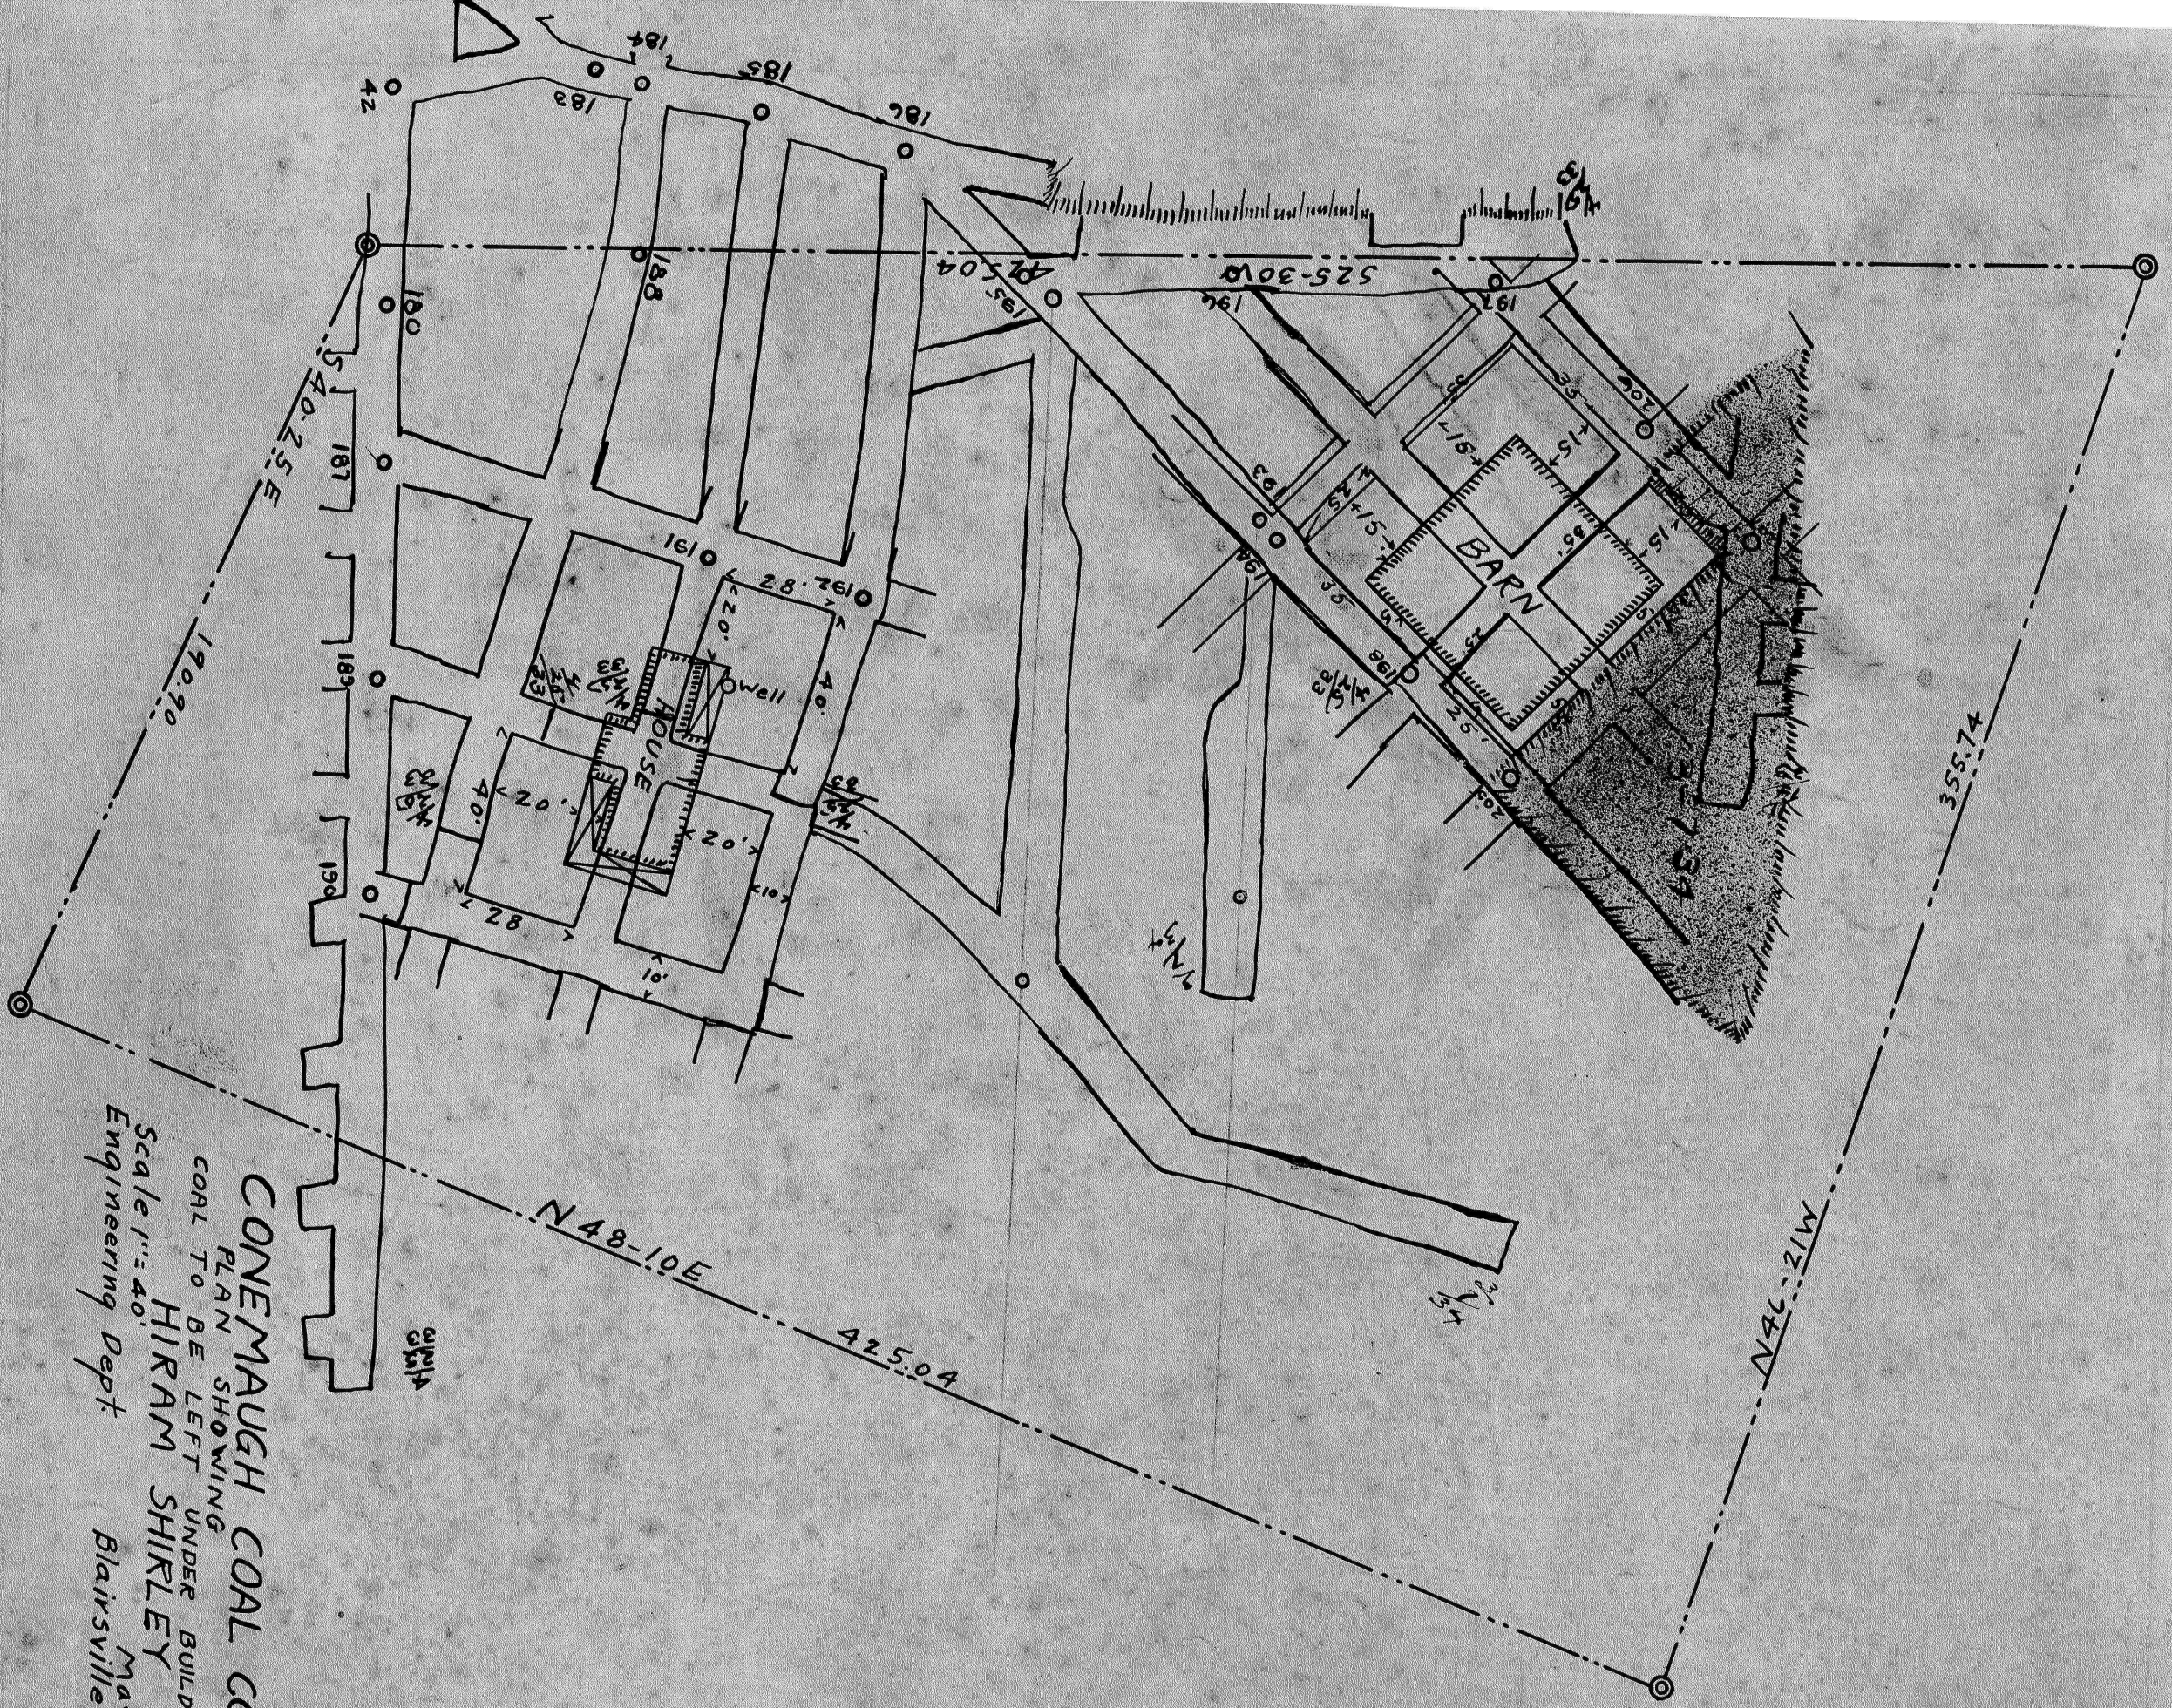

CONEMAUGH COAL CO.
PLAN SHOWING
COAL TO BE LEFT
UNDER BUILDINGS OF
HIRAM SHIRLEY
Scale 1"=40'
Engineering Dept
May 23, 1932
Blairsville Pa.