


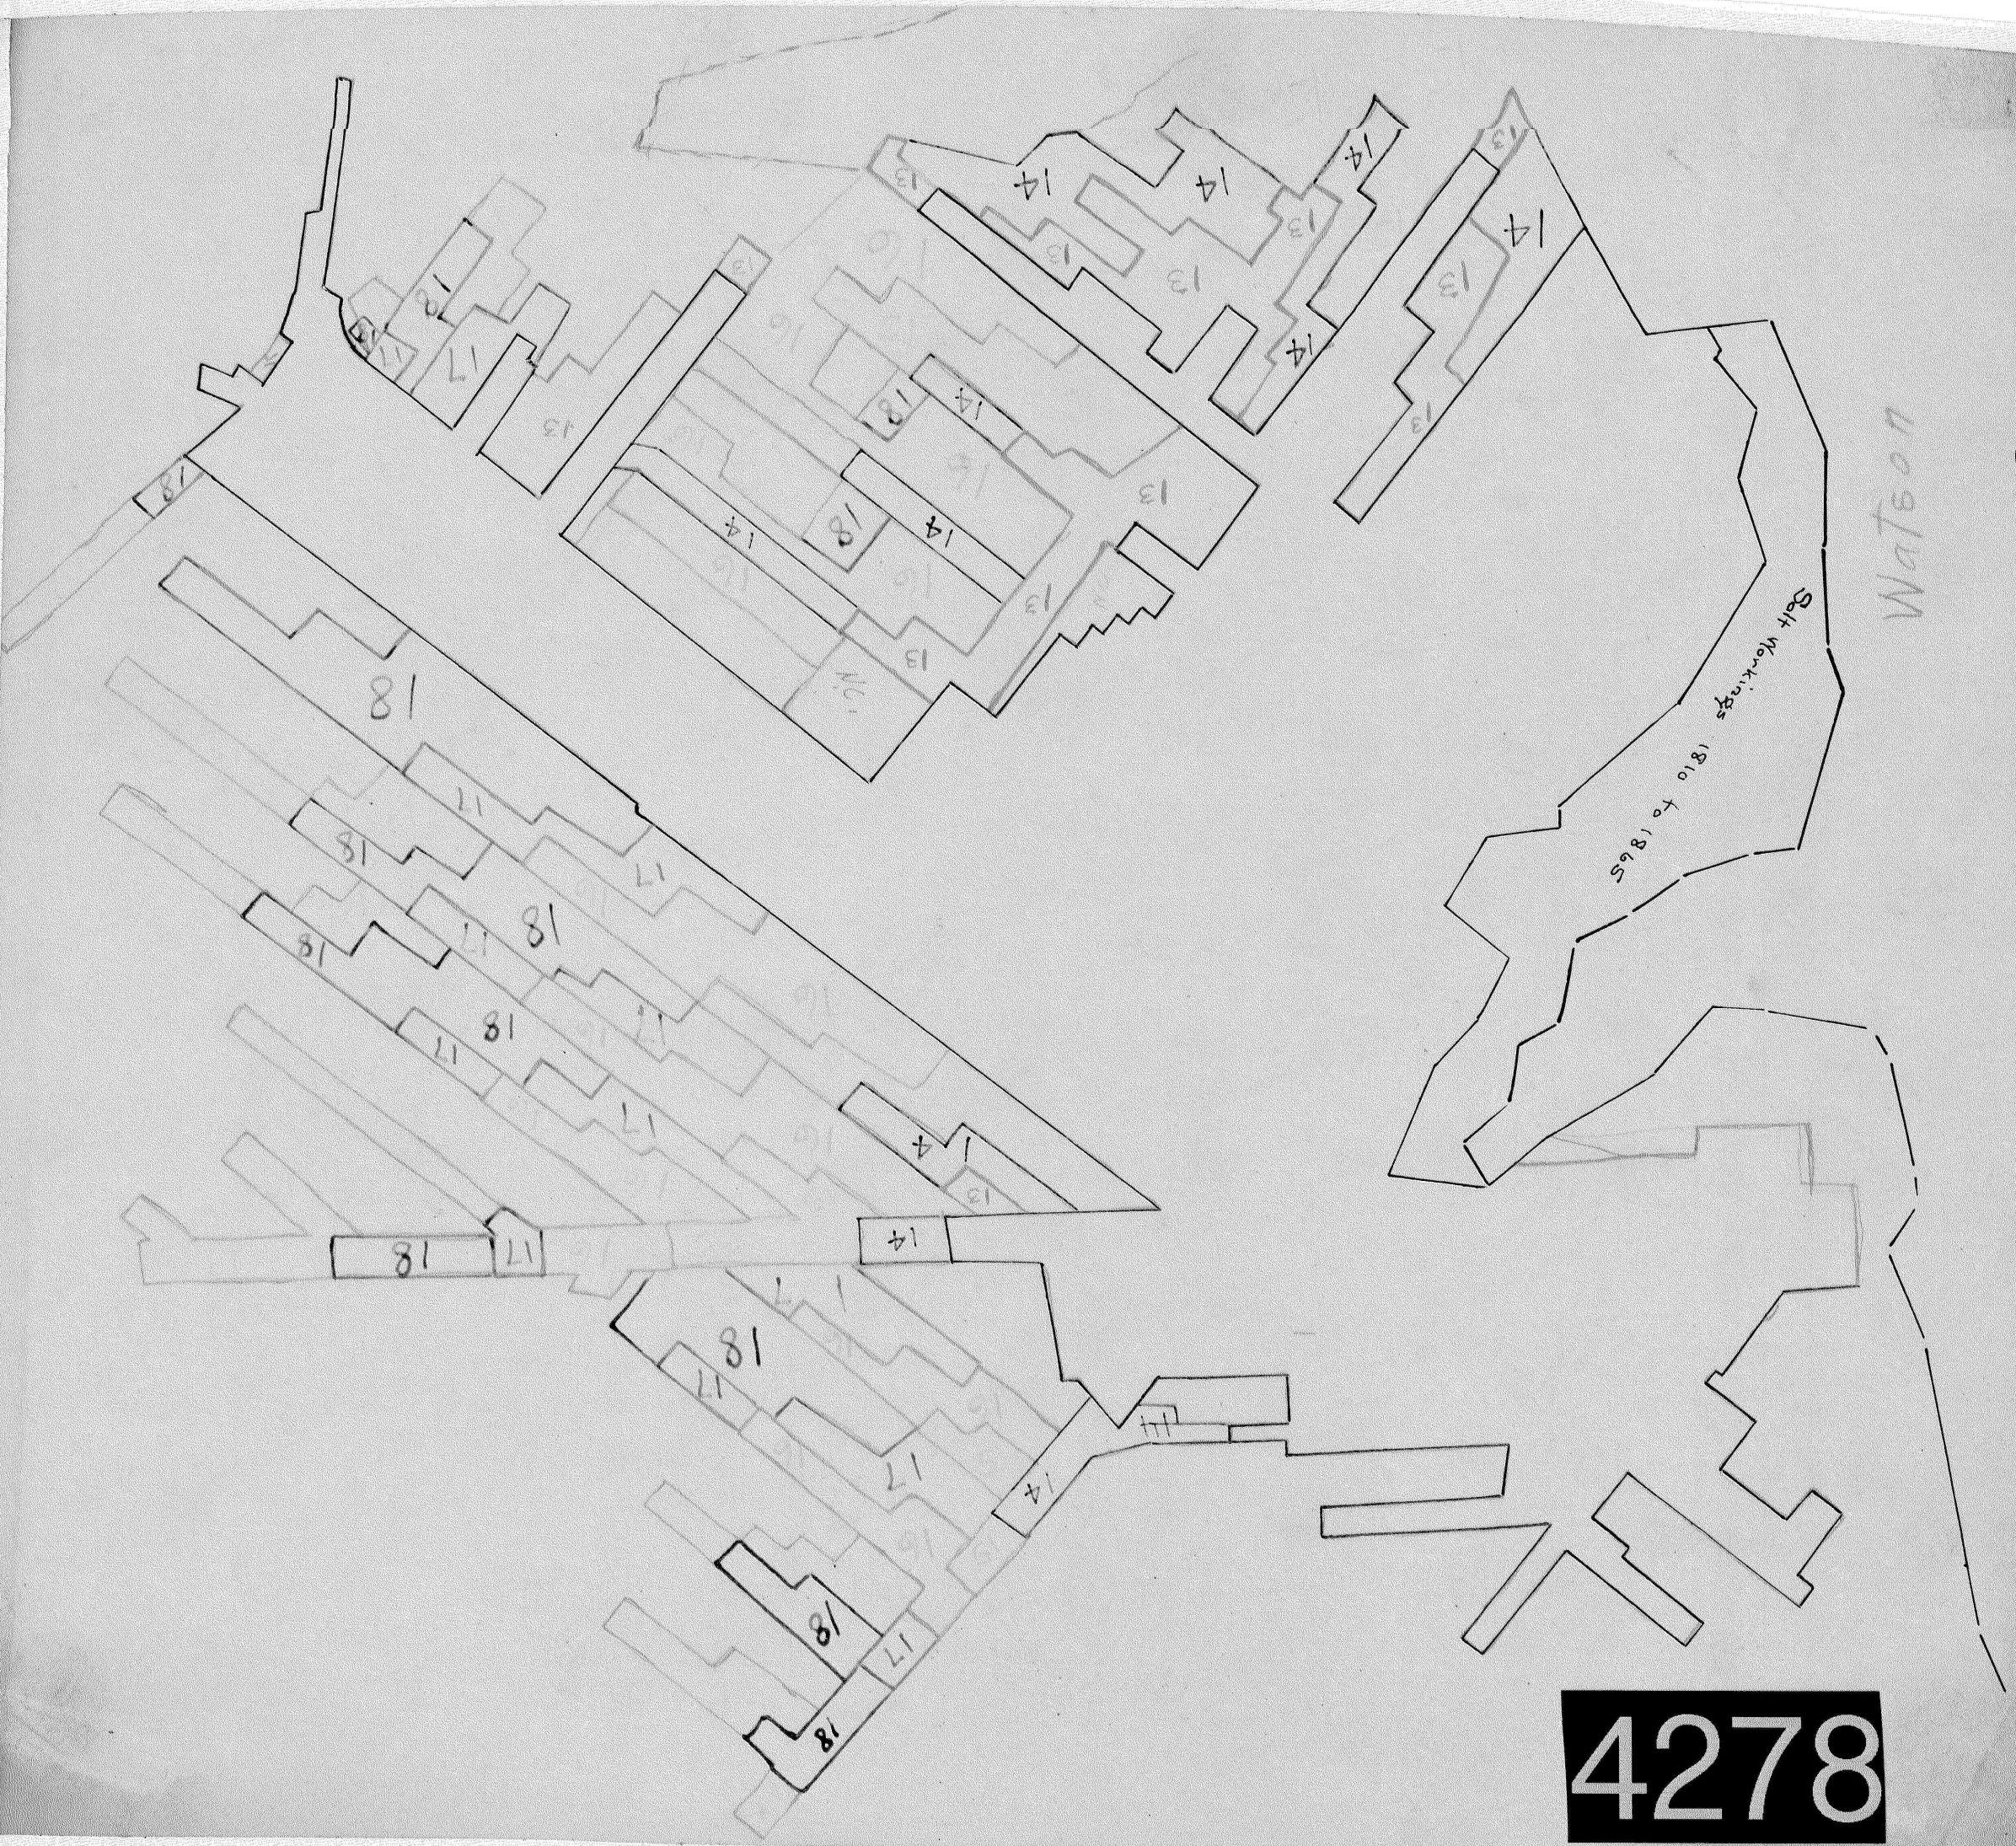

Watson

Salt Works 1810 to 1865

Wat 5007
~~5007~~ 5-11

4278