


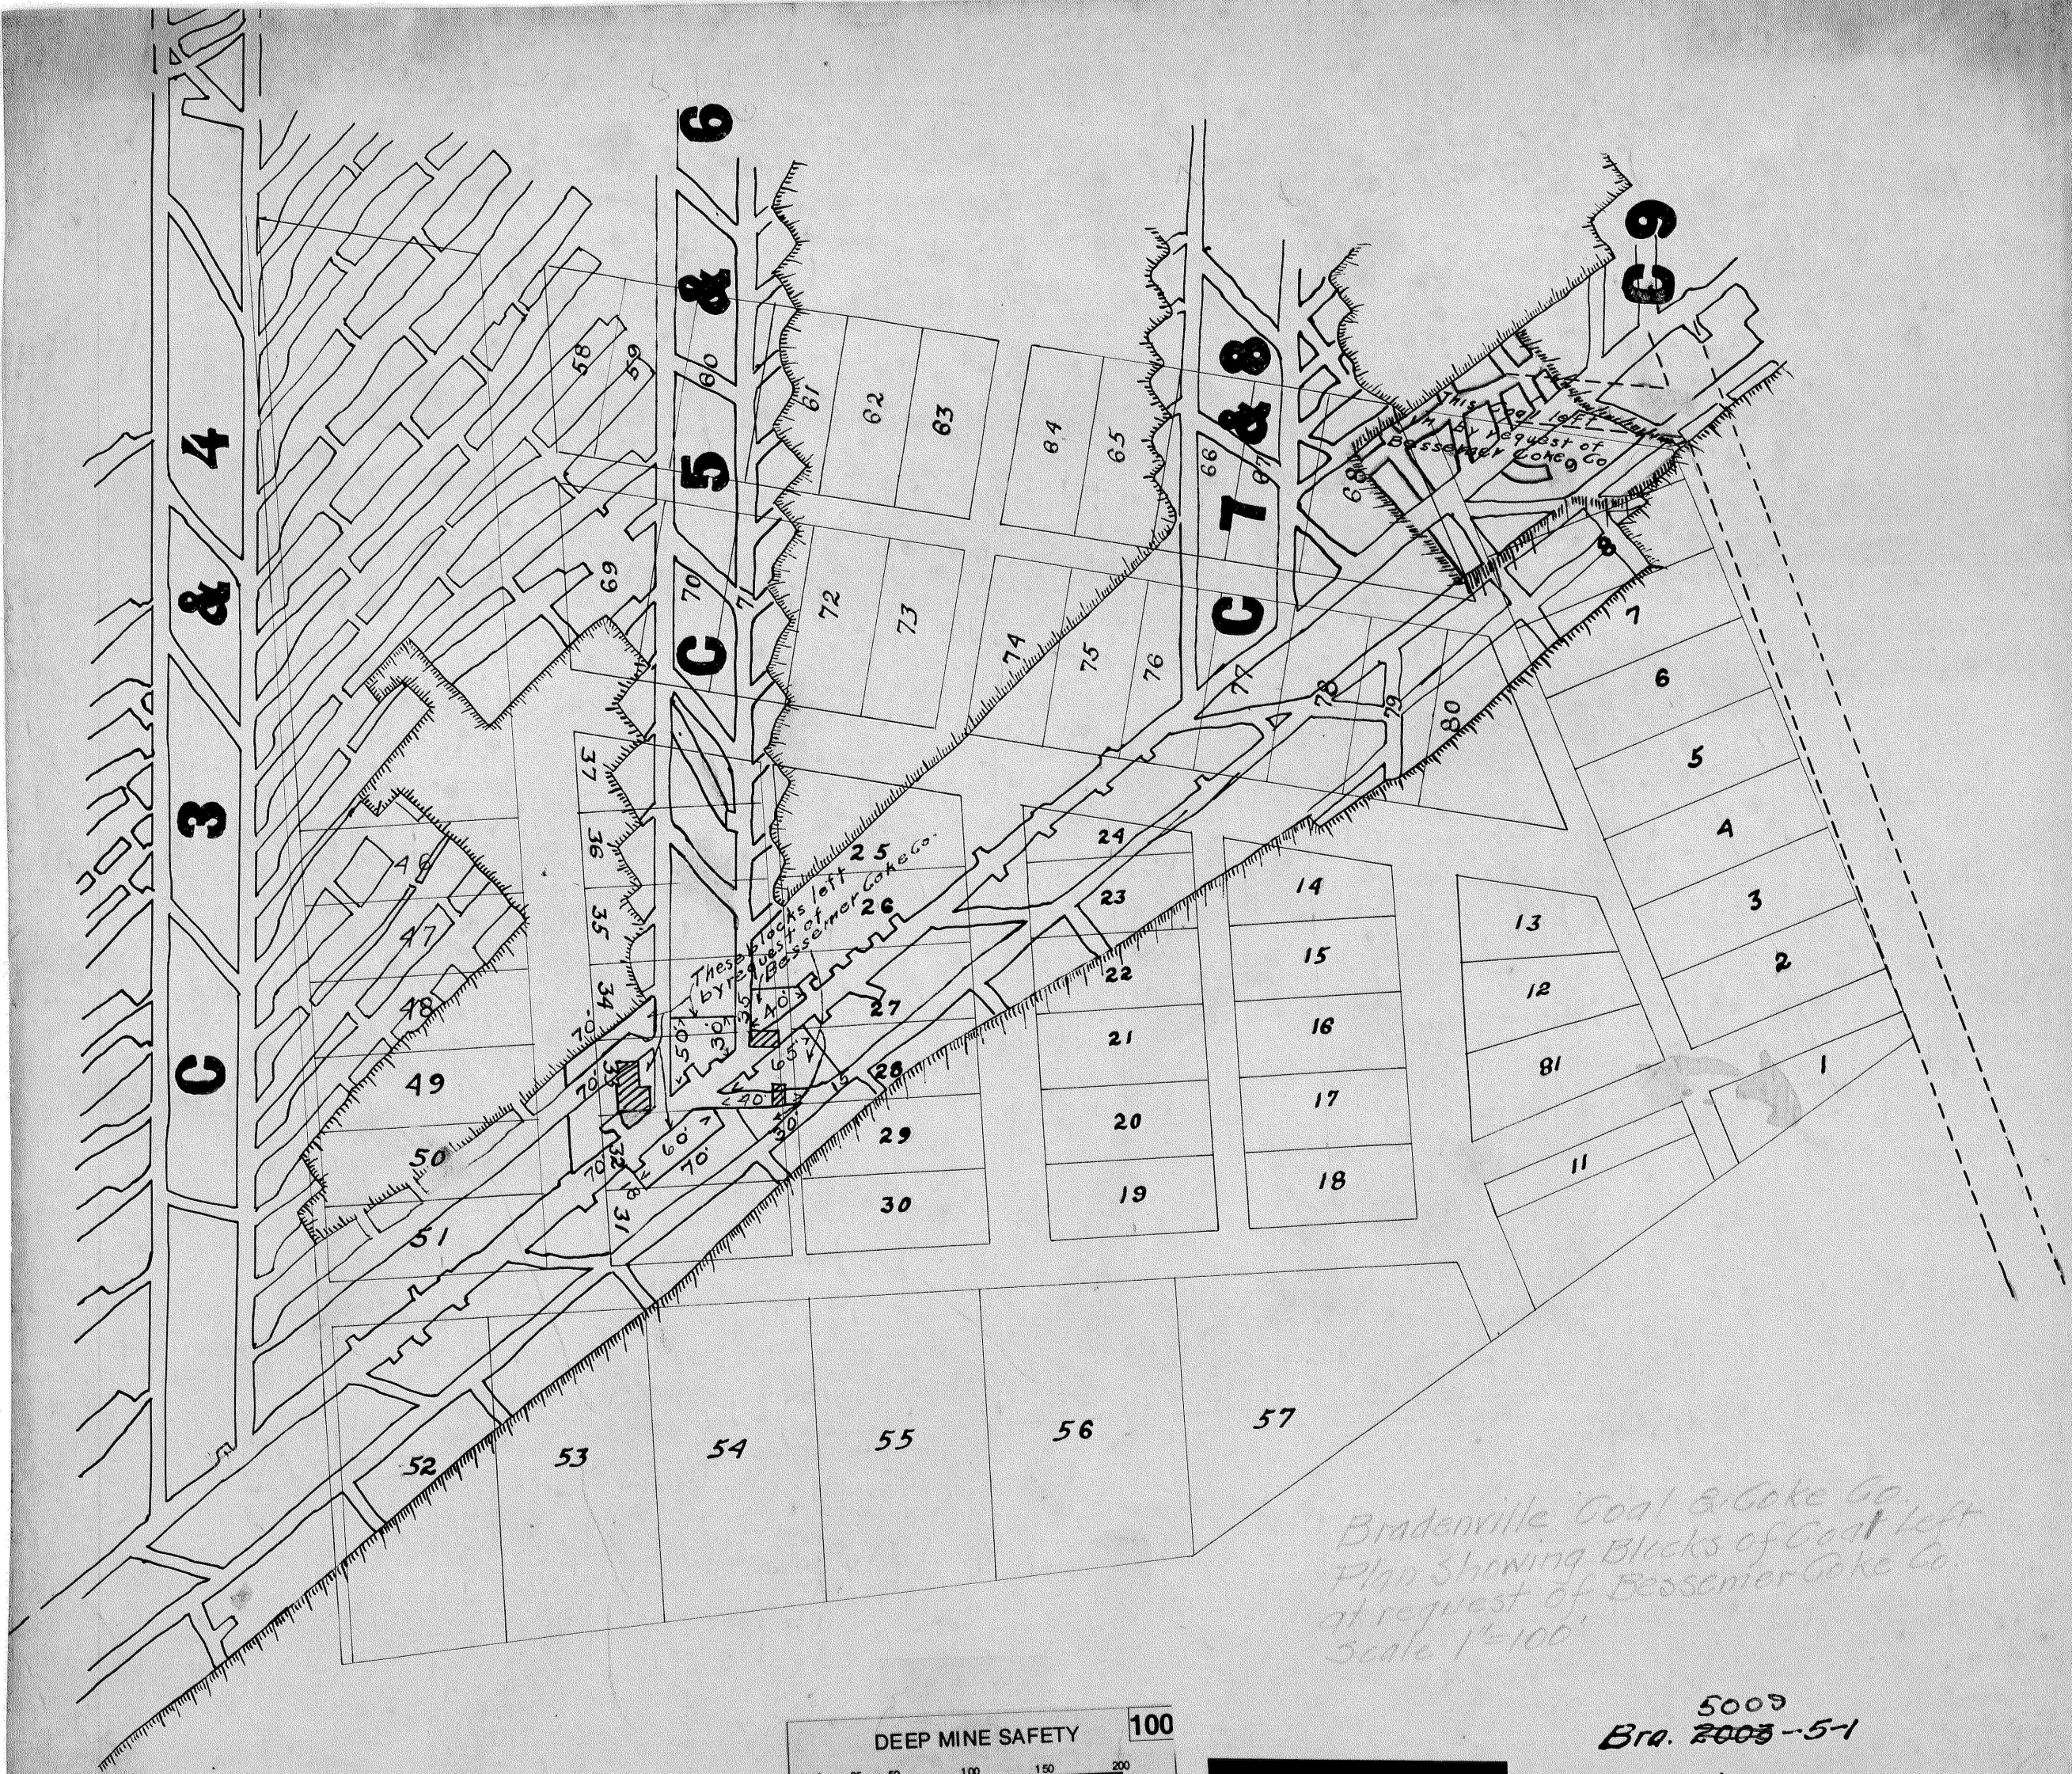

Bradenville Coal & Coke Co.
 Plan showing Blocks of Coal left
 at request of Bessmer Coke Co.
 Scale 1"=100'

5009
 Bra. 2003-5-1

4279