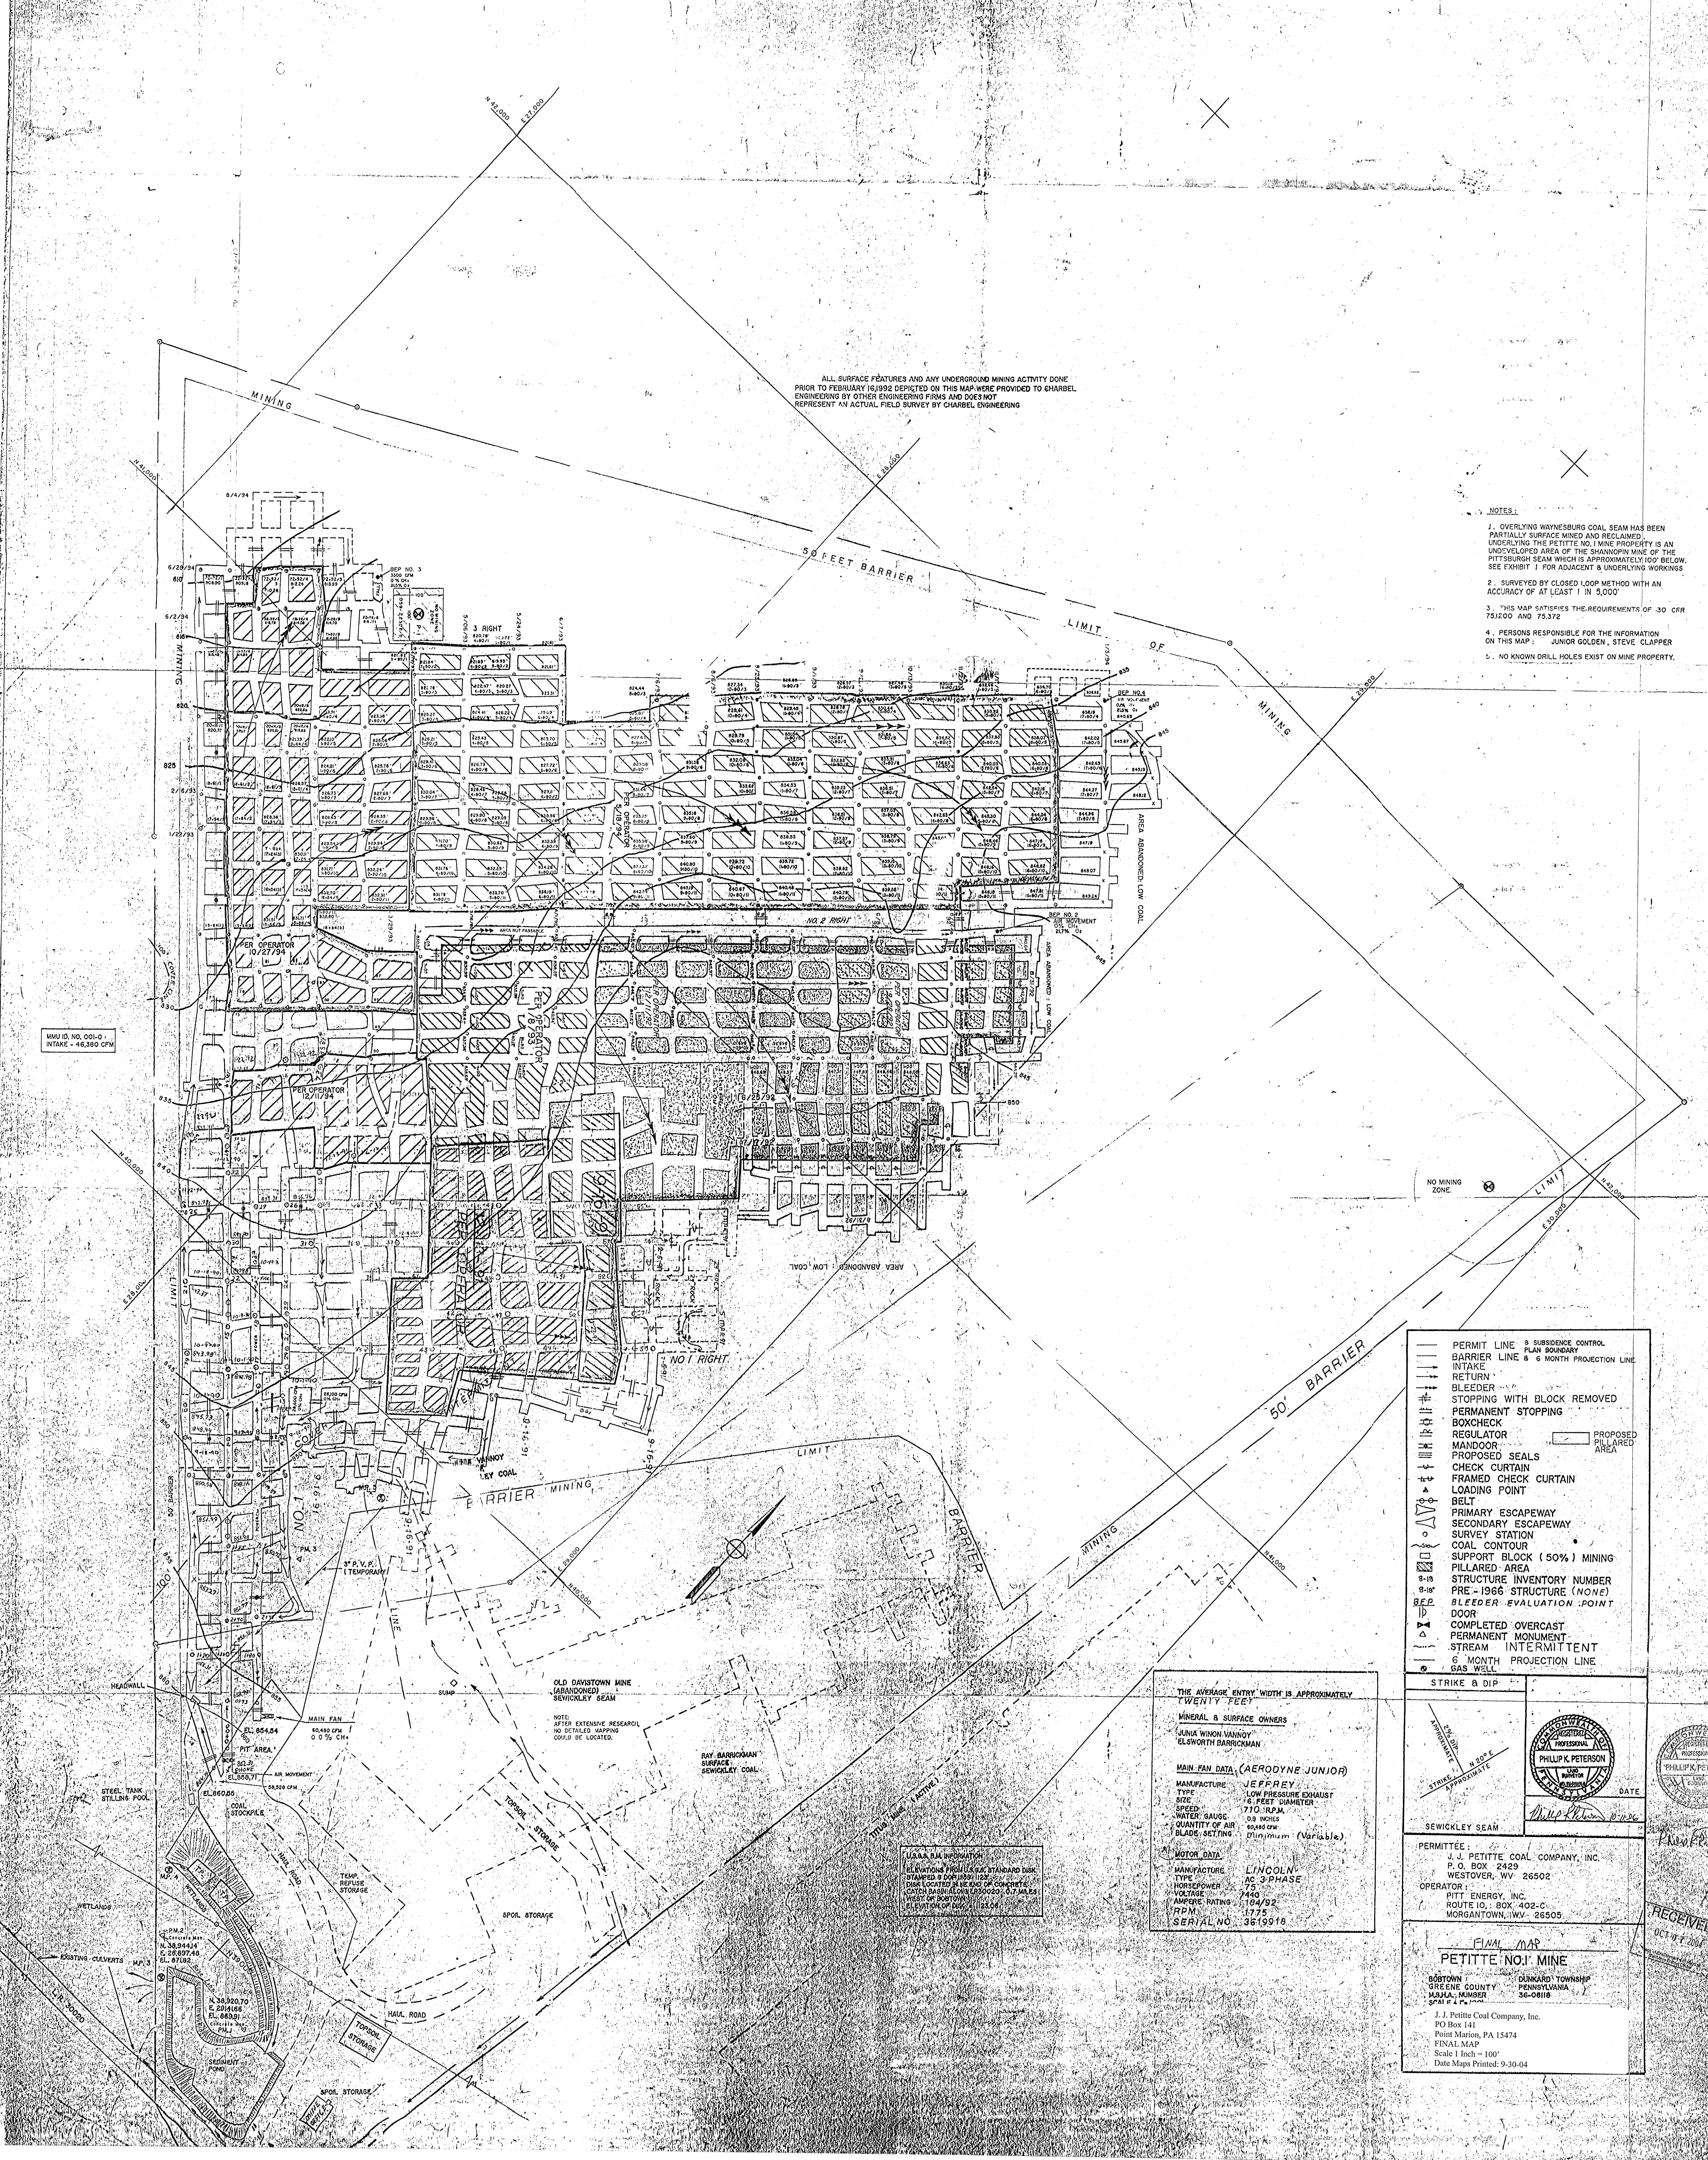

ALL SURFACE FEATURES AND ANY UNDERGROUND MINING ACTIVITY DONE PRIOR TO FEBRUARY 16,1992 DEPICTED ON THIS MAP WERE PROVIDED TO CHARBEL ENGINEERING BY OTHER ENGINEERING FIRMS AND DOES NOT REPRESENT AN ACTUAL FIELD SURVEY BY CHARBEL ENGINEERING

NOTES :

1. OVERLYING WAYNESBURG COAL SEAM HAS BEEN PARTIALLY SURFACE MINED AND RECLAIMED. UNDERLYING THE PETITTE NO. I MINE PROPERTY IS AN UNDEVELOPED AREA OF THE SHANNOPIN MINE OF THE PITTSBURGH SEAM WHICH IS APPROXIMATELY 100' BELOW. SEE EXHIBIT I FOR ADJACENT & UNDERLYING WORKINGS

2. SURVEYED BY CLOSED LOOP METHOD WITH AN ACCURACY OF AT LEAST 1 IN 5,000'

3. THIS MAP SATISFIES THE REQUIREMENTS OF 30 CFR 75.1200 AND 75.372

4. PERSONS RESPONSIBLE FOR THE INFORMATION ON THIS MAP : JUNIOR GOLDEN , STEVE CLAPPER

5. NO KNOWN DRILL HOLES EXIST ON MINE PROPERTY.

—	PERMIT LINE & SUBSIDENCE CONTROL PLAN BOUNDARY
—	BARRIER LINE & 6 MONTH PROJECTION LINE.
→	INTAKE
→→	RETURN
→→→	BLEEDER
	STOPPING WITH BLOCK REMOVED
	PERMANENT STOPPING
	BOXCHECK
R	REGULATOR
	MANDOOR
≡	PROPOSED SEALS
	CHECK CURTAIN
	FRAMED CHECK CURTAIN
▲	LOADING POINT
	BELT
	PRIMARY ESCAPEWAY
	SECONDARY ESCAPEWAY
○	SURVEY STATION
500	COAL CONTOUR
▭	SUPPORT BLOCK (50%) MINING
▨	PILLARED AREA
8-18	STRUCTURE INVENTORY NUMBER
8-18*	PRE - 1966 STRUCTURE (NONE)
BEP	BLEEDER EVALUATION POINT
	DOOR
⋈	COMPLETED OVERCAST
△	PERMANENT MONUMENT
	STREAM INTERMITTENT
—	6 MONTH PROJECTION LINE
●	GAS WELL
▭	PROPOSED PILLARED AREA

STRIKE & DIP

2% DIP APPROXIMATE
STRIKE N 20° E APPROXIMATE

SEWICKLEY SEAM

PHILLIP K. PETERSON

DATE

Phillip K Peterson 10-11-96

THE AVERAGE ENTRY WIDTH IS APPROXIMATELY *TWENTY FEET*

MINERAL & SURFACE OWNERS

JUNIA WINON VANNOY
ELSWORTH BARRICKMAN

MAIN FAN DATA (AERODYNE JUNIOR)

MANUFACTURE	JEFFREY
TYPE	LOW PRESSURE EXHAUST
SIZE	6 FEET DIAMETER
SPEED	710 R.P.M.
WATER GAUGE	0.9 INCHES
QUANTITY OF AIR	60,460 CFM
BLADE SETTING	Minimum (Variable)

MOTOR DATA

MANUFACTURE	LINCOLN
TYPE	AC 3 PHASE
HORSEPOWER	75
VOLTAGE	440
AMPERE RATING	184/92
RPM	1775
SERIAL NO	3619918

U.S.G.S. B.M. INFORMATION

ELEVATIONS FROM U.S.G.S. STANDARD DISK STAMPED 8 DOP 1959 1123
DISK LOCATED IN NE END OF CONCRETE CATCH BASIN ALONG LR30020 0.7 MILES WEST OF BOBTOWN
ELEVATION OF DISK = 1123.06

PERMITTEE :
J. J. PETITTE COAL COMPANY, INC.
P. O. BOX 2429
WESTOVER, WV 26502

OPERATOR :
PITT ENERGY, INC.
ROUTE 10, BOX 402-C
MORGANTOWN, WV 26505

FINAL MAP

PETITTE NO. 1 MINE

BOBTOWN	DUNKARD TOWNSHIP
GREENE COUNTY	PENNSYLVANIA
M.S.H.A. NUMBER	36-08118

J. J. Petitte Coal Company, Inc.
PO Box 141
Point Marion, PA 15474
FINAL MAP
Scale 1 Inch = 100'
Date Maps Printed: 9-30-04

RECEIVED
OCT 0 1 200