


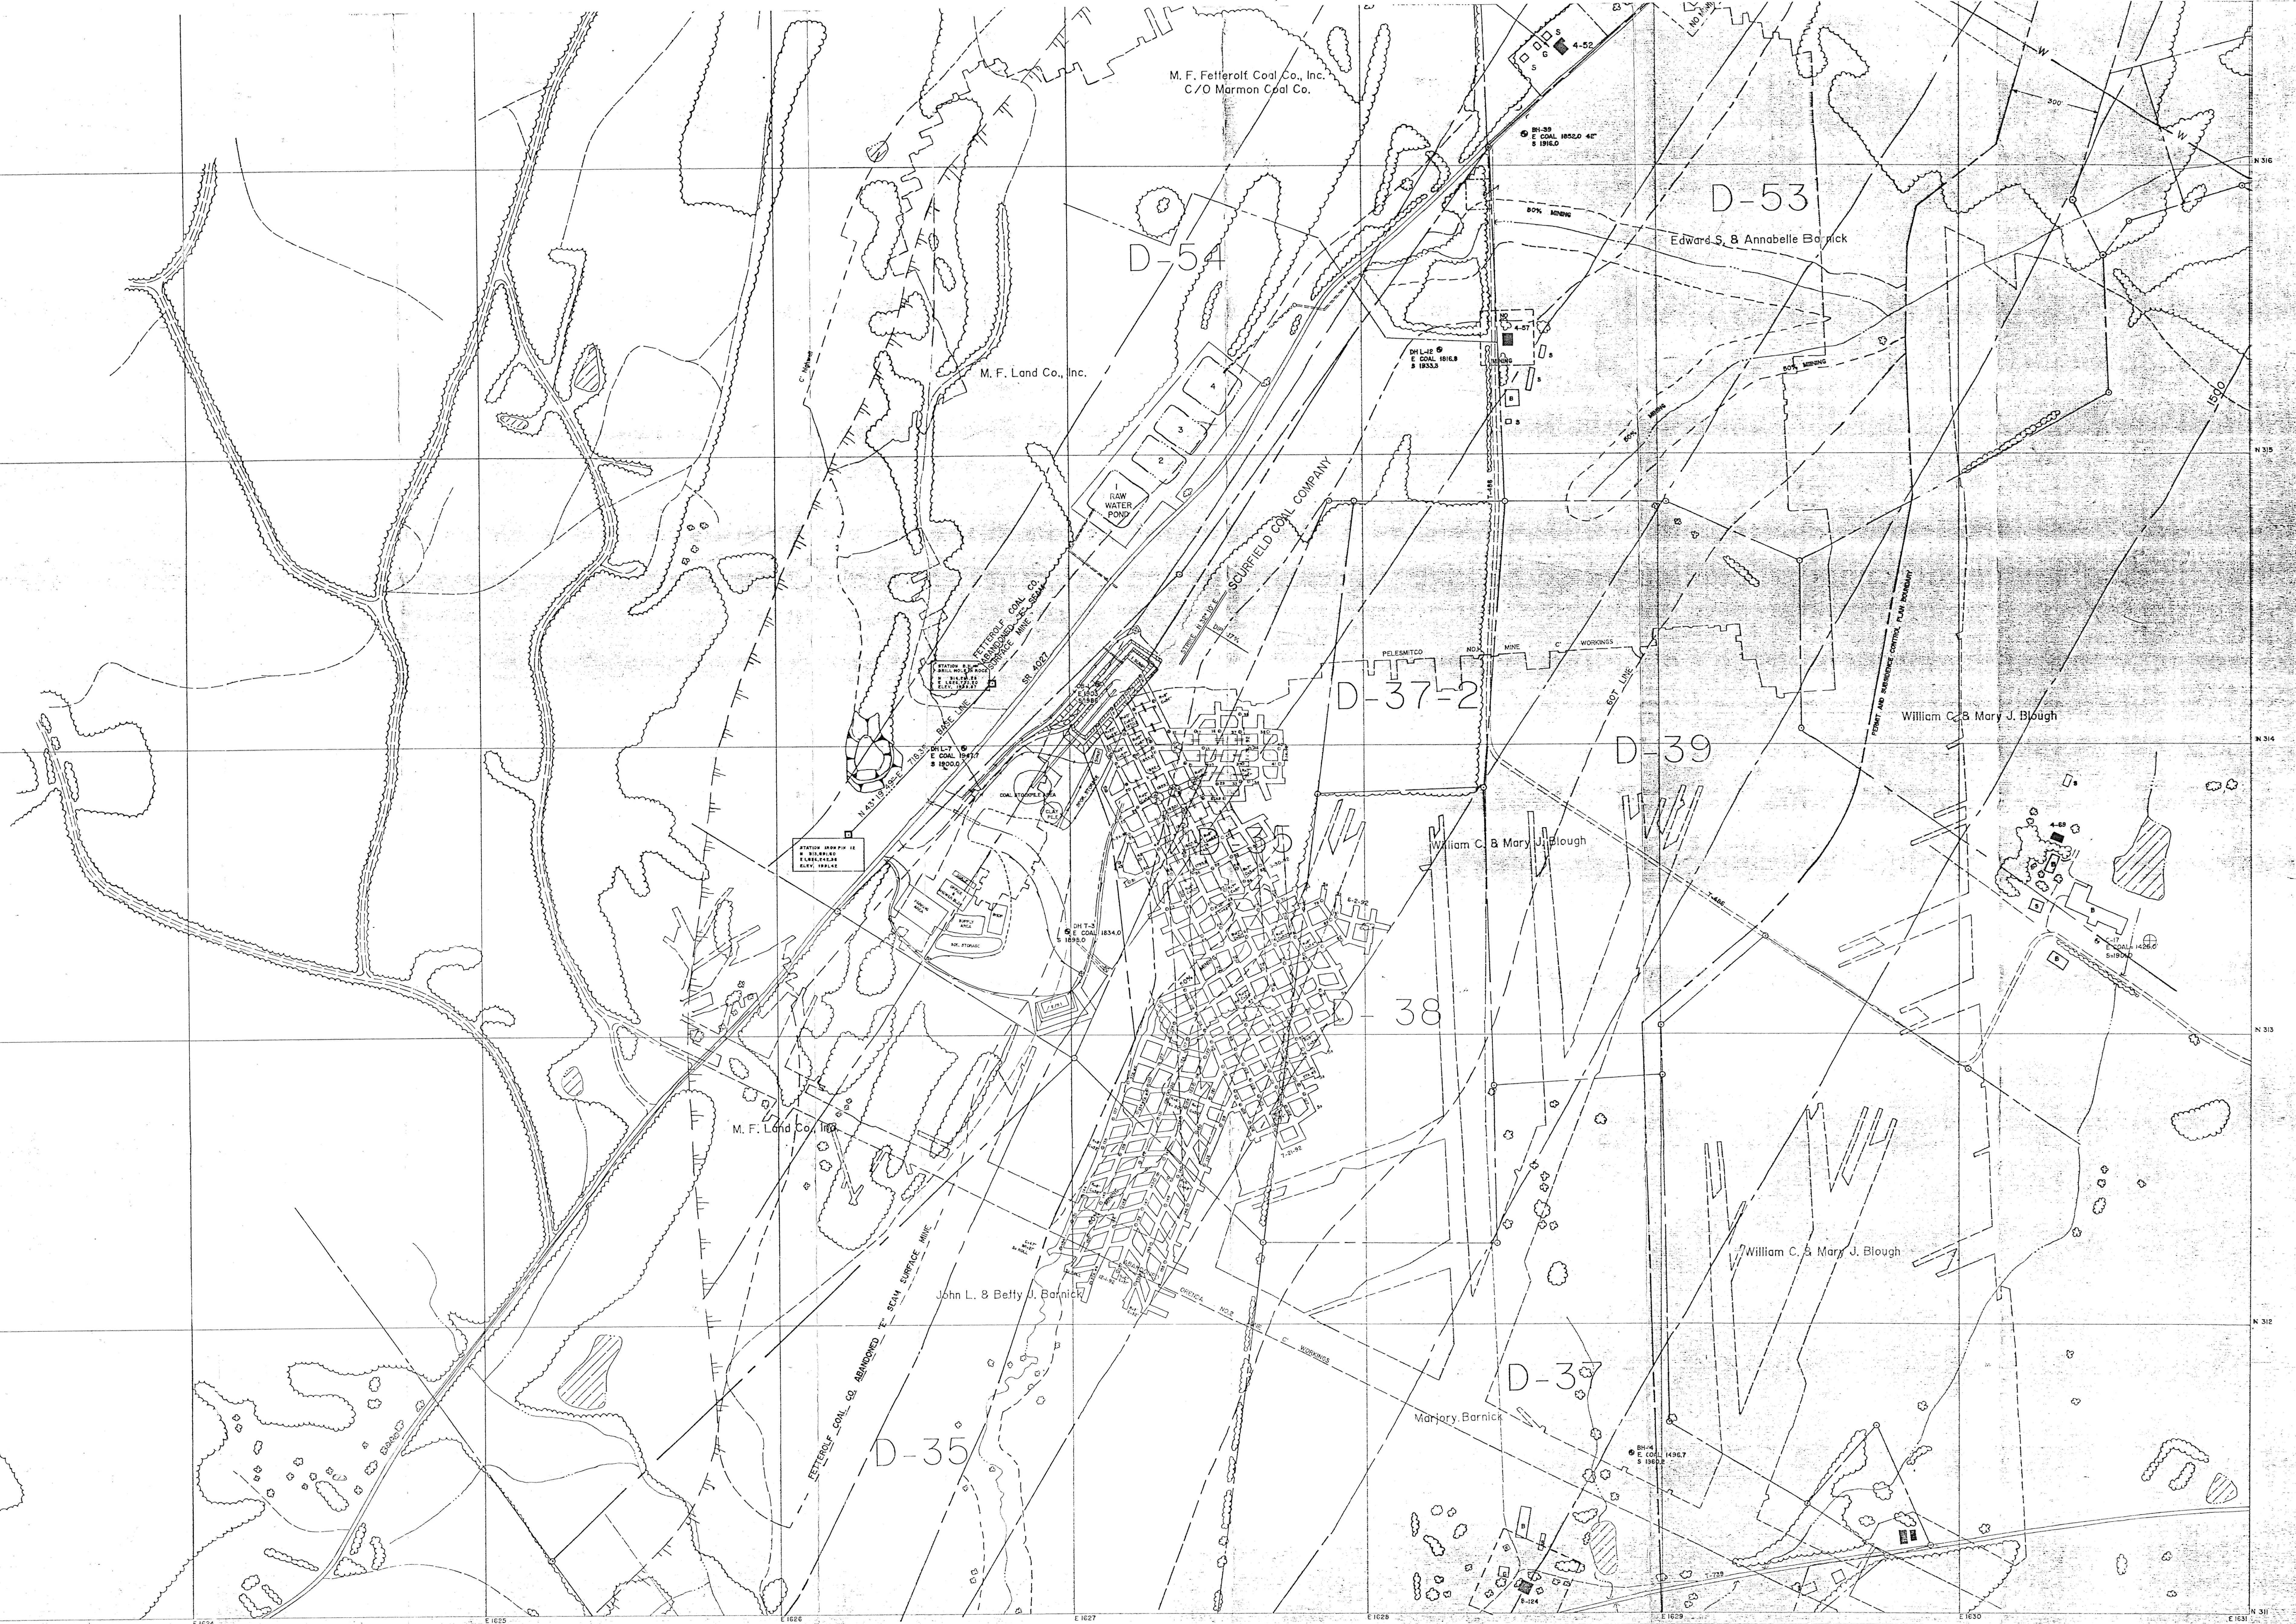

RECEIVED
DEC 11 1992
Dept. of Environmental Protection
McMurray District Office

PELESMITCO, INC
PARADISE MINE
UP-TO-DATE WORKINGS MAP
MINE IDLED: DEC. 1, 1992
PERMIT #56901302

PELESMITCO, INC
237 HILL STREET
JENNERS, PA 15546
(610) 629-6033

P4

4286

JENNER TOWNSHIP & JENNERSTOWN BORO
SOMERSET COUNTY
PENNSYLVANIA

NOTE: D-#S REPRESENT SUBSURFACE OWNERSHIP BY M.F. LAND CO., INC.

LEGEND

- UNPAVED ROAD
- PAVED ROAD
- U.S. ROUTE
- INTERSTATE
- LEGISLATIVE ROUTE
- TOWNSHIP ROUTE
- RAILROAD
- LAKE, POND
- FENCE
- SWAMP
- WOODS LINE
- TRVERSE STATION
- PHOTOGRAMMETRIC
- POT ELEVATION
- COY TOUS
- PHOTO CENTER
- UPPER FREEPORT COAL CONTOURS
- UPPER KITTANNOWHILL COAL CONTOURS

SCALE: 1" = 200'

200' 0 200' 400' 600' 800'

NORTH

SHEET INDEX

PLANIMETRIC SERIES

SHEET NO. A-2