


SPRINGFIELD EXTENSION MAP

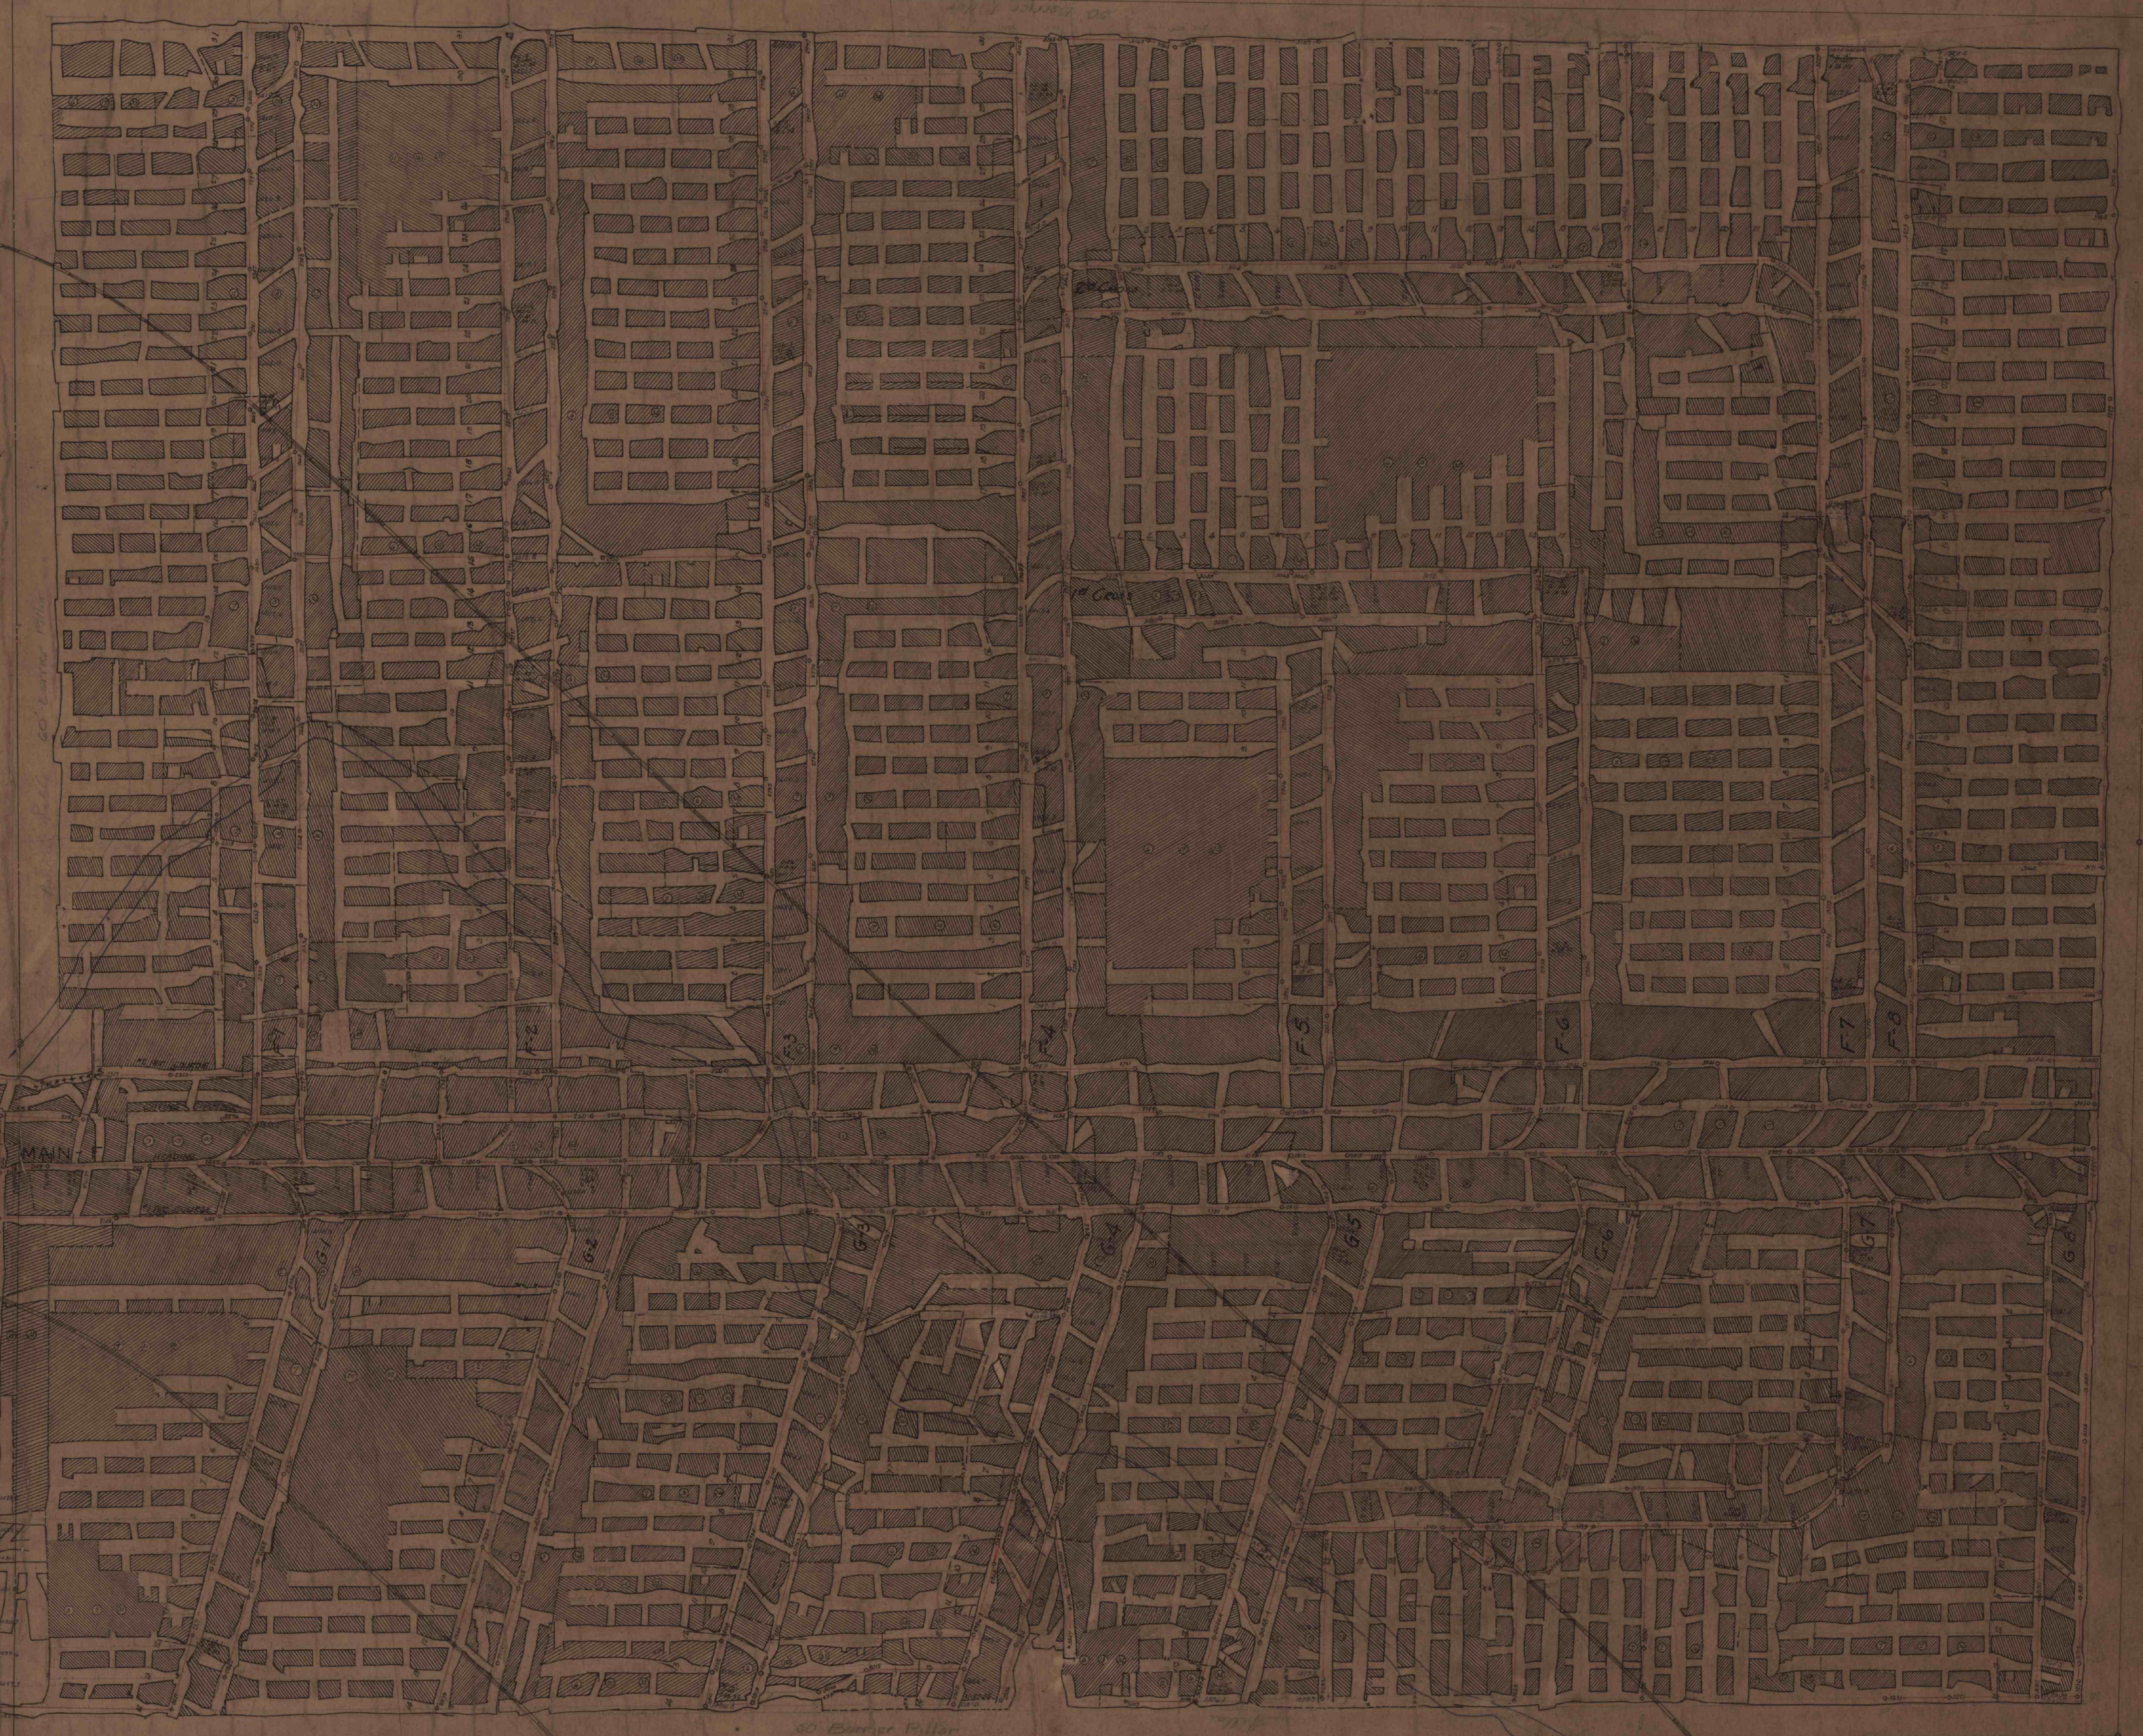

EXTENSION 'A'

EXTENSION 'B'

MAIN DIP

