


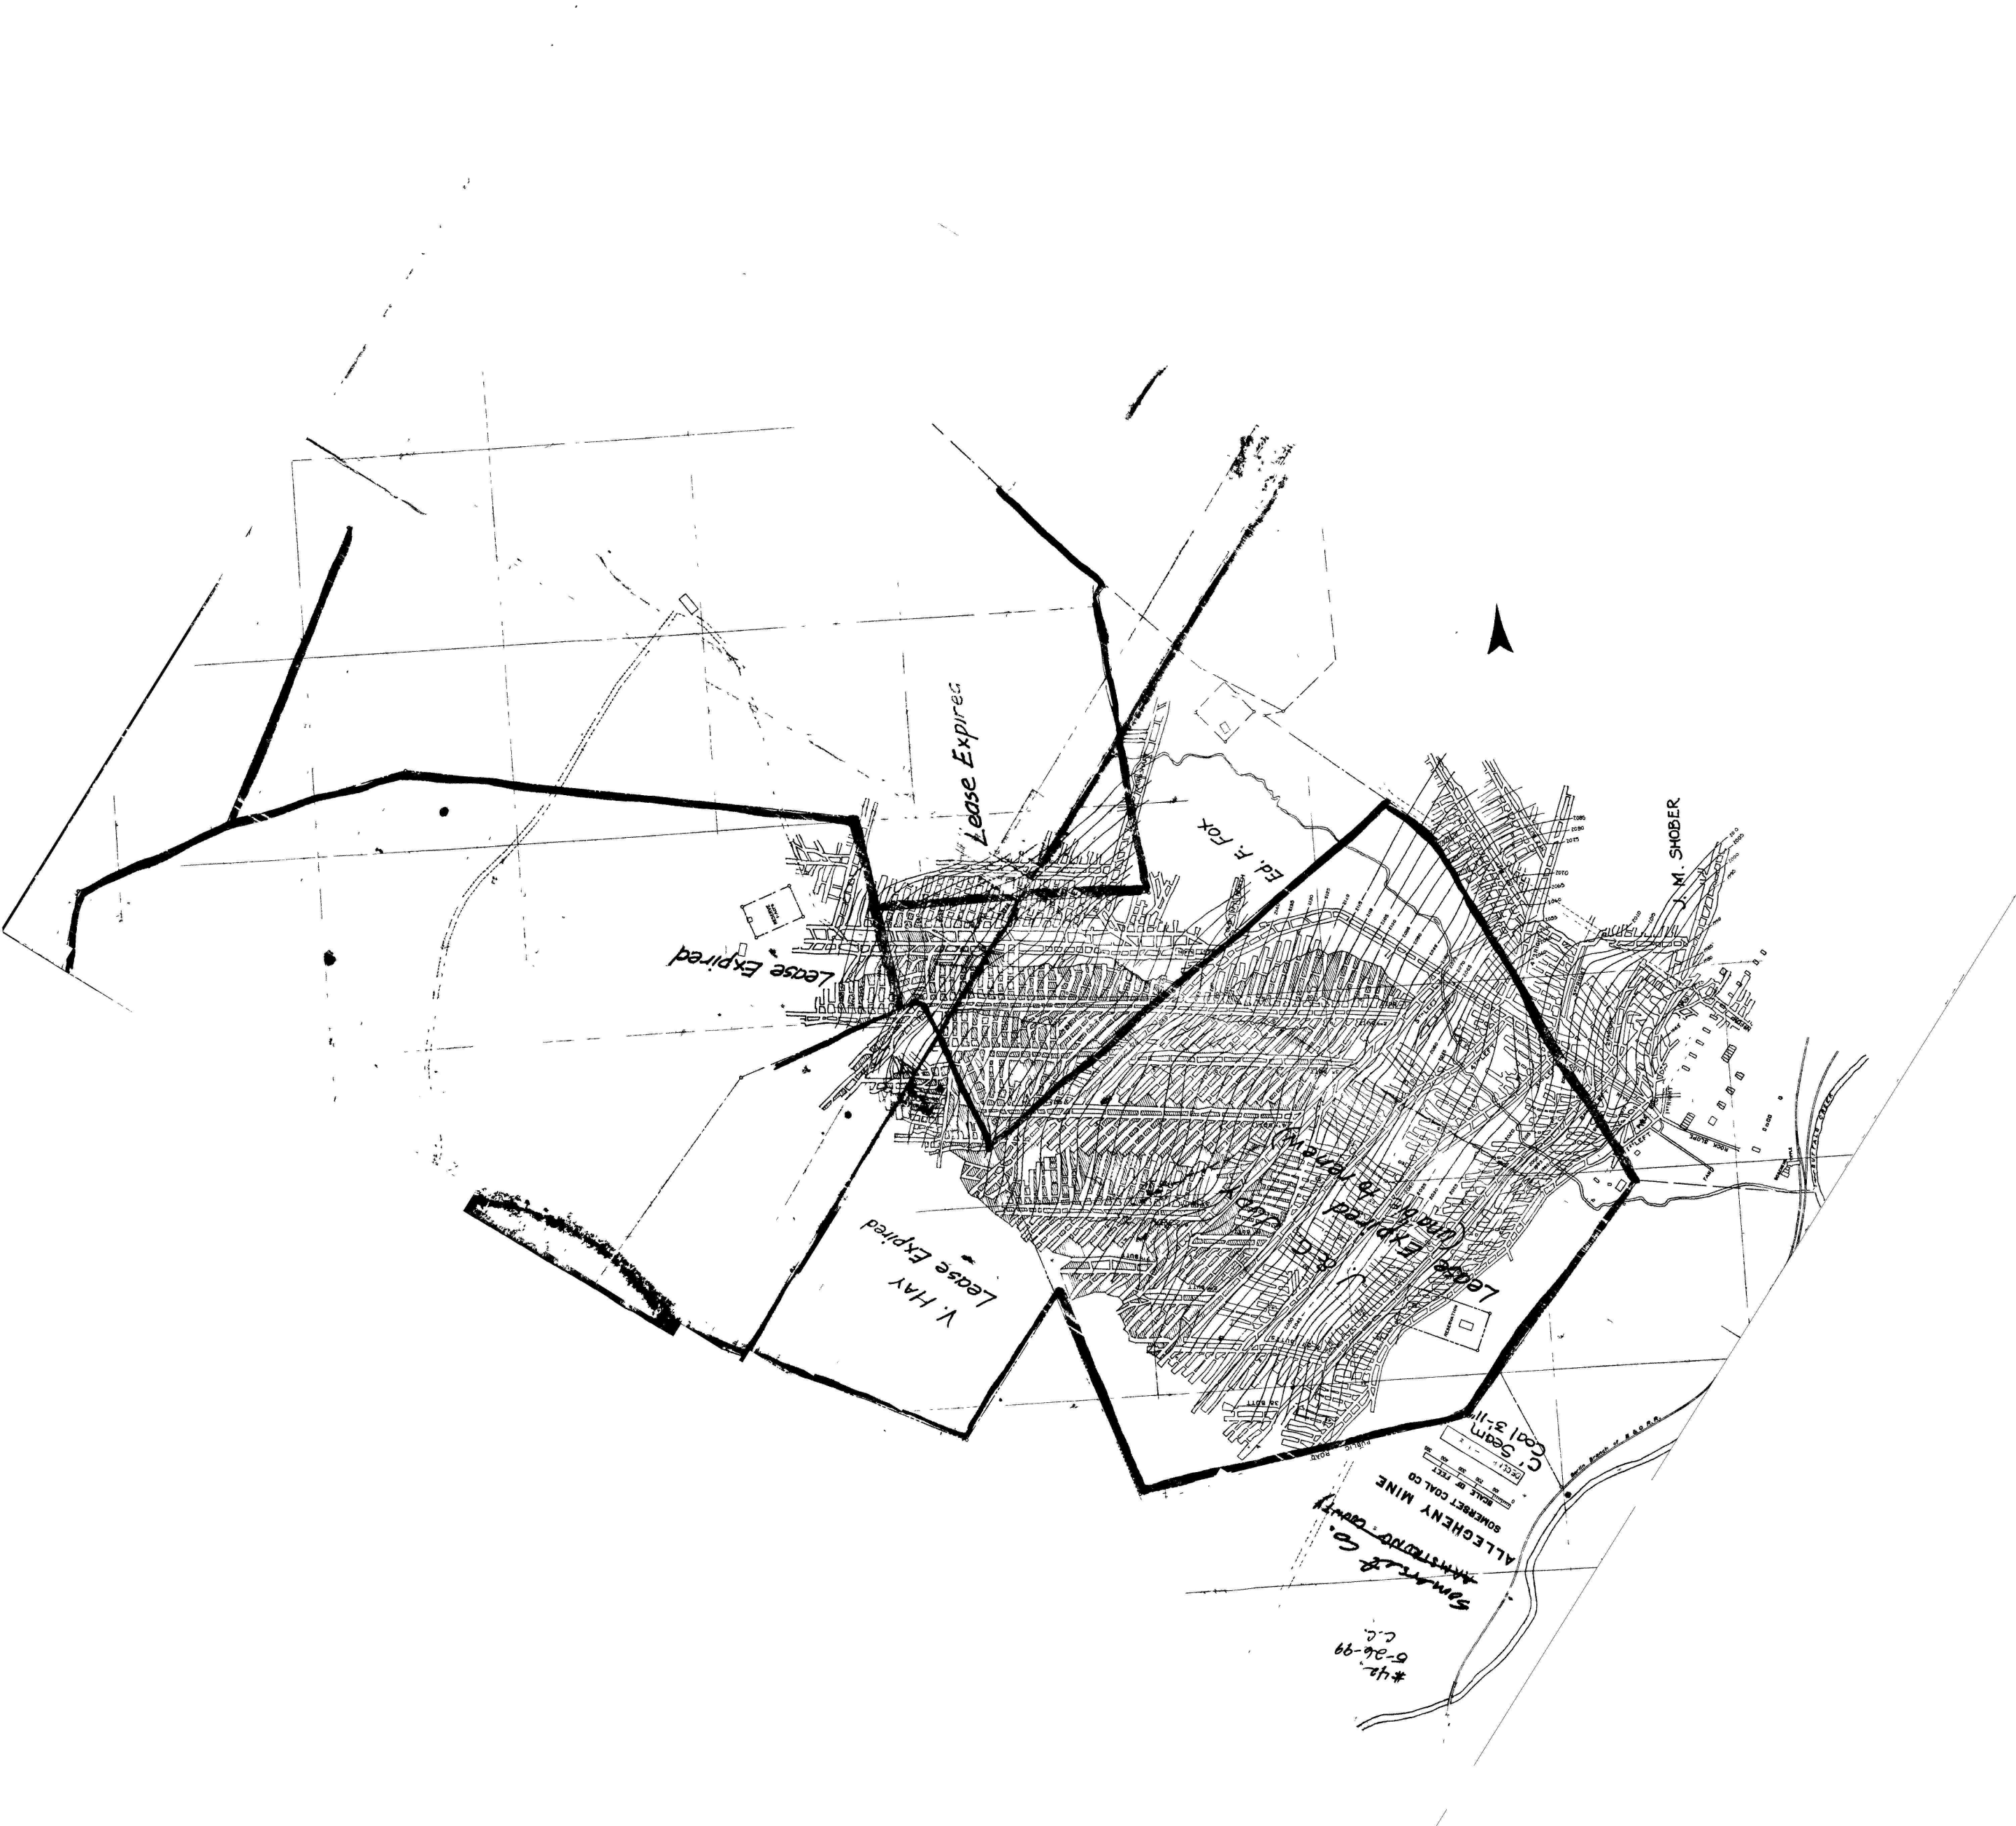

Lease Expires

Ed. F. Fox

Lease Expired

Y. Hay
Lease Expired

M. Shober

Allegheny Mine
Somerset Coal Co.
3-11-11

#42
6-26-99
C.C.

SCALE OF FEET
0 100 200 300 400 500 600 700 800 900 1000