


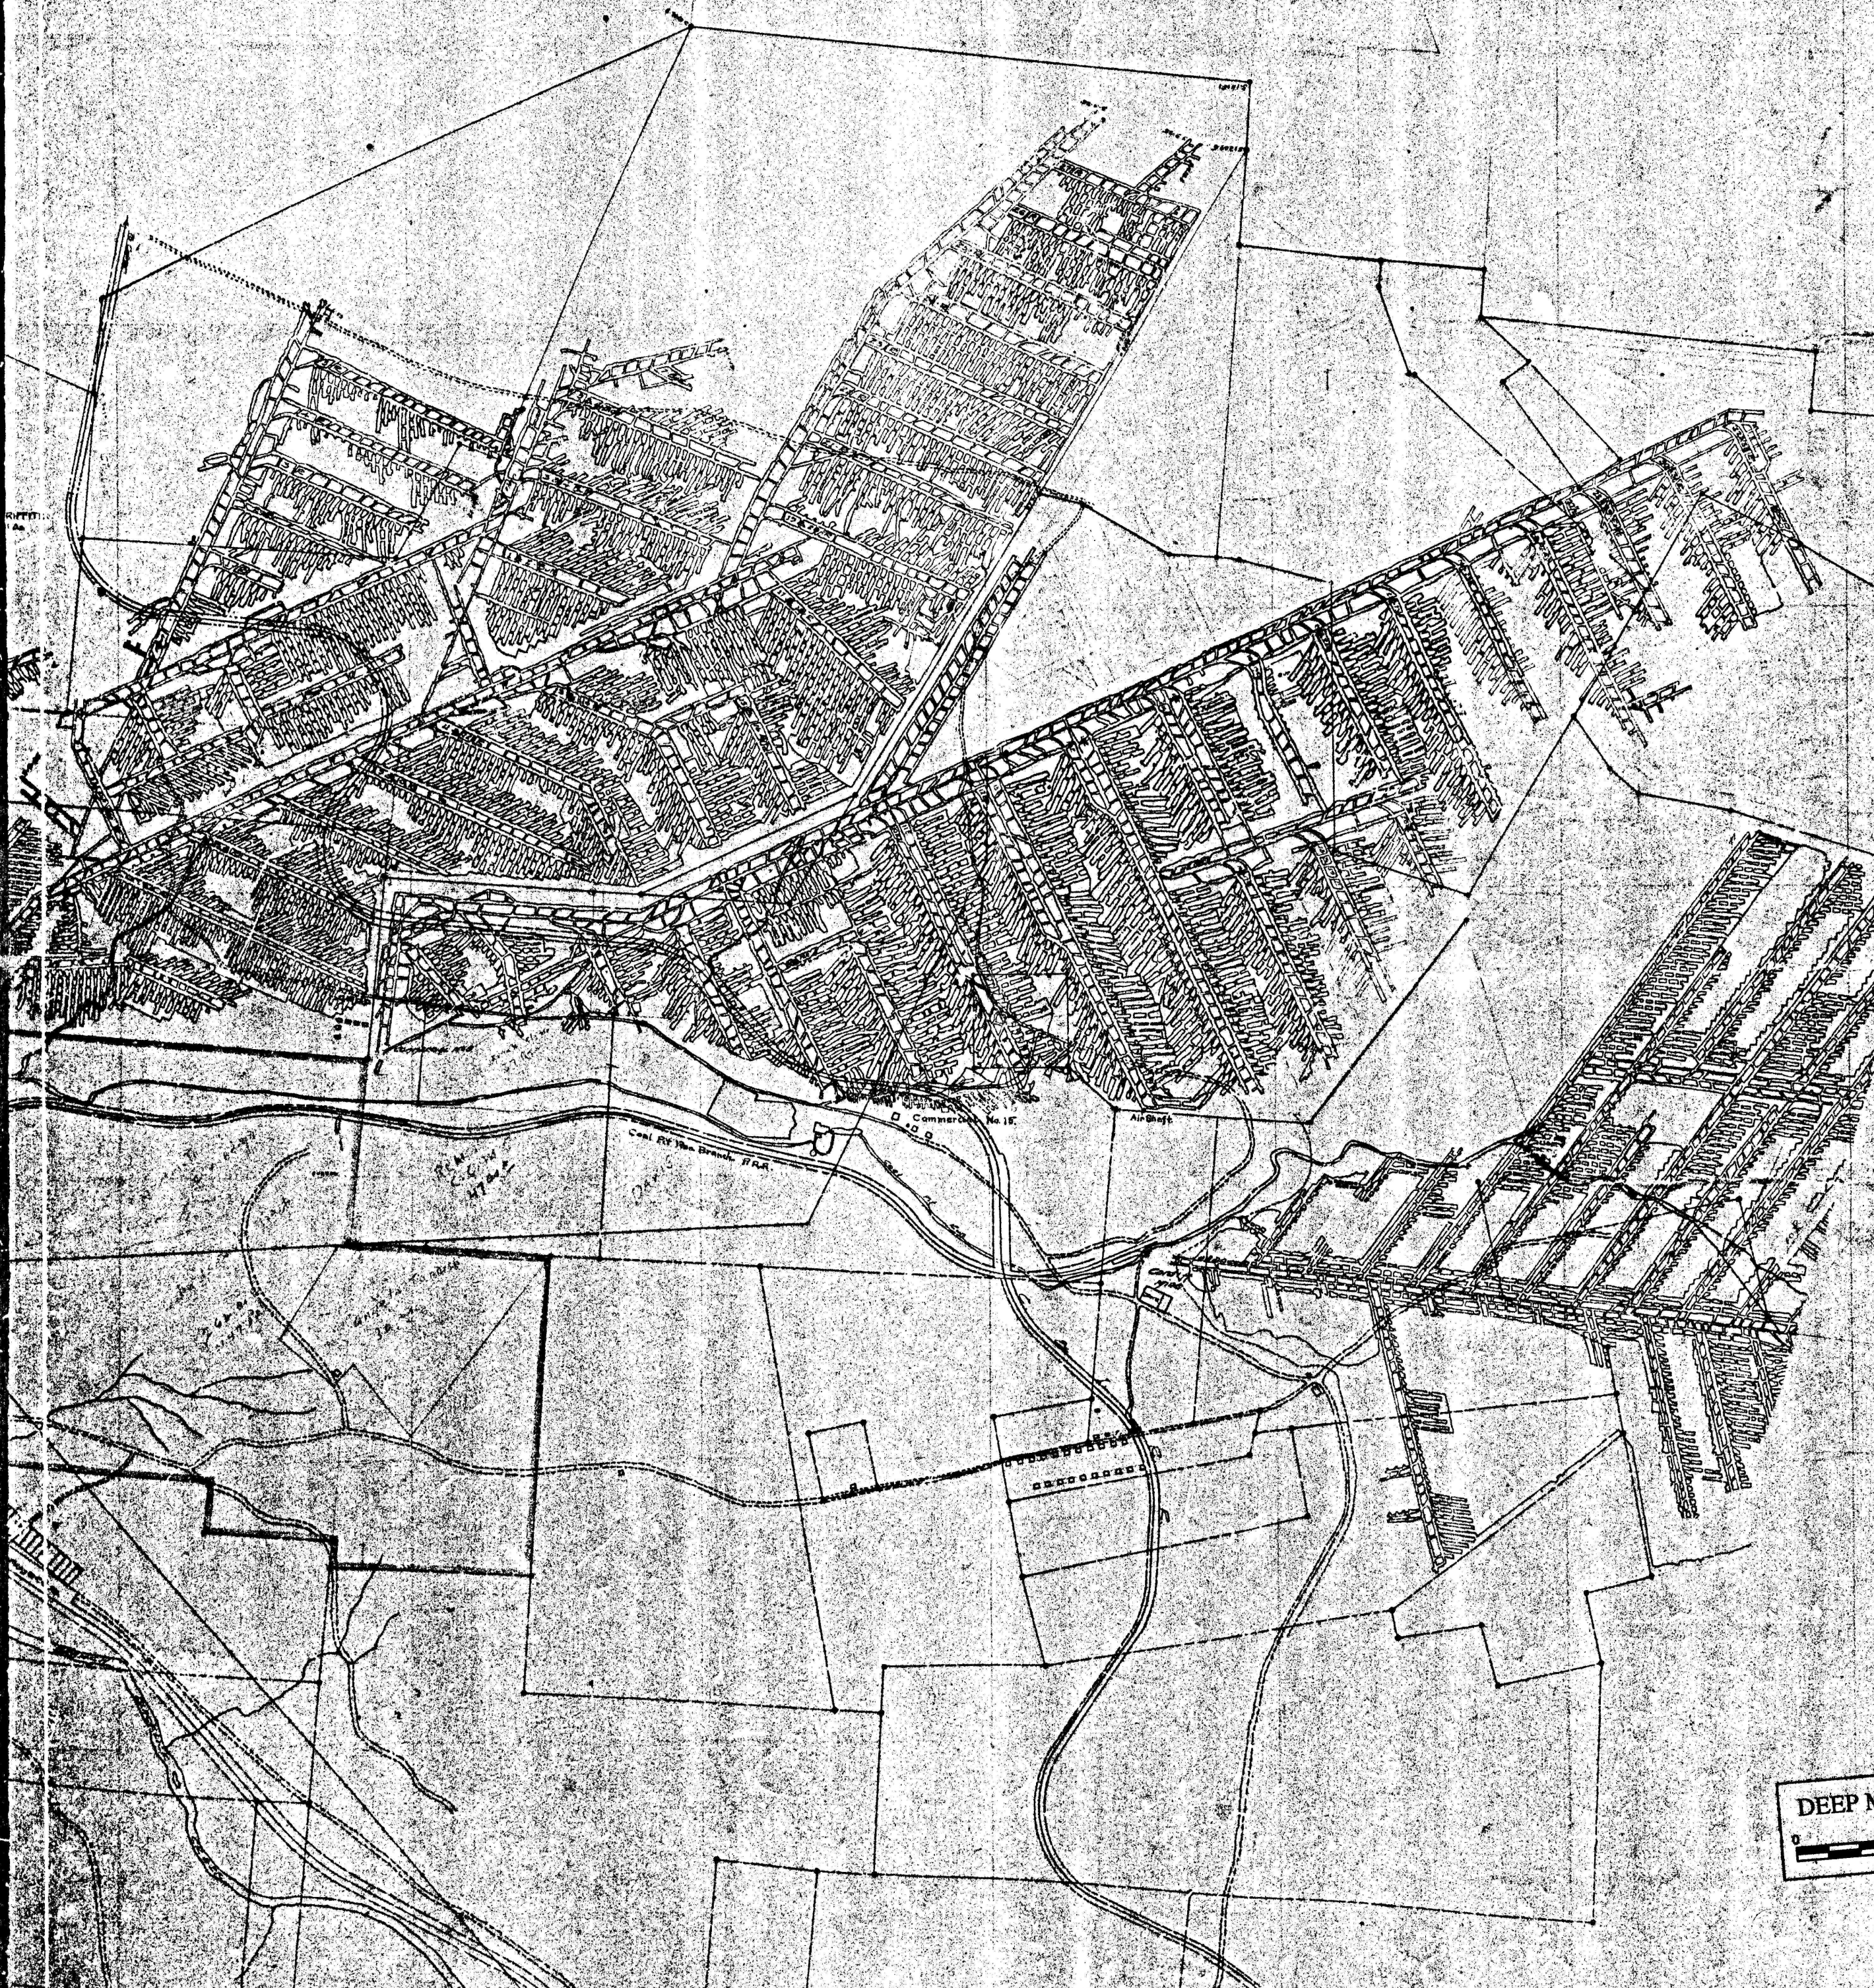

ESSEX COAL CO.

DEEP MINE SAFETY 400
0 400 800
Feet