


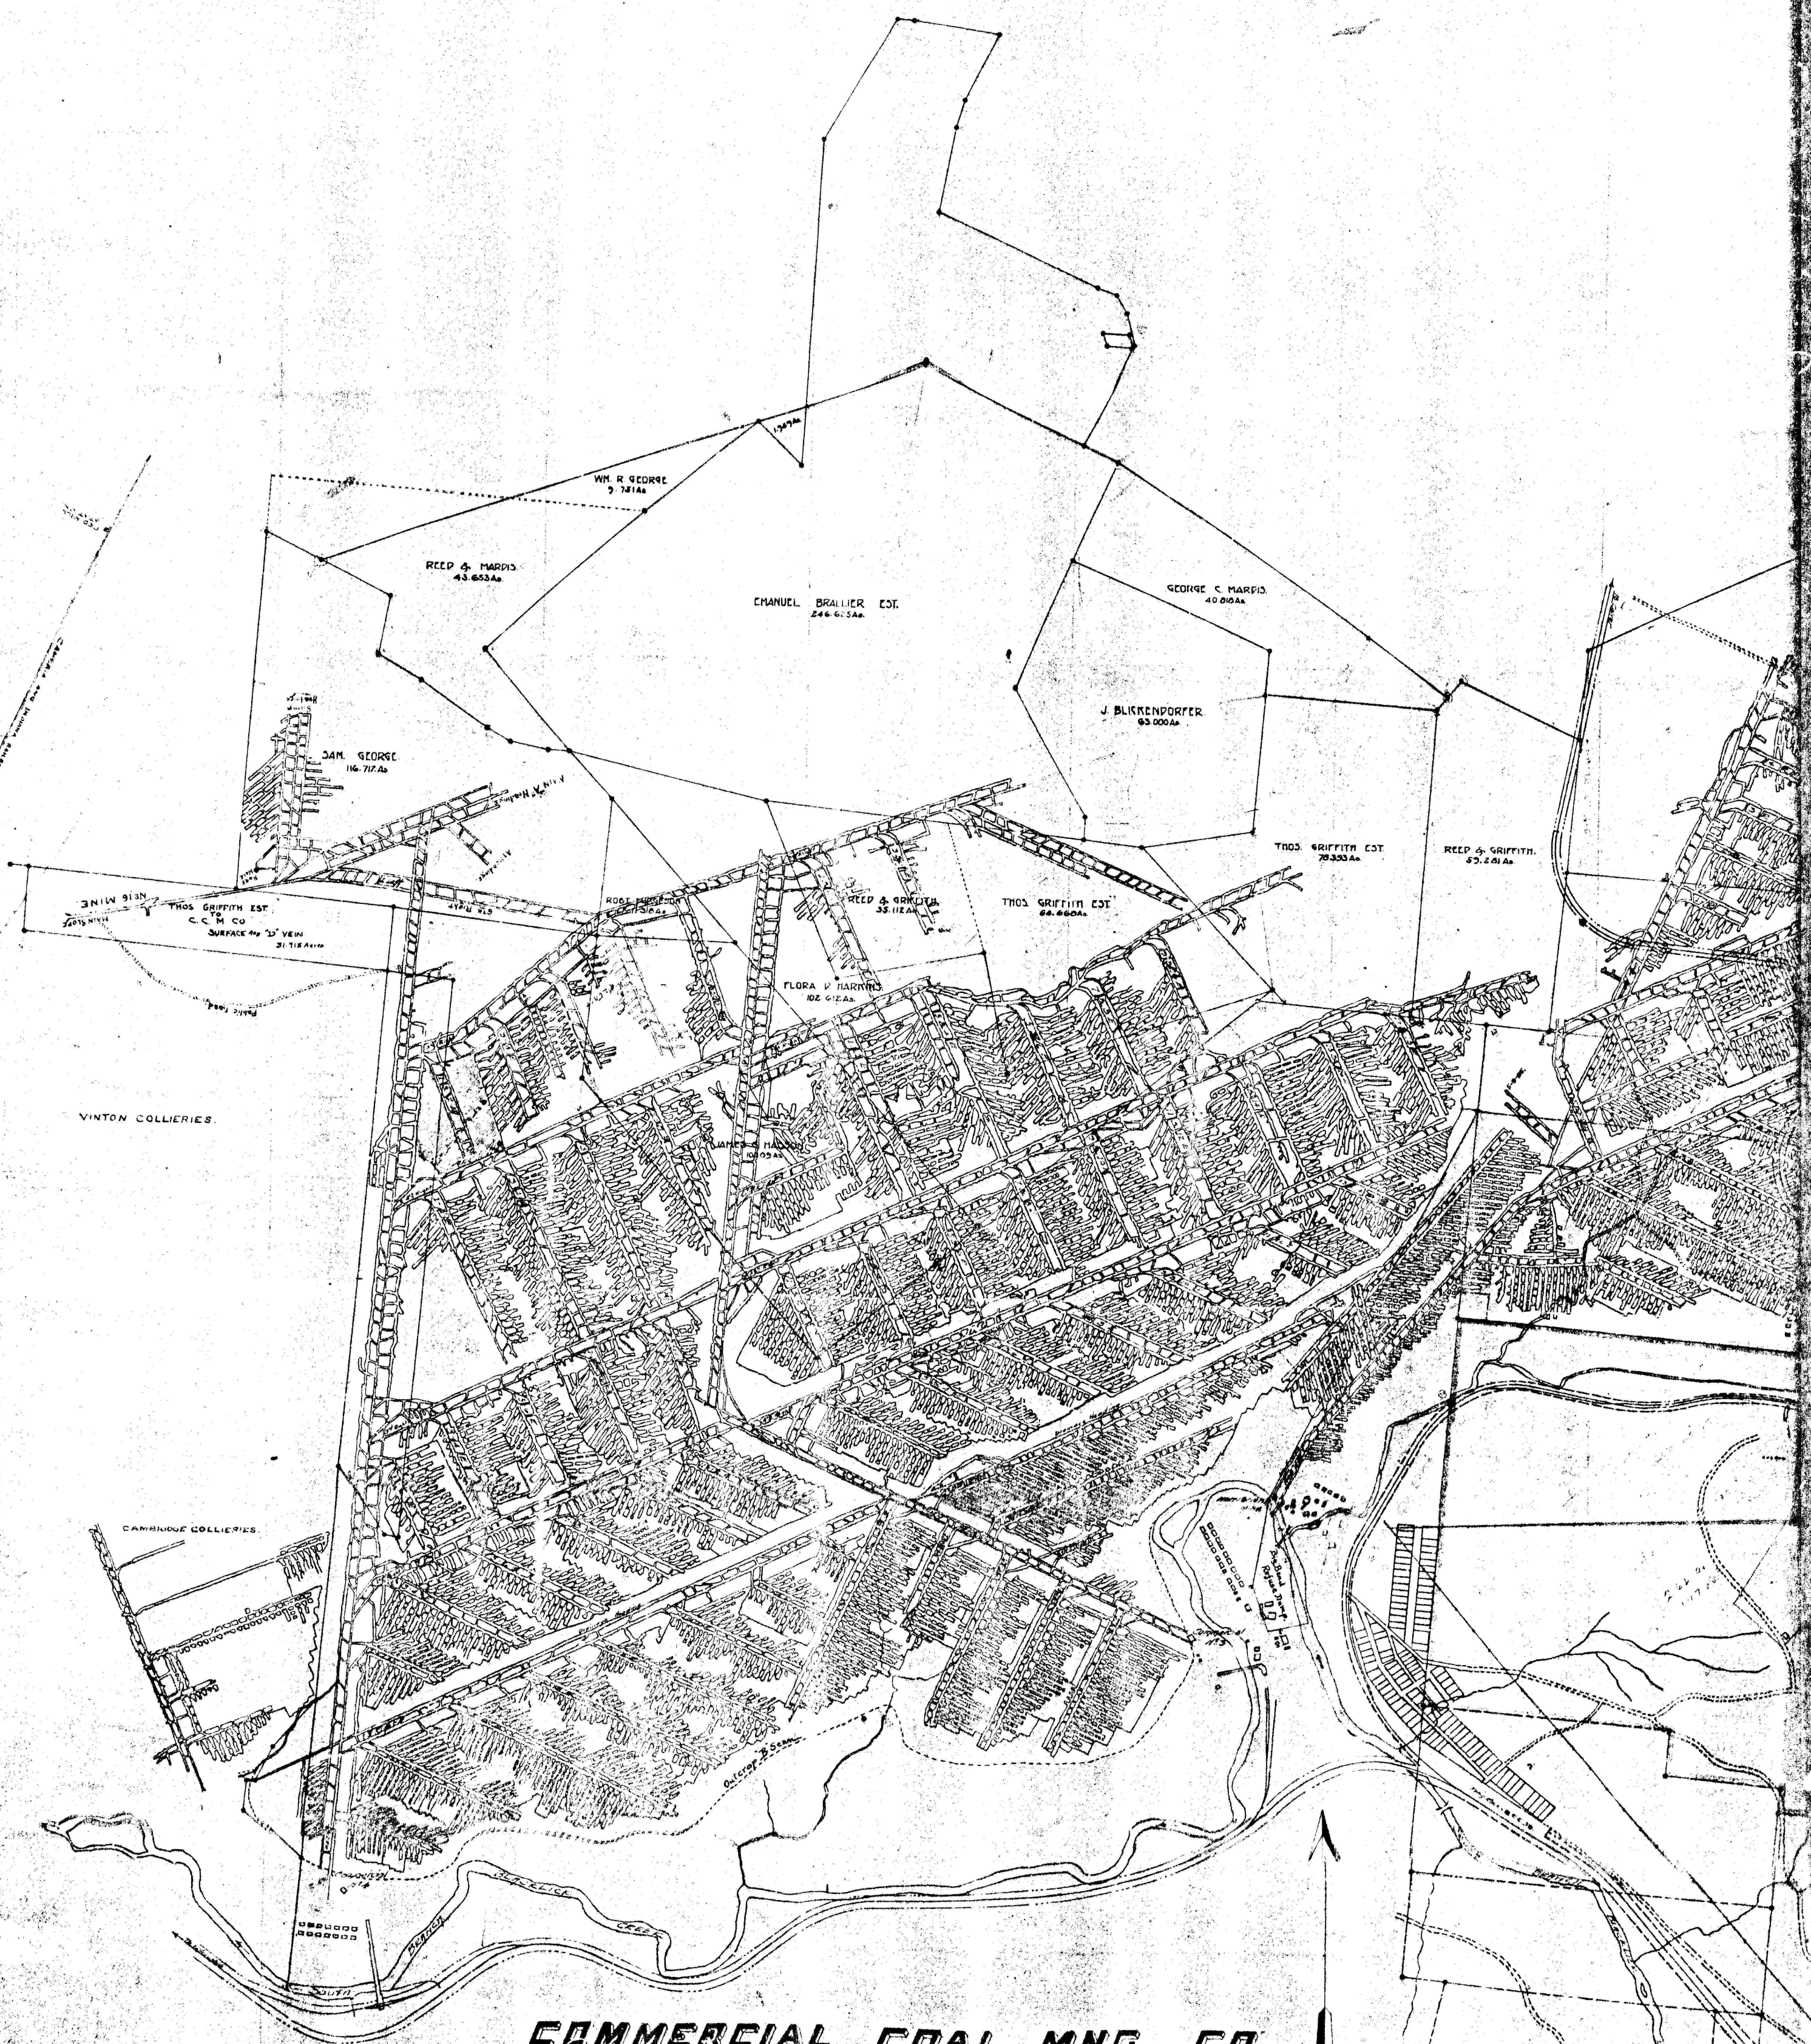

COMMERCIAL COAL MNG. CO.

At Twin Rocks, Pa. **MINE 3, 4, 5, 16,** & Adjoining Mines.

SCALE 400' to 1"

DEEP MINE SAFETY 400

0 400 800 Feet