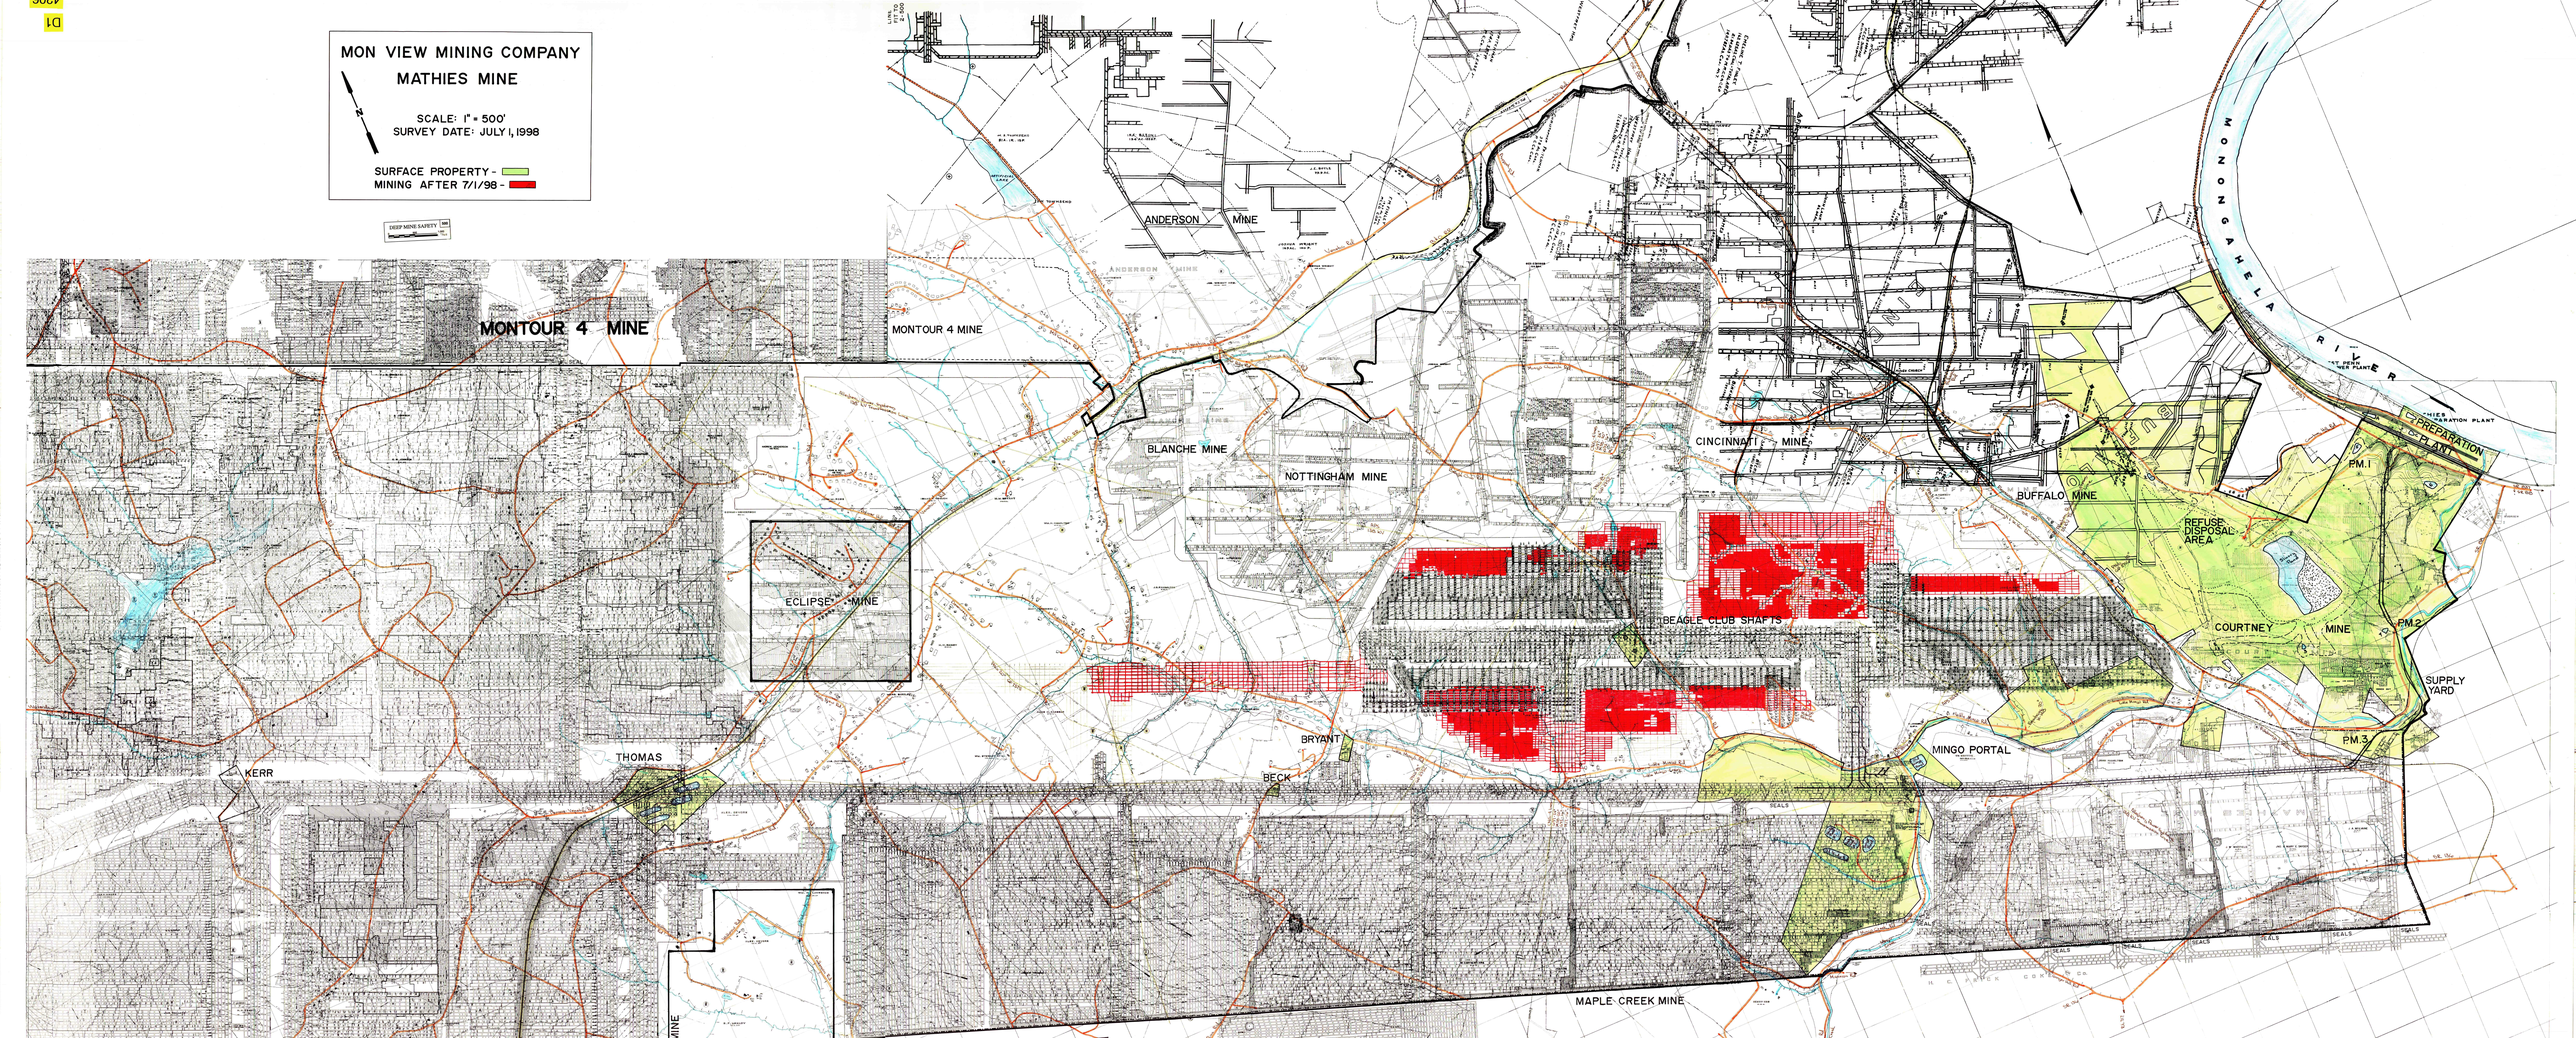

MON VIEW MINING COMPANY
MATHIES MINE
SCALE: 1" = 500'
SURVEY DATE: JULY 1, 1998
SURFACE PROPERTY -
MINING AFTER 7/1/98 -
DEEP MINE SAFETY
MONTOUR 4 MINE
ANDERSON MINE
BLANCHE MINE
NOTTINGHAM MINE
CINCINNATI MINE
BUFFALO MINE
ECLIPSE MINE
BEAGLE CLUB SHAFTS
REFUSE DISPOSAL AREA
PREPARATION PLANT
PM.1
PM.2
PM.3
COURTNEY MINE
SUPPLY YARD
MINGO PORTAL
THOMAS
KERR
BECK
BRYANT
MAPLE CREEK MINE
MONONGAHELA RIVER