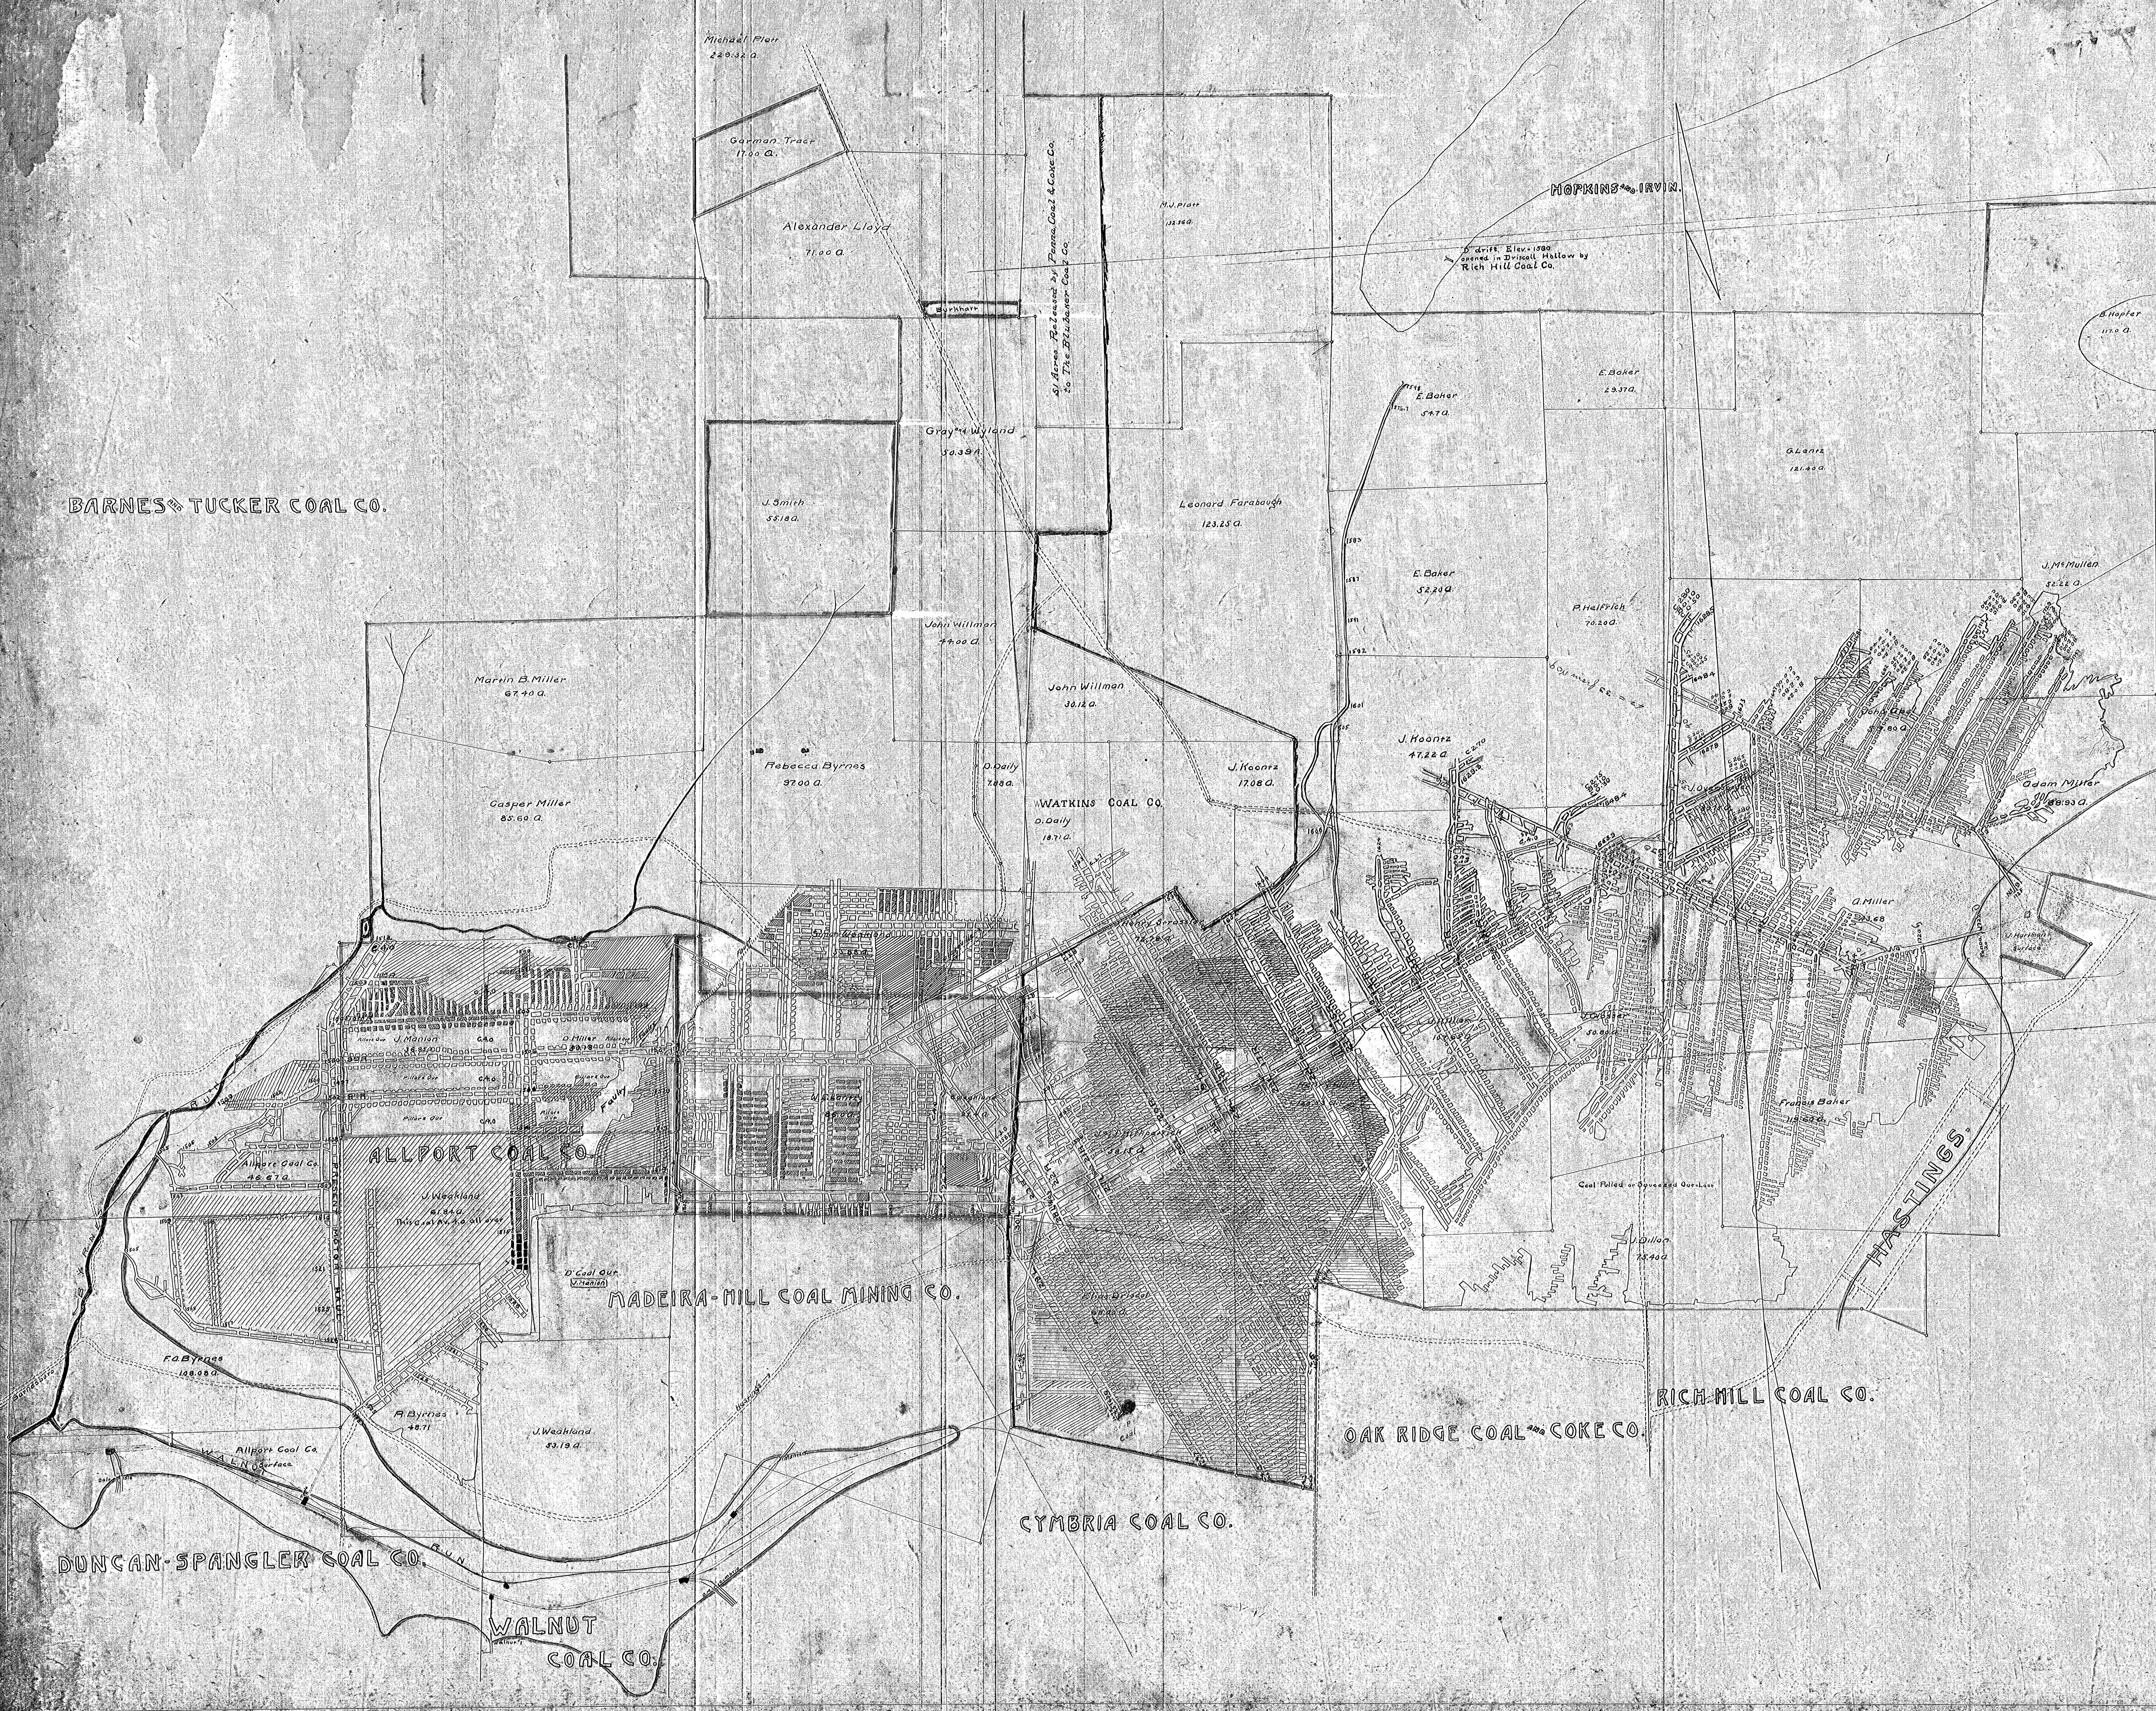

MAP
showing
MINE WORK'S
of
Penna. 20 and Allport
on
BLUBAKER LANDS

2-1-1908 -Slick- 1" = 400'

Blubaker showmin
Hast. and Span. "