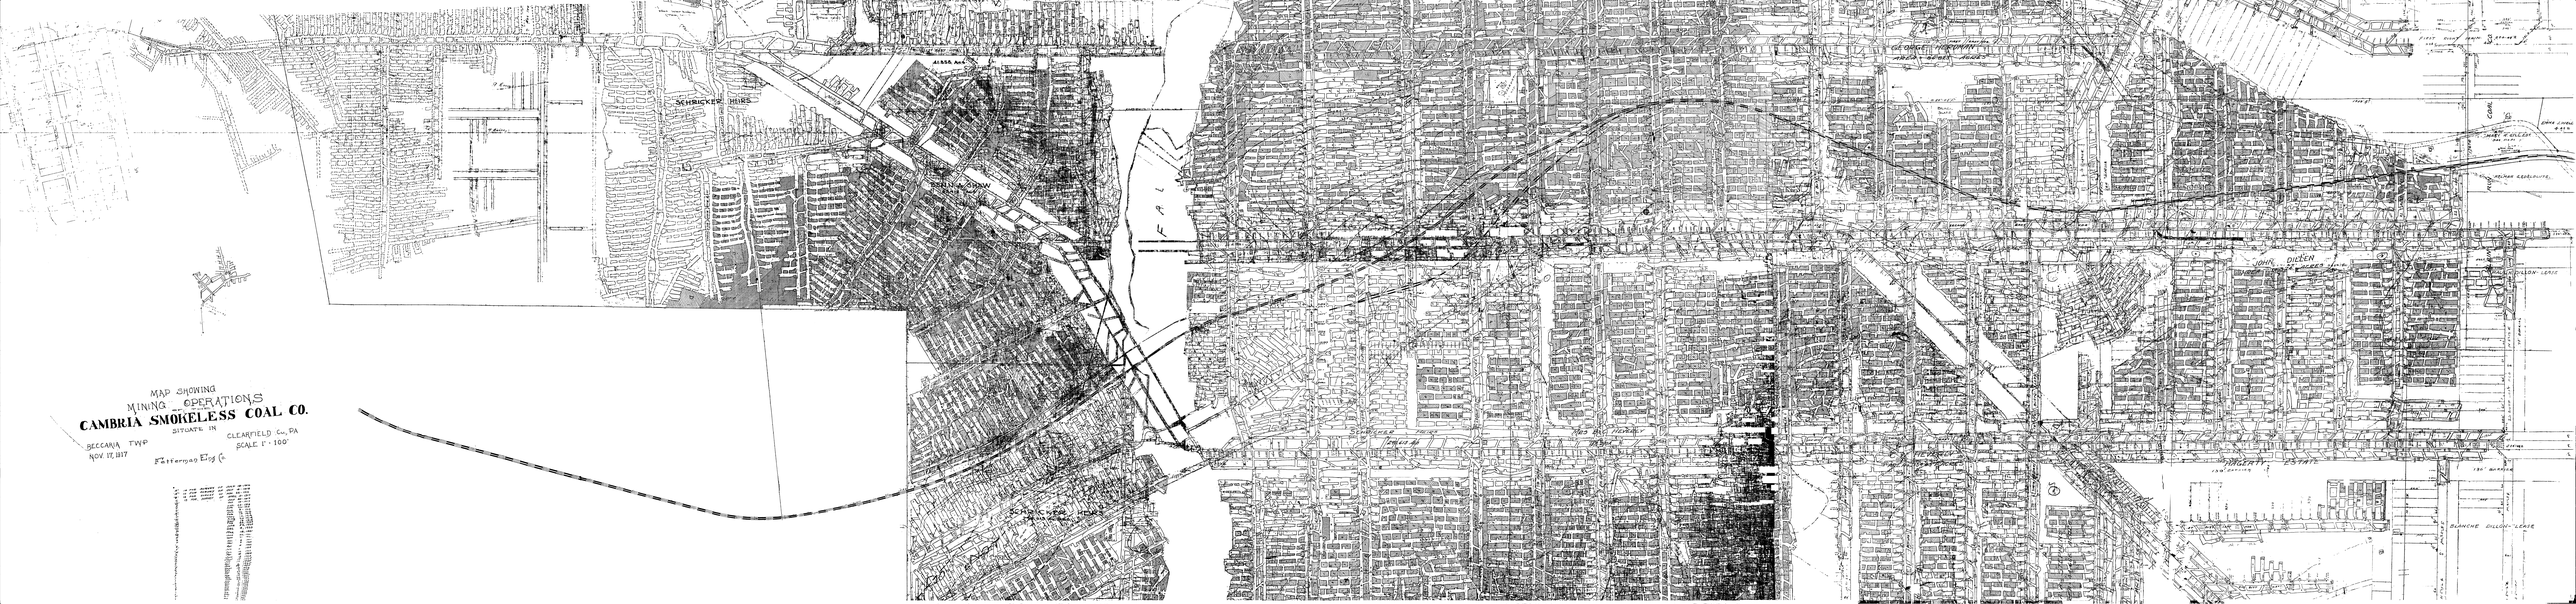

MAP SHOWING
MINING OPERATIONS
CAMBRIA SMOKELESS COAL CO.
BECCARIA TWP
SITUATE IN
CLEARFIELD Co., PA
NOV. 17, 1917
Patterson Eng Co
SCALE 1" = 100'
SCHRICKER HEIRS
ALISS Adv.
FAIL
GEORGE HOFFMAN
JOHN DIETEN
WILLEY ESTATE
BLANCHE GILLON-LEACH